


0376-391

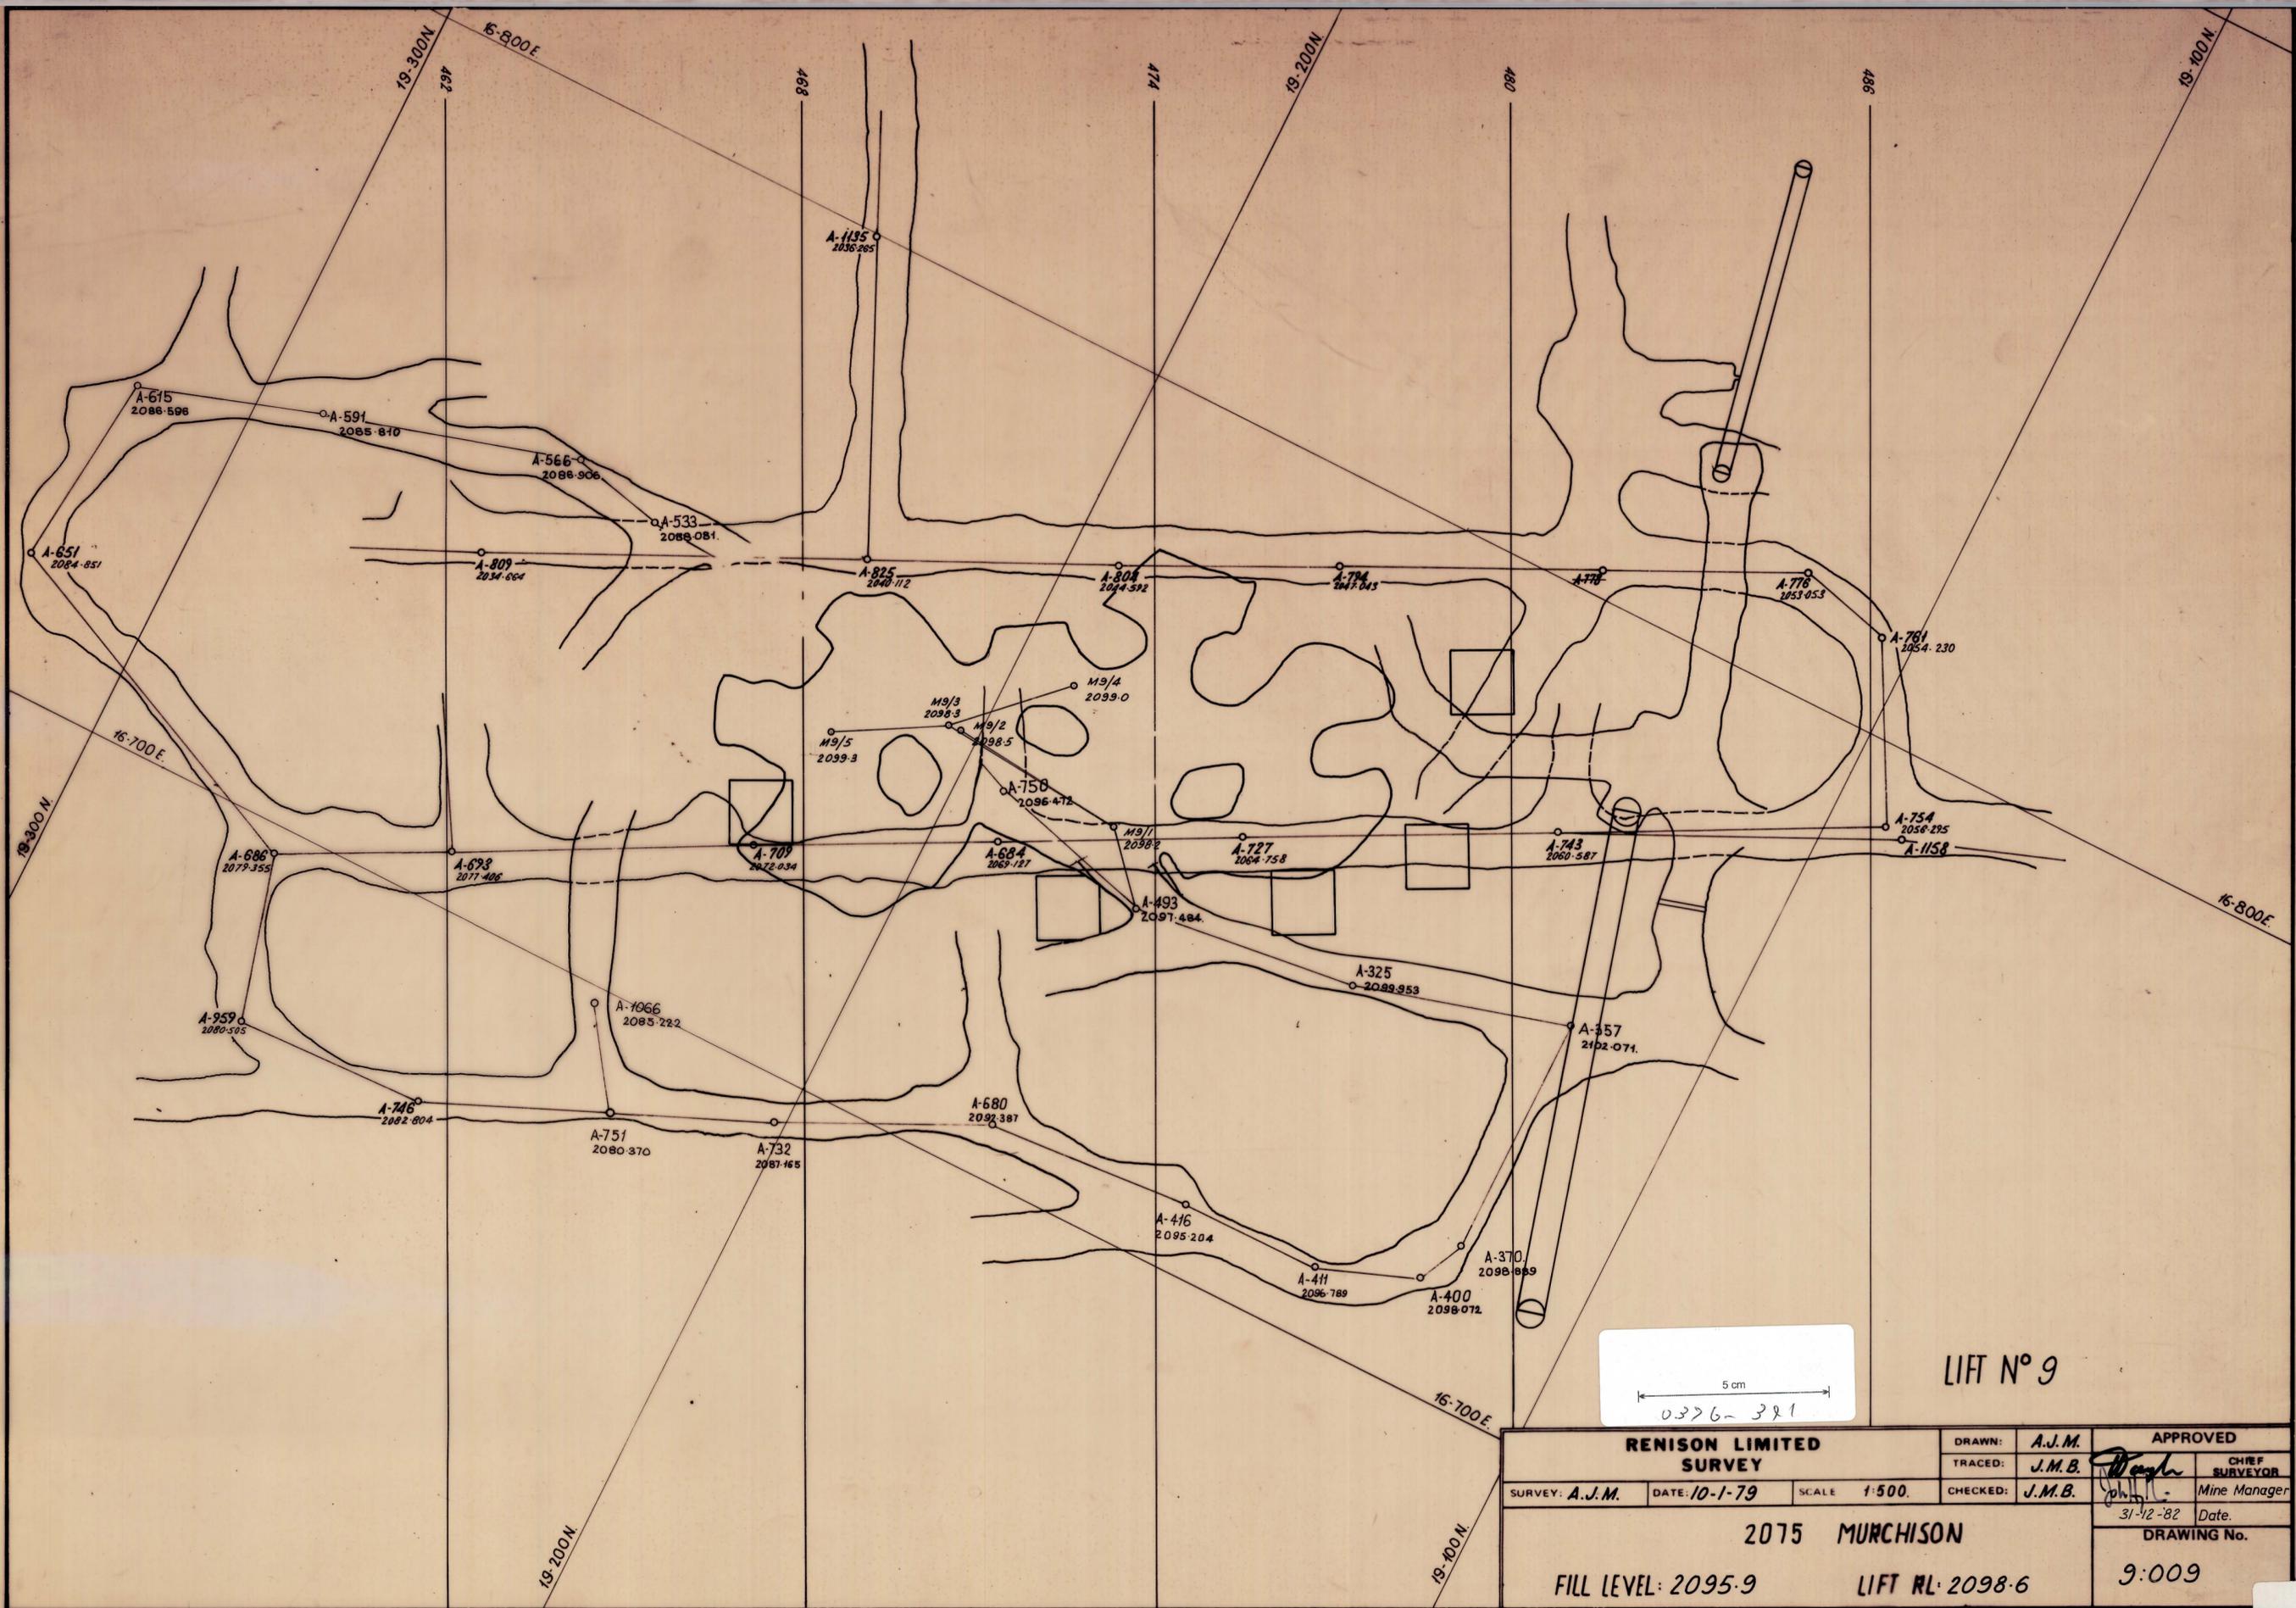

5 cm
0376-391

LIFT N° 9

RENISON LIMITED SURVEY			DRAWN: A.J.M.	APPROVED
			TRACED: J.M.B.	<i>[Signature]</i> CHIEF SURVEYOR
SURVEY: A.J.M.	DATE: 10-1-79	SCALE: 1:500	CHECKED: J.M.B.	Mine Manager
2075 MURCHISON				Date: 31-12-82
FILL LEVEL: 2095.9 LIFT RL: 2098.6				DRAWING No. 9:009

83154