


0376-394

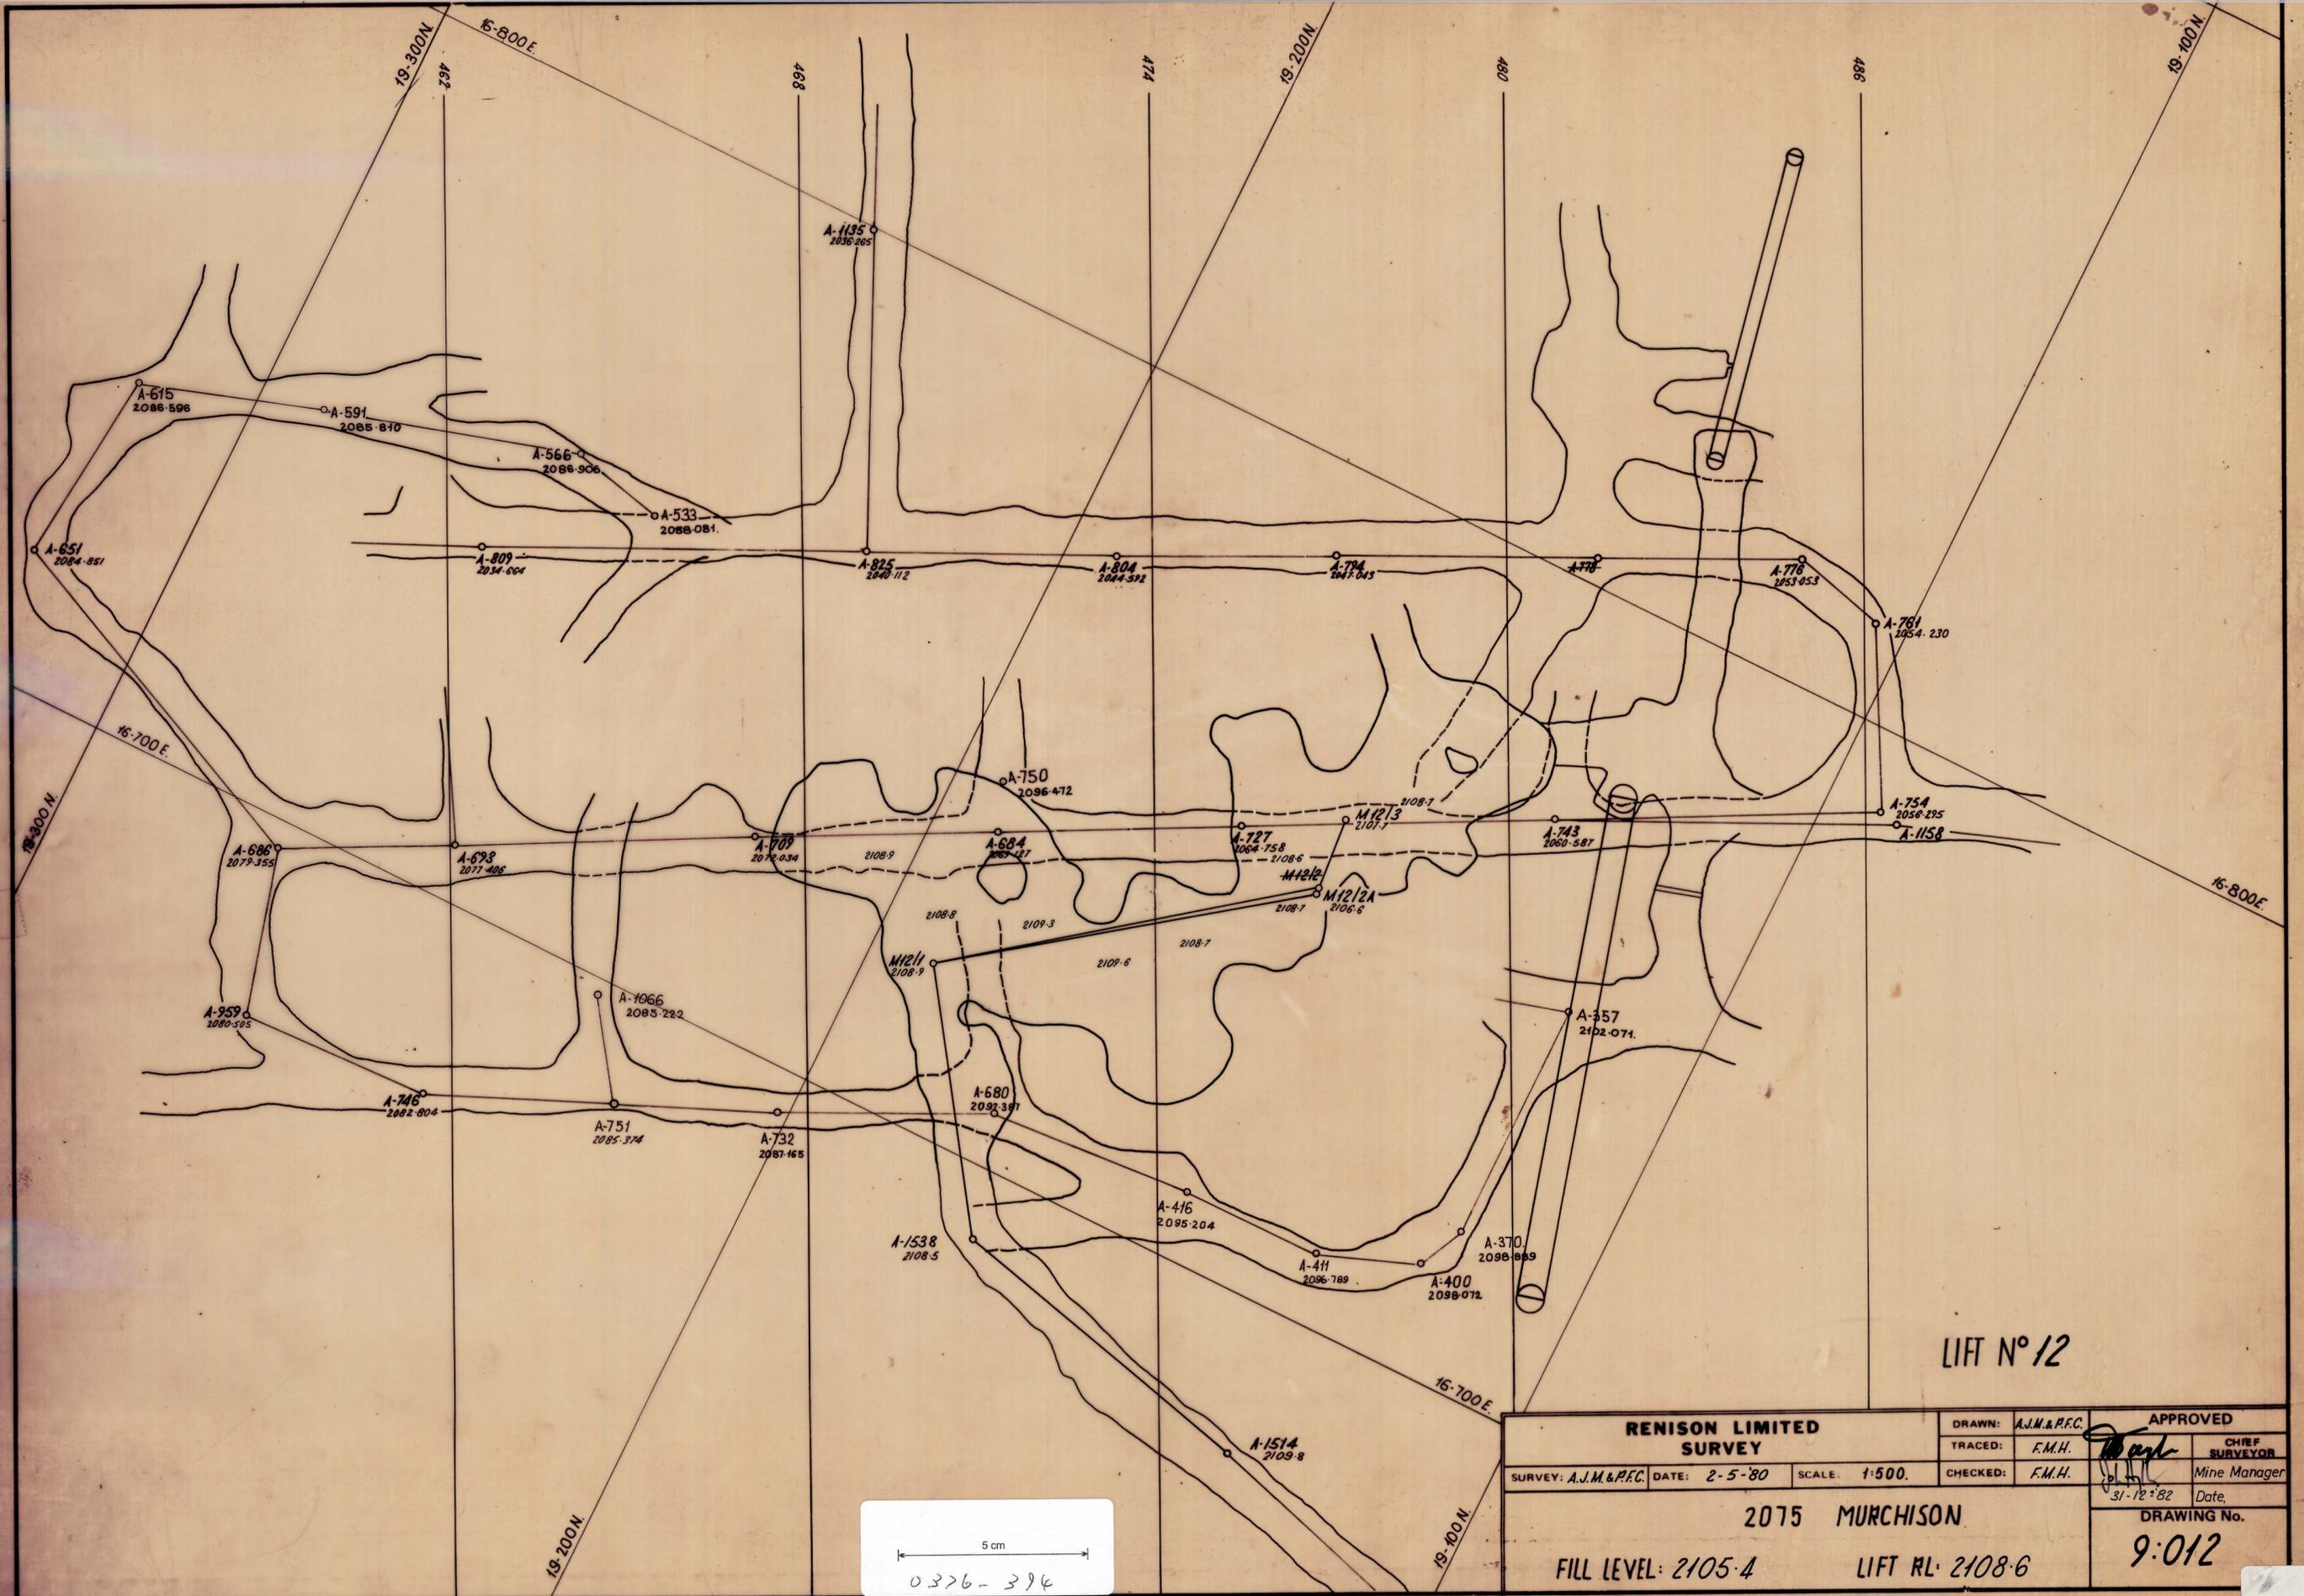

LIFT N° 12

RENISON LIMITED SURVEY SURVEY: A.J.M.&P.F.C. DATE: 2-5-80 SCALE: 1:500.			DRAWN: A.J.M.&P.F.C. TRACED: F.M.H. CHECKED: F.M.H.	APPROVED CHIEF SURVEYOR Mine Manager
			2075 MURCHISON FILL LEVEL: 2105.4 LIFT RL: 2108.6	

5 cm
 0376-394

83157