


LIFT N° 1&2.
 AVERAGE BACK RL: 2021-8.
 AREA: 945m²

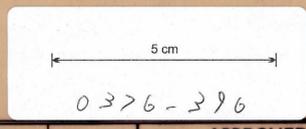

RENISON LIMITED SURVEY SURVEY: R.N.D. DATE: 2-10-77 SCALE: 1:500			DRAWN: R.N.D. TRACED: F.M.H.	APPROVED CHIEF SURVEYOR Mine Manager
			CHECKED: F.M.H.	Date: 31-12-82
2025 MURCHISON FILL LEVEL: 2018-1. LIFT RL: 2023-1		DRAWING No. 94:001.		