
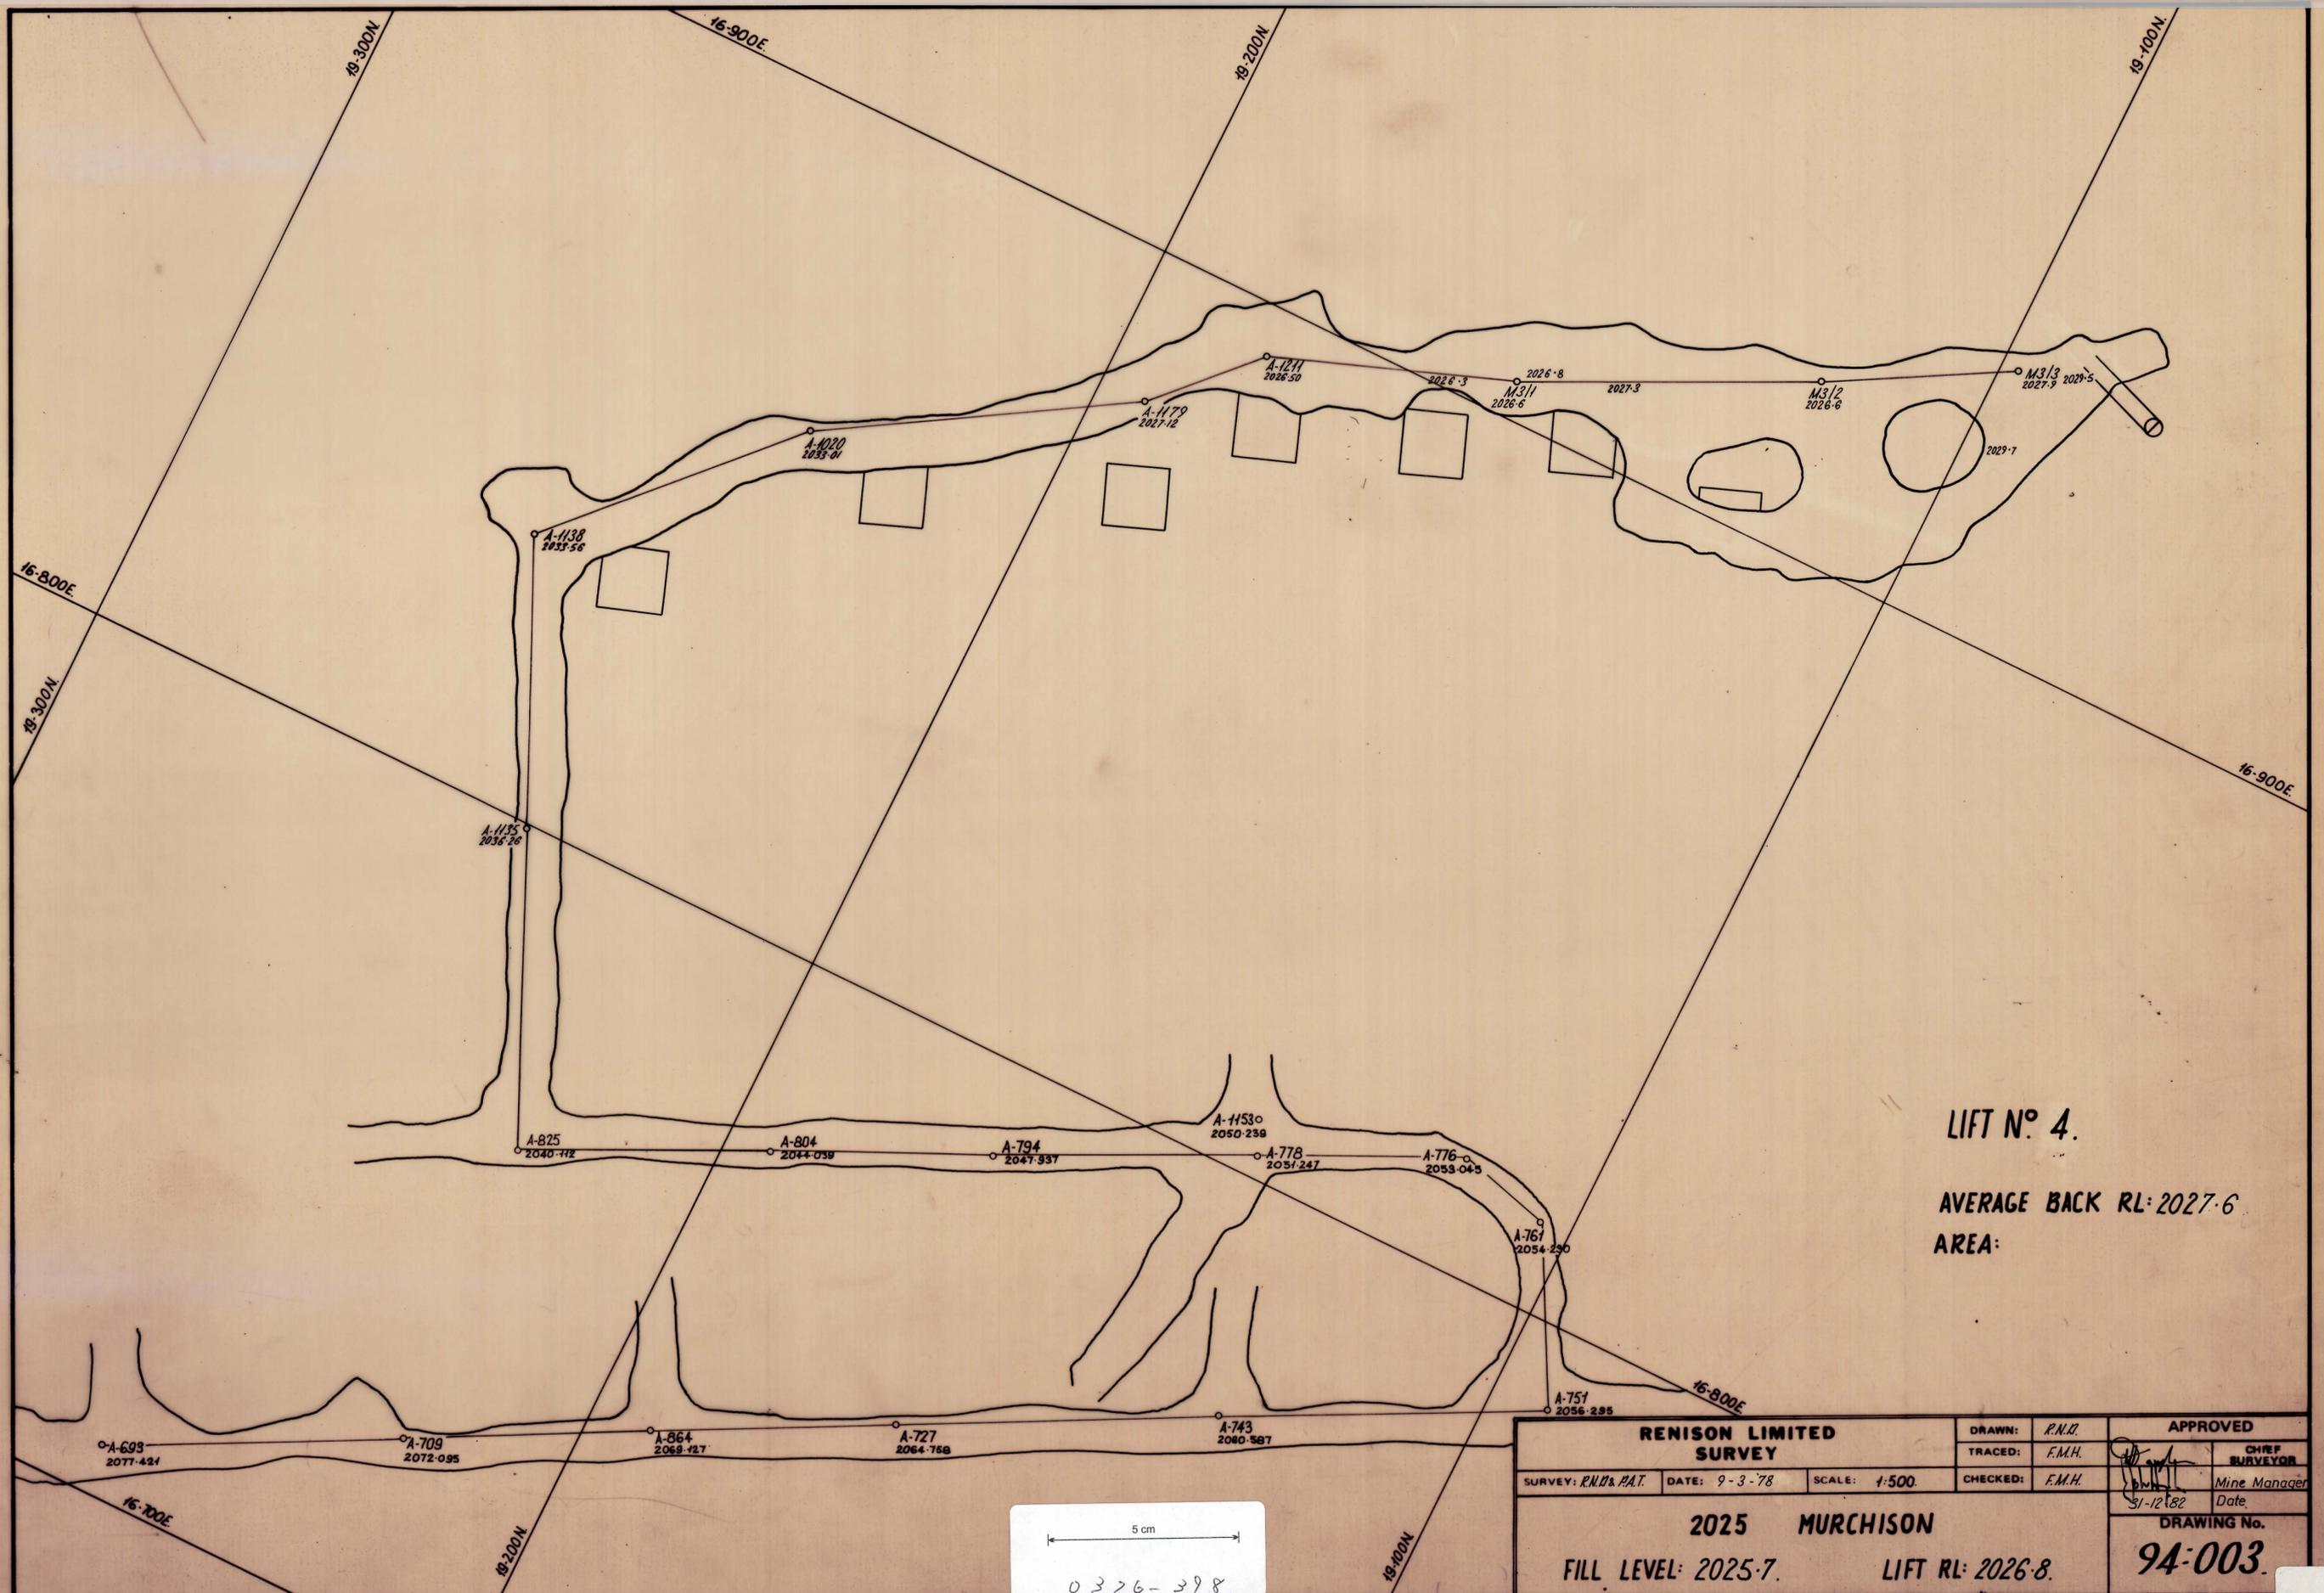


0376-398

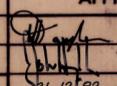

LIFT N° 4.
 AVERAGE BACK RL: 2027.6
 AREA:

RENISON LIMITED SURVEY			DRAWN: R.N.D.	APPROVED	
			TRACED: F.M.H.	CHIEF SURVEYOR	
SURVEY: R.N.D. & P.A.T.	DATE: 9-3-78	SCALE: 1:500	CHECKED: F.M.H.	 Mine Manager Date: 31-12-82	
2025 MURCHISON FILL LEVEL: 2025.7. LIFT RL: 2026.8.			DRAWING No. 94:003		

5 cm
 0376-398

83161