



0376-399

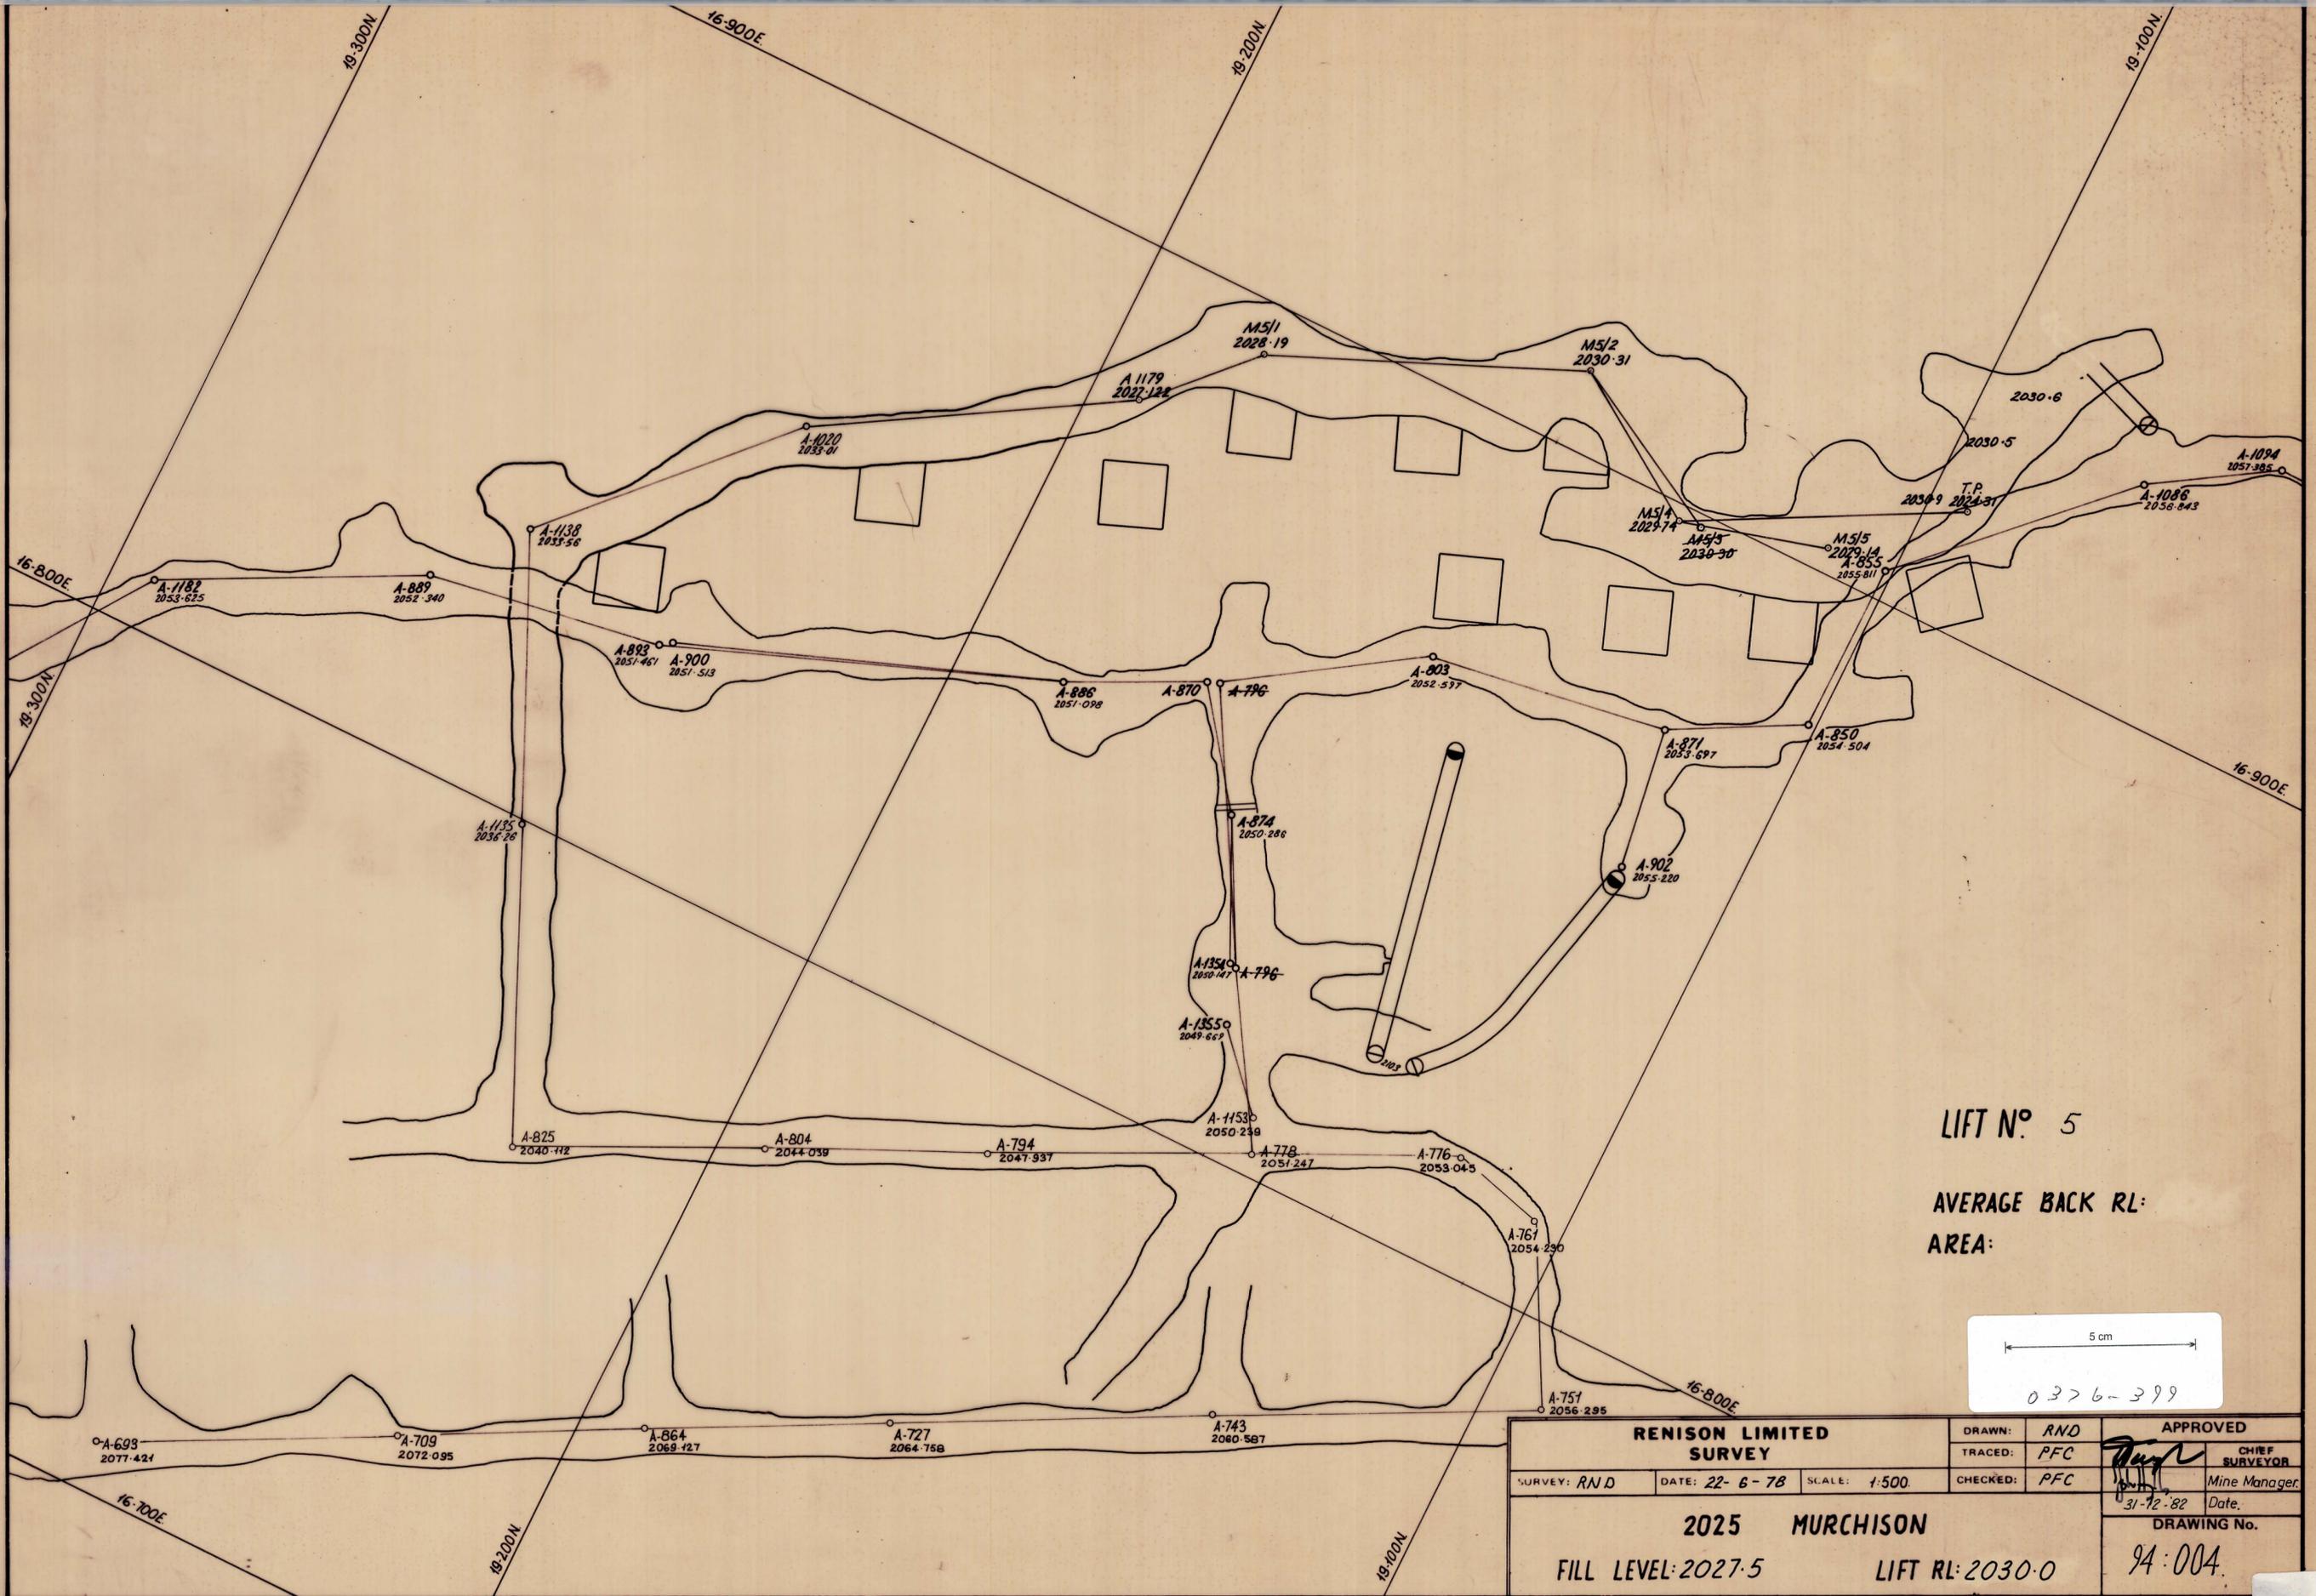

LIFT N° 5
 AVERAGE BACK RL:
 AREA:

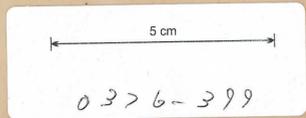

RENISON LIMITED SURVEY			DRAWN: RND	APPROVED <i>[Signature]</i> CHIEF SURVEYOR
			TRACED: PFC	
SURVEY: RND	DATE: 22-6-78	SCALE: 1:500	CHECKED: PFC	Date: 31-12-82
2025 MURCHISON			DRAWING No.	
FILL LEVEL: 2027.5			LIFT RL: 2030.0	
			94:004	

83162