


LIFT N^o 7
 AVERAGE BACK RL: 2034.8
 AREA:

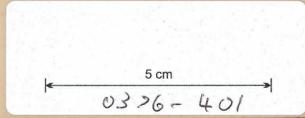

RENISON LIMITED SURVEY			DRAWN: A.J.M.	APPROVED
			TRACED: A.J.M.	CHIEF SURVEYOR
SURVEY: A.J.M.	DATE: 31-10-79	SCALE: 1:500	CHECKED: F.M.H.	Mine Manager
2025 MURCHISON				31-12-82 Date
FILL LEVEL: 2032?				DRAWING No. 94:006
LIFT RL: 2034.8				