


LIFT N° 8
 AVERAGE BACK RL:
 AREA:

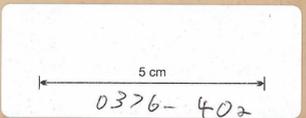

RENISON LIMITED SURVEY SURVEY: A.J.M.-P.F.C. DATE: 12-11-80 SCALE: 1:500			DRAWN: P.F.C. TRACED: J.B.	APPROVED
			CHECKED: P.F.C.	Mine Manager Date: 31/12-82
2025 MURCHISON FILL LEVEL: 2035.7 LIFT RL: 2039.4			DRAWING No. 94:007	