


0376-411

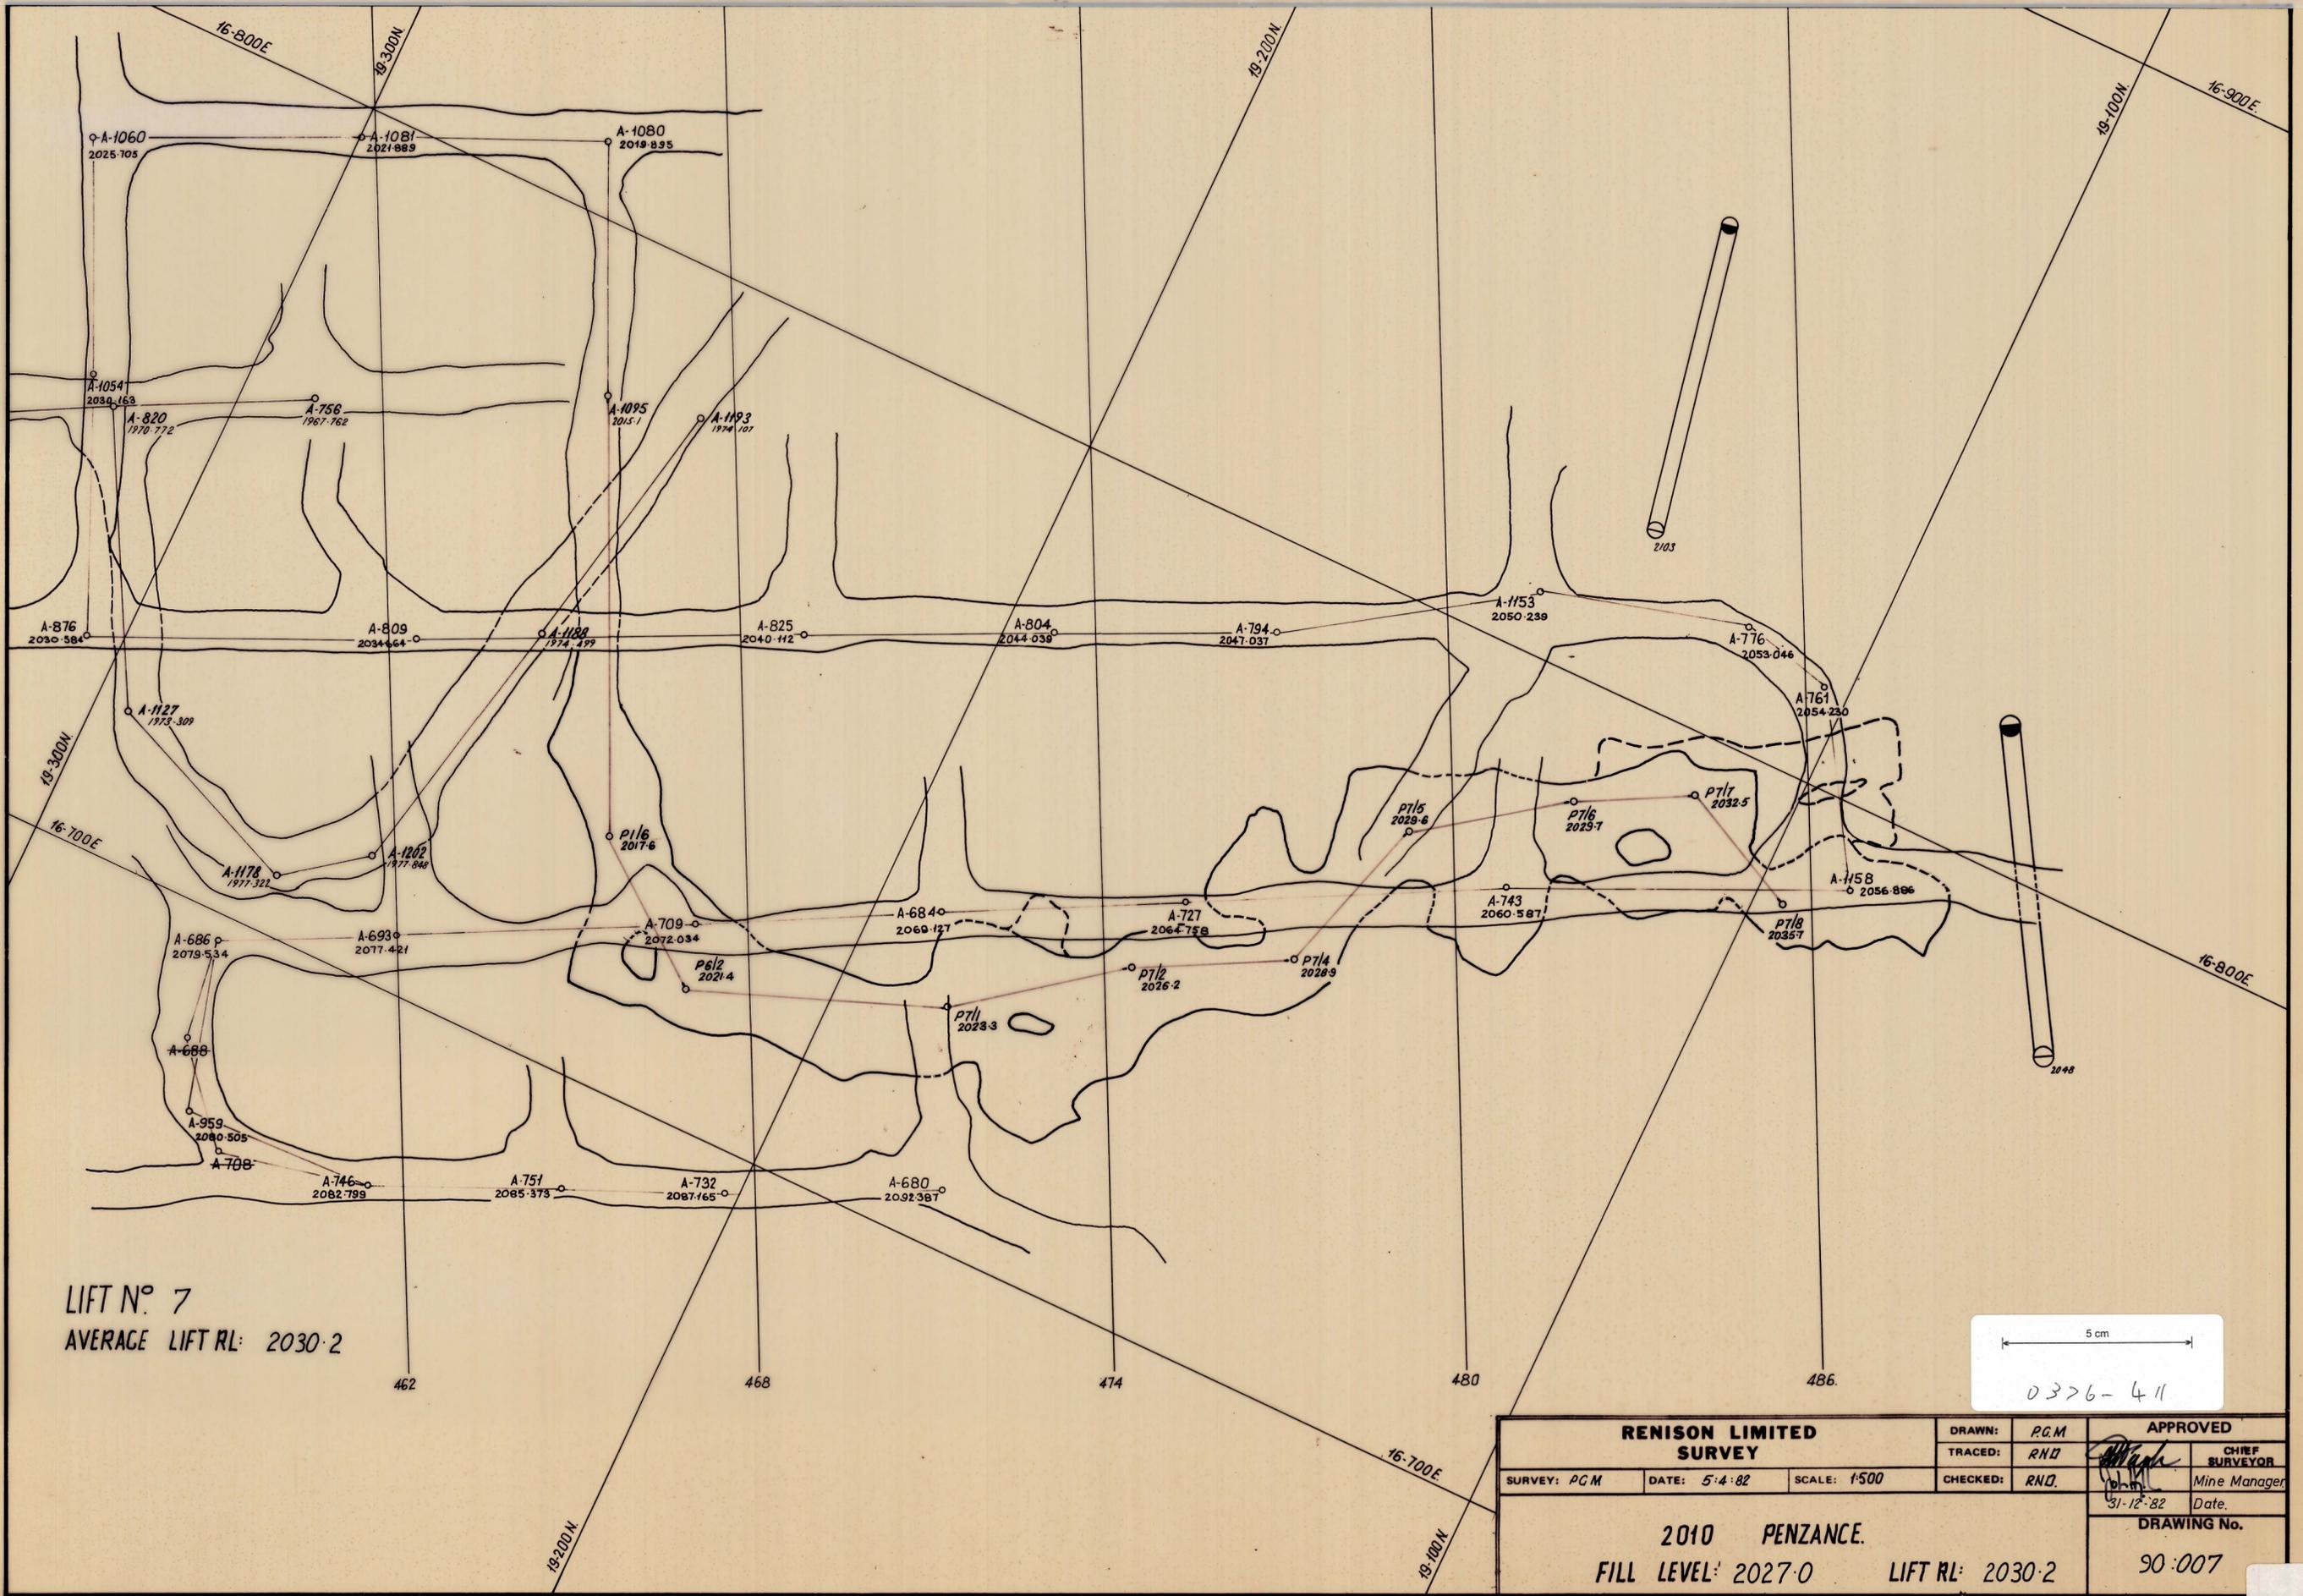

LIFT N<sup>o</sup> 7  
 AVERAGE LIFT RL: 2030.2

5 cm  
 0376-411

<b>RENISON LIMITED SURVEY</b> SURVEY: PCM    DATE: 5.4.82    SCALE: 1:500			DRAWN: PCM TRACED: RND CHECKED: RND	APPROVED  CHIEF SURVEYOR Mine Manager
			2010 PENZANCE. FILL LEVEL: 2027.0    LIFT RL: 2030.2	

83174