


0376-413

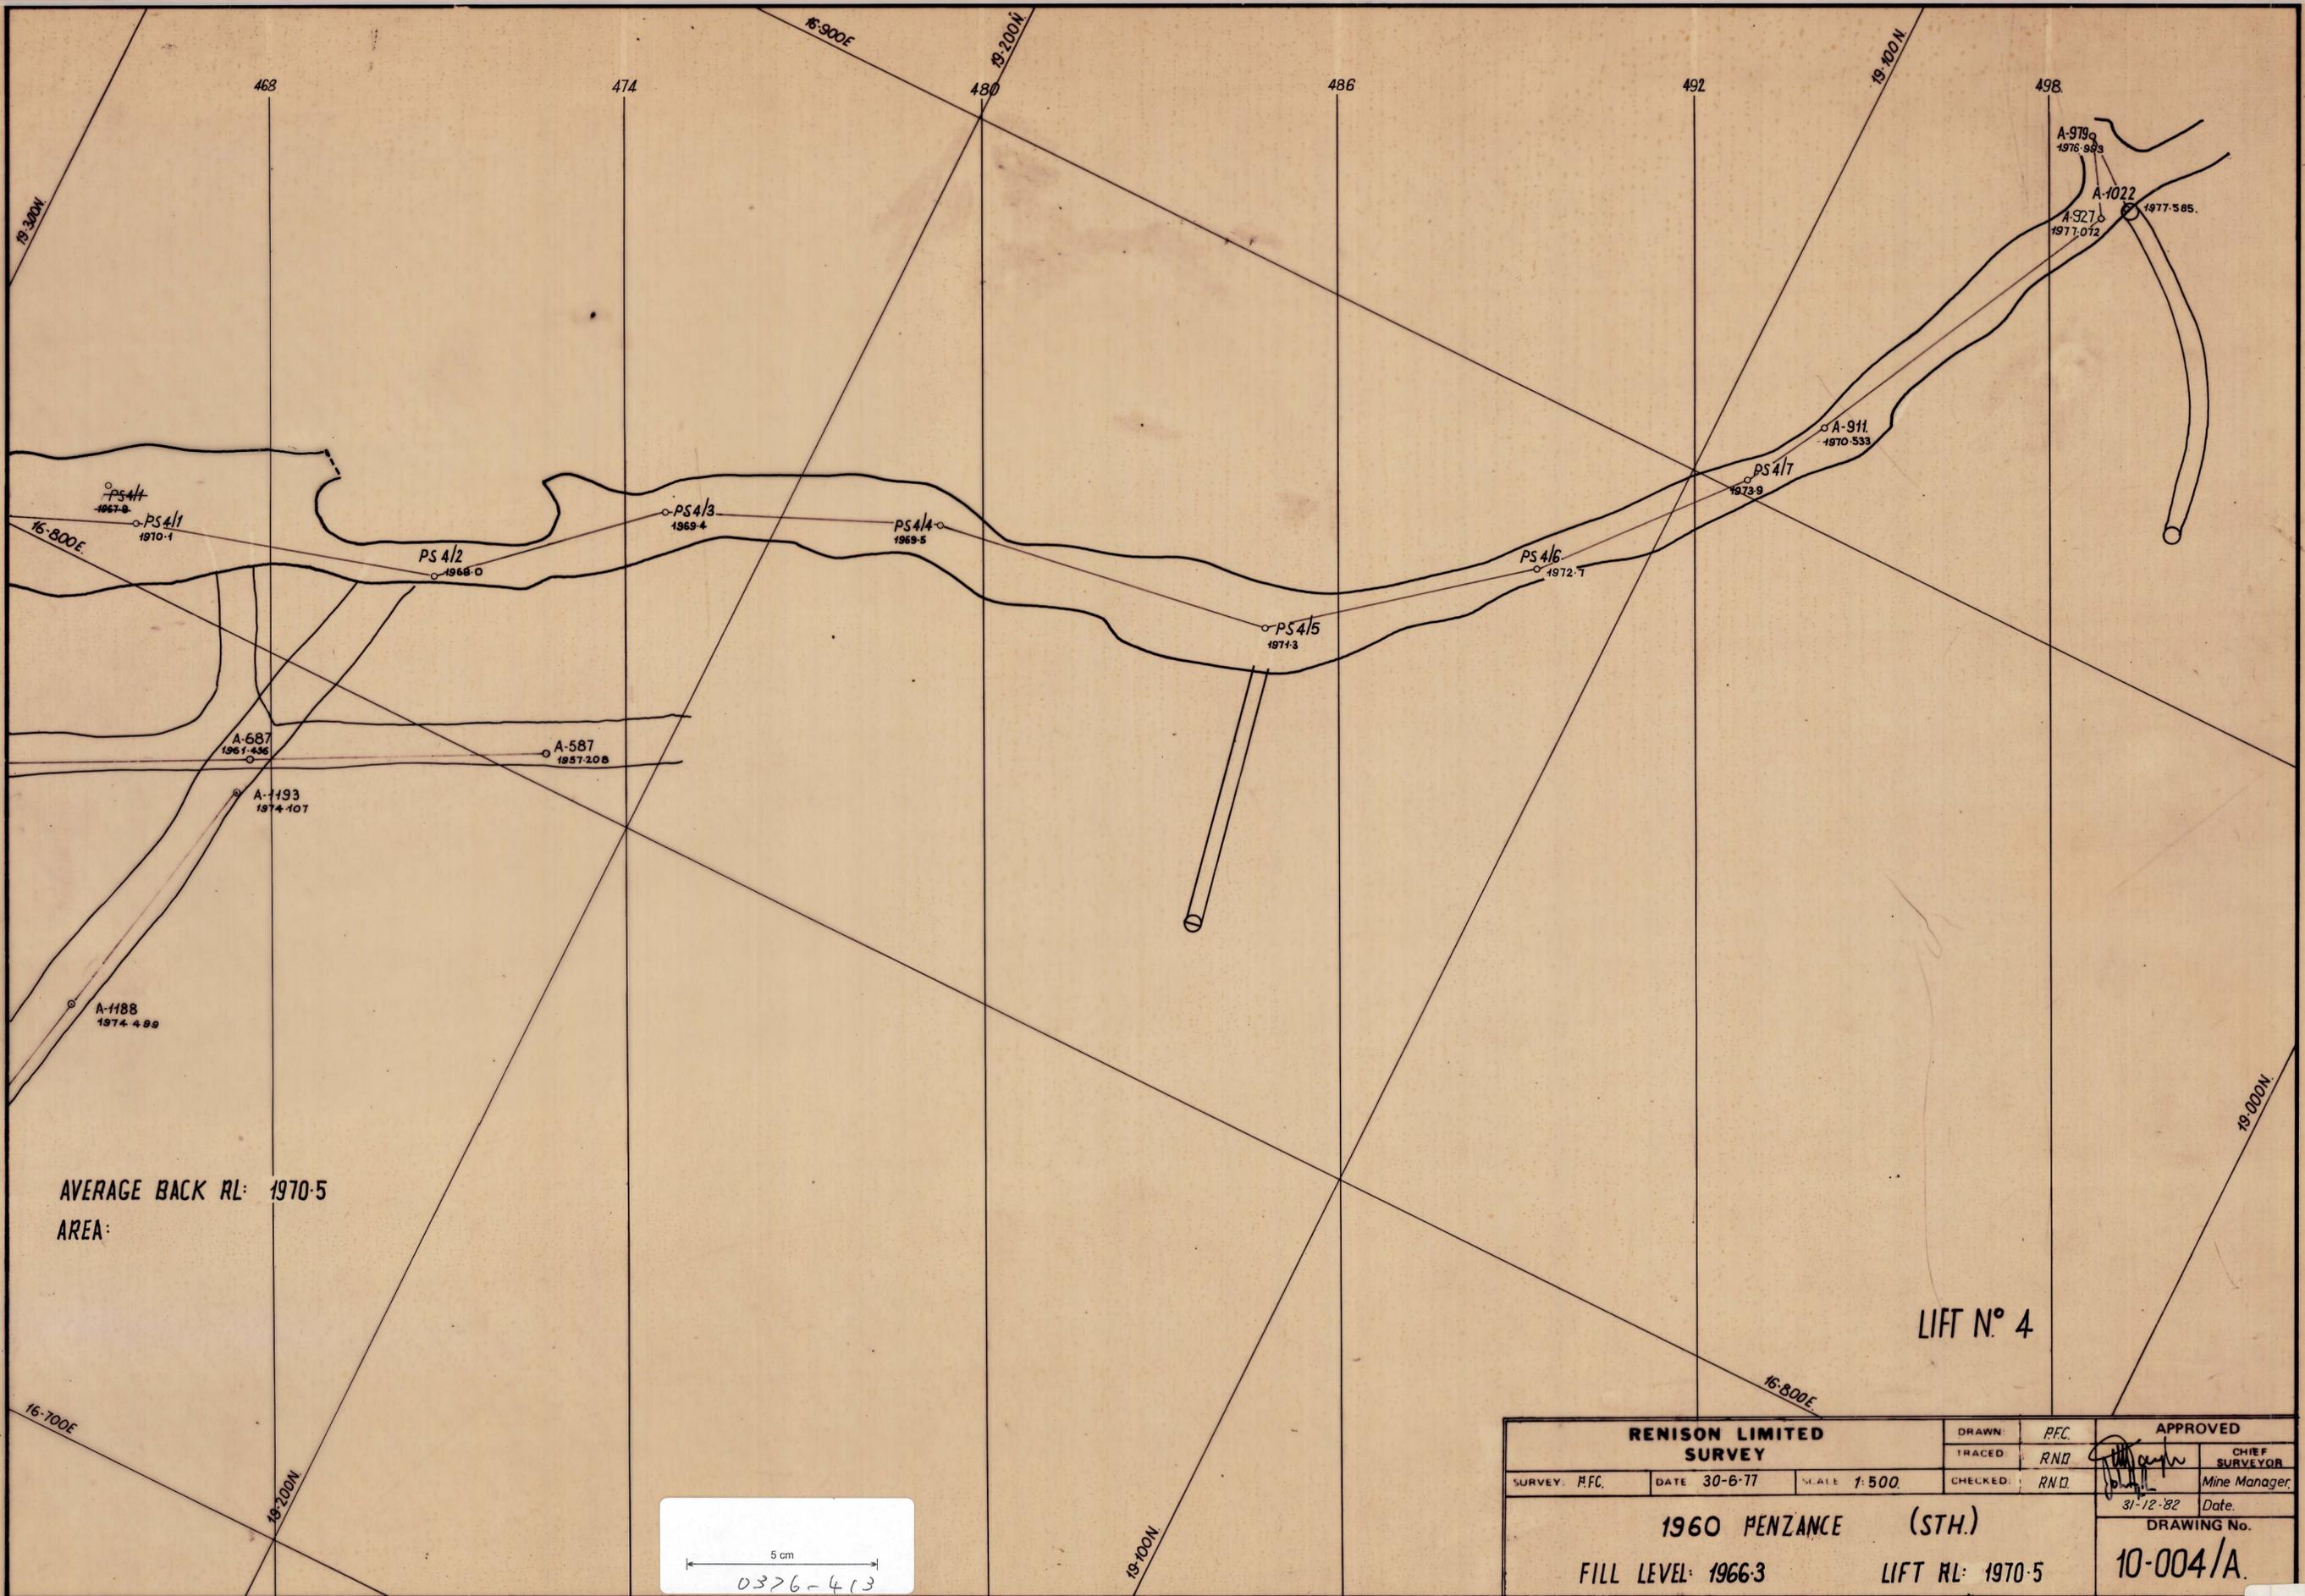

AVERAGE BACK RL: 1970.5
AREA:

LIFT N° 4

5 cm
0376-413

RENISON LIMITED SURVEY			DRAWN: R.F.C.	APPROVED
			TRACED: R.N.D.	CHIEF SURVEYOR
SURVEY: R.F.C.	DATE: 30-6-77	SCALE: 1:500	CHECKED: R.N.D.	Mine Manager
1960 PENZANCE (STH.)			31-12-82	Date
FILL LEVEL: 1966.3			DRAWING No.	
LIFT RL: 1970.5			10-004/A	

83179