


AVERAGE BACK RL: 1973-2
AREA:

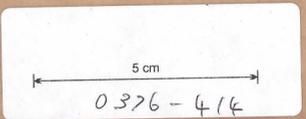

RENISON LIMITED SURVEY SURVEY: A.J.M. P.F.C. DATE: 7-7-77 SCALE: 1:500				DRAWN: A.J.M. TRACED: R.N.H.	APPROVED CHIEF SURVEYOR: <i>[Signature]</i>	
				CHECKED: R.N.H.	Date: 31-12-82 Mine Manager: <i>[Signature]</i>	
1960 PENZANCE (NTH) FILL LEVEL: 1971-6 LIFT RL: 1973-4				DRAWING No. 10-004/H		