


AVERAGE BACK PL. 1982-6  
AREA.

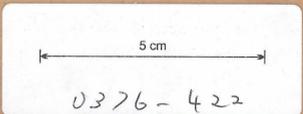

<b>RENISON LIMITED SURVEY</b>			DRAWN <b>A.J.M.</b>	APPROVED <i>[Signature]</i> <b>CHIEF SURVEYOR</b>
SURVEY <b>A.J.M.</b>	DATE <b>29-5-80</b>	SCALE <b>1:500</b>	CHECKED <b>J.M.B.</b>	Mine Manager
<b>1960 PENZANCE (NTH.)</b>				Date <b>31-12-82</b>
<b>APPROX. FILL LEVEL: 1979.9 LIFT LEVEL: 1982.6</b>				DRAWING No. <b>10:008/B</b>