




0376-423

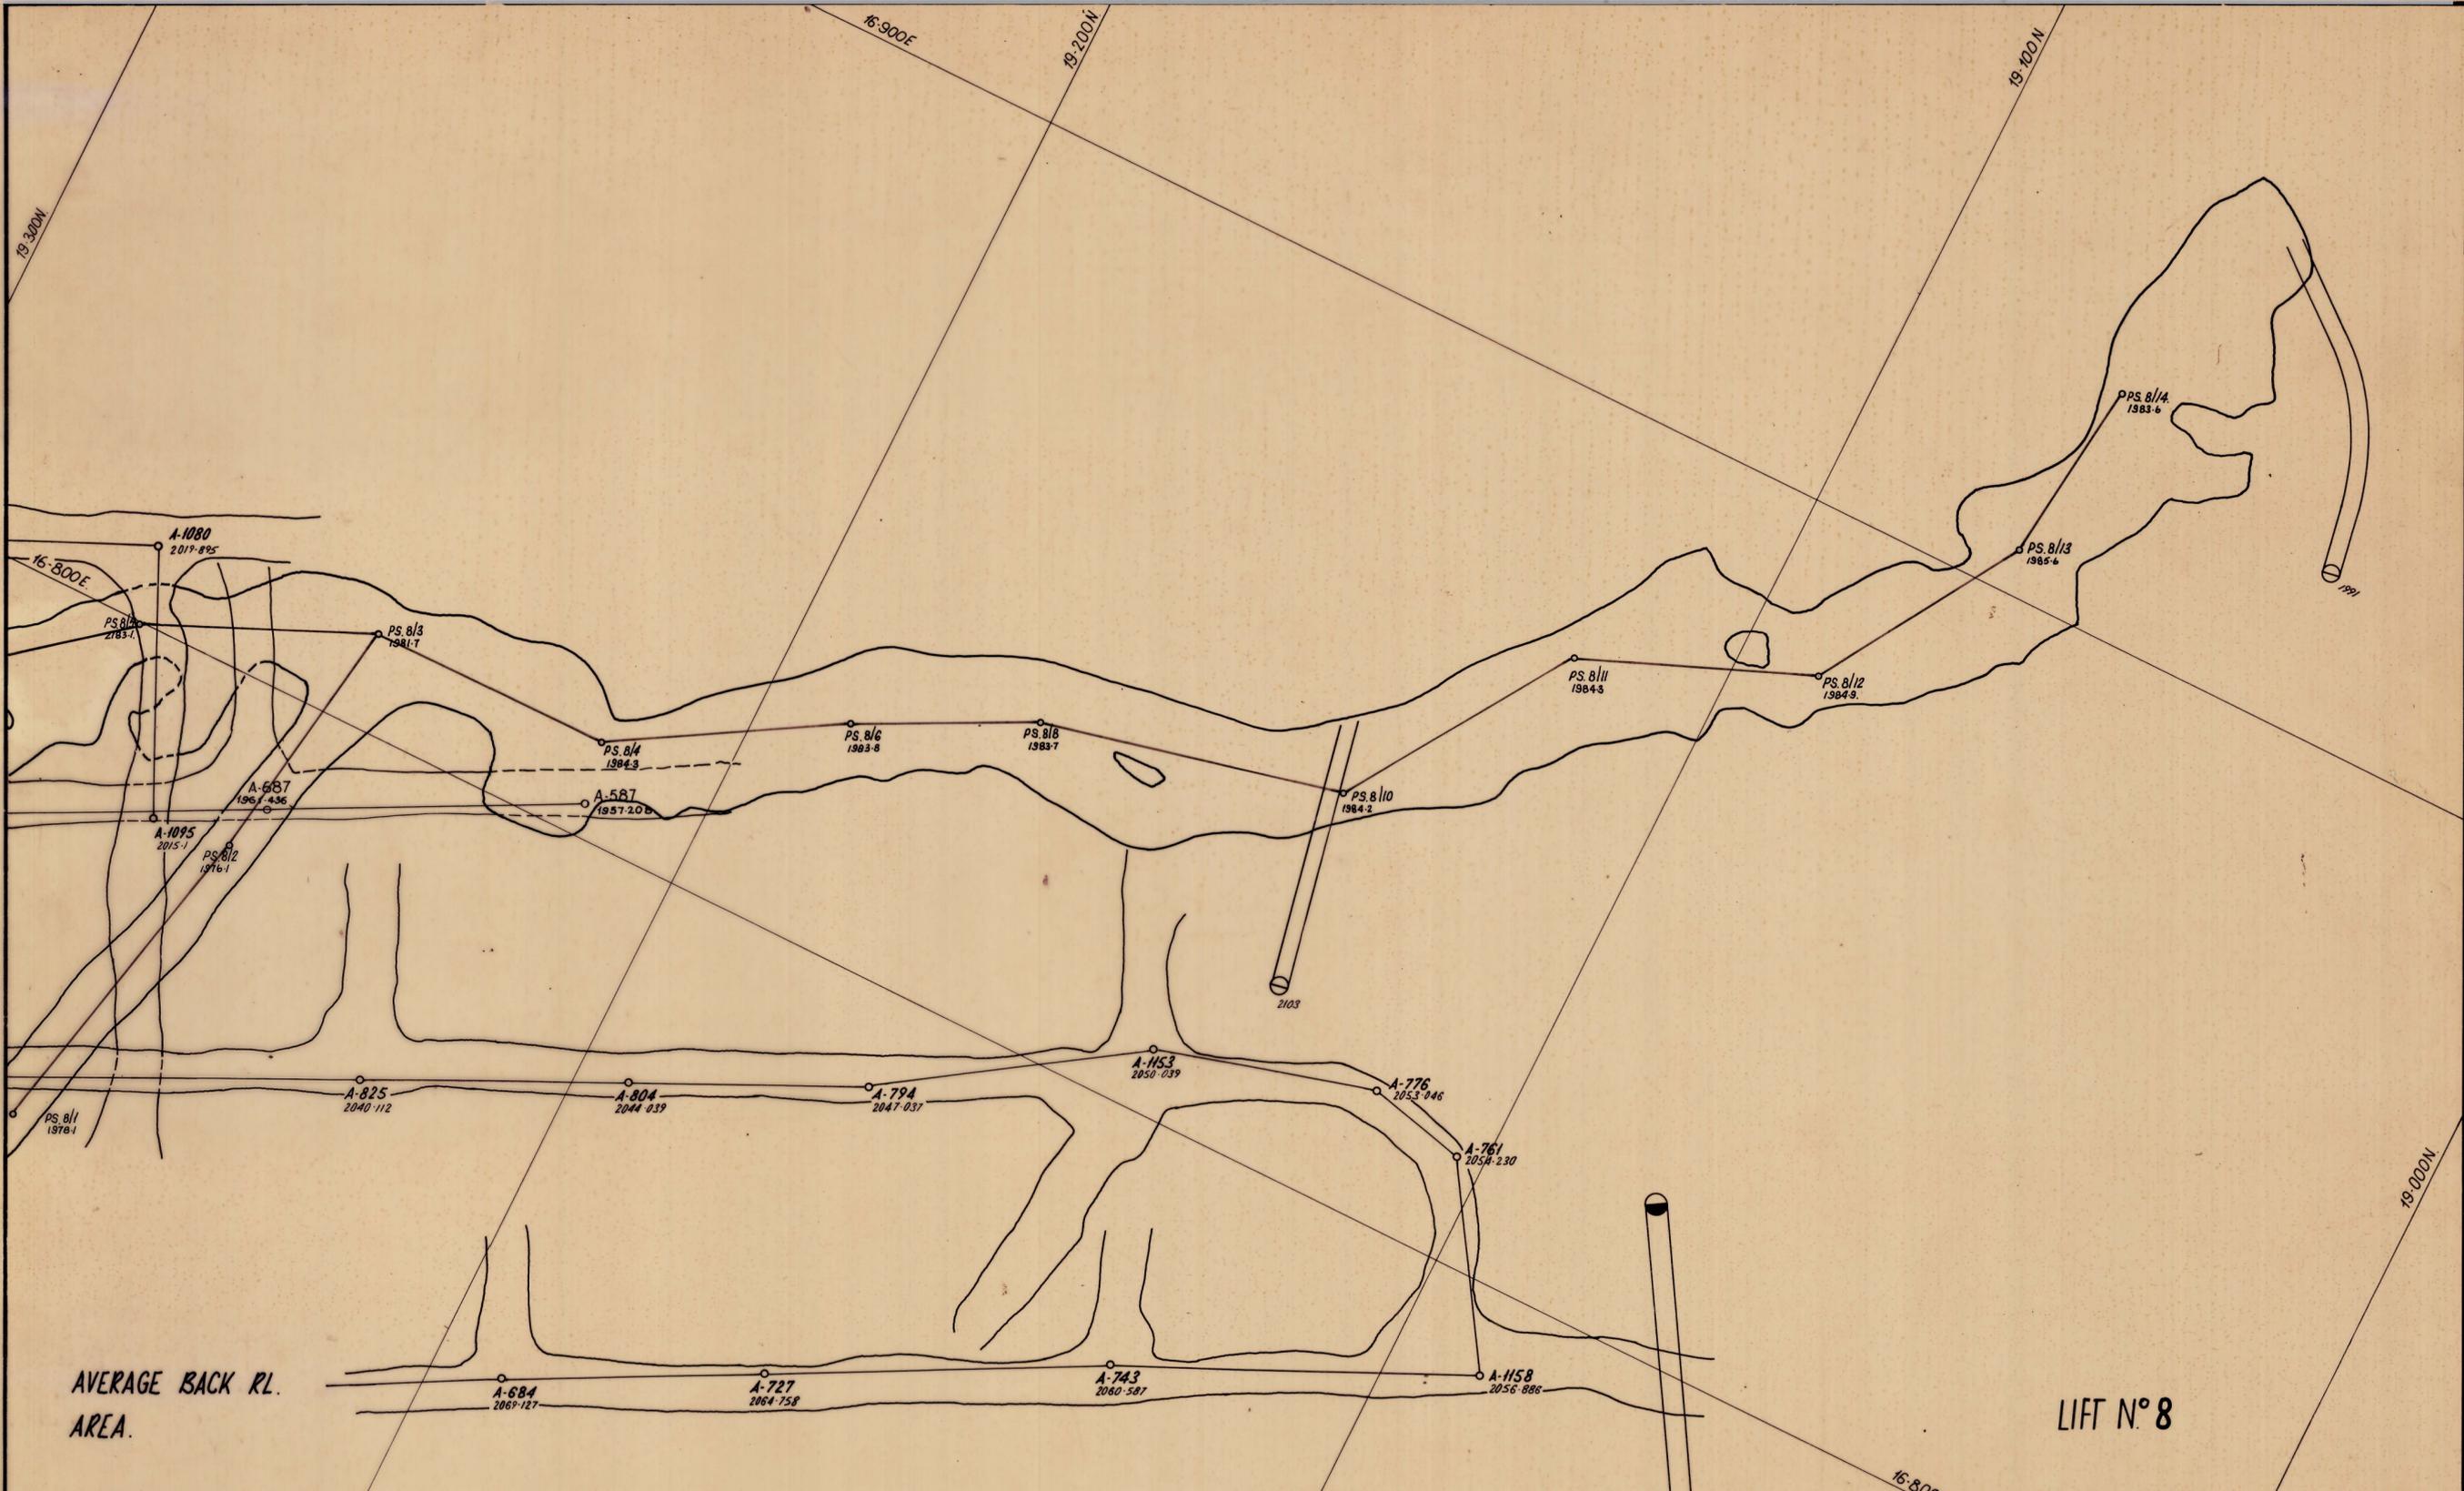

AVERAGE BACK RL.
AREA.

LIFT N° 8

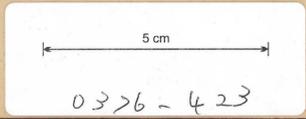

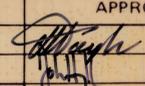RENISON LIMITED SURVEY			DRAWN	P.F.C.	 CHIEF SURVEYOR
			CHECKED	R.N.Q.	
SURVEY P.F.C.	DATE: 29.1.81	SCALE: 1:500	CHECKED	R.N.Q.	31-12-82 Date.
1960 PENZANCE (STH.) FILL LEVEL: 1980.8 LIFT LEVEL: 1984.0					DRAWING No. 10:0091A

83189