


0376-425

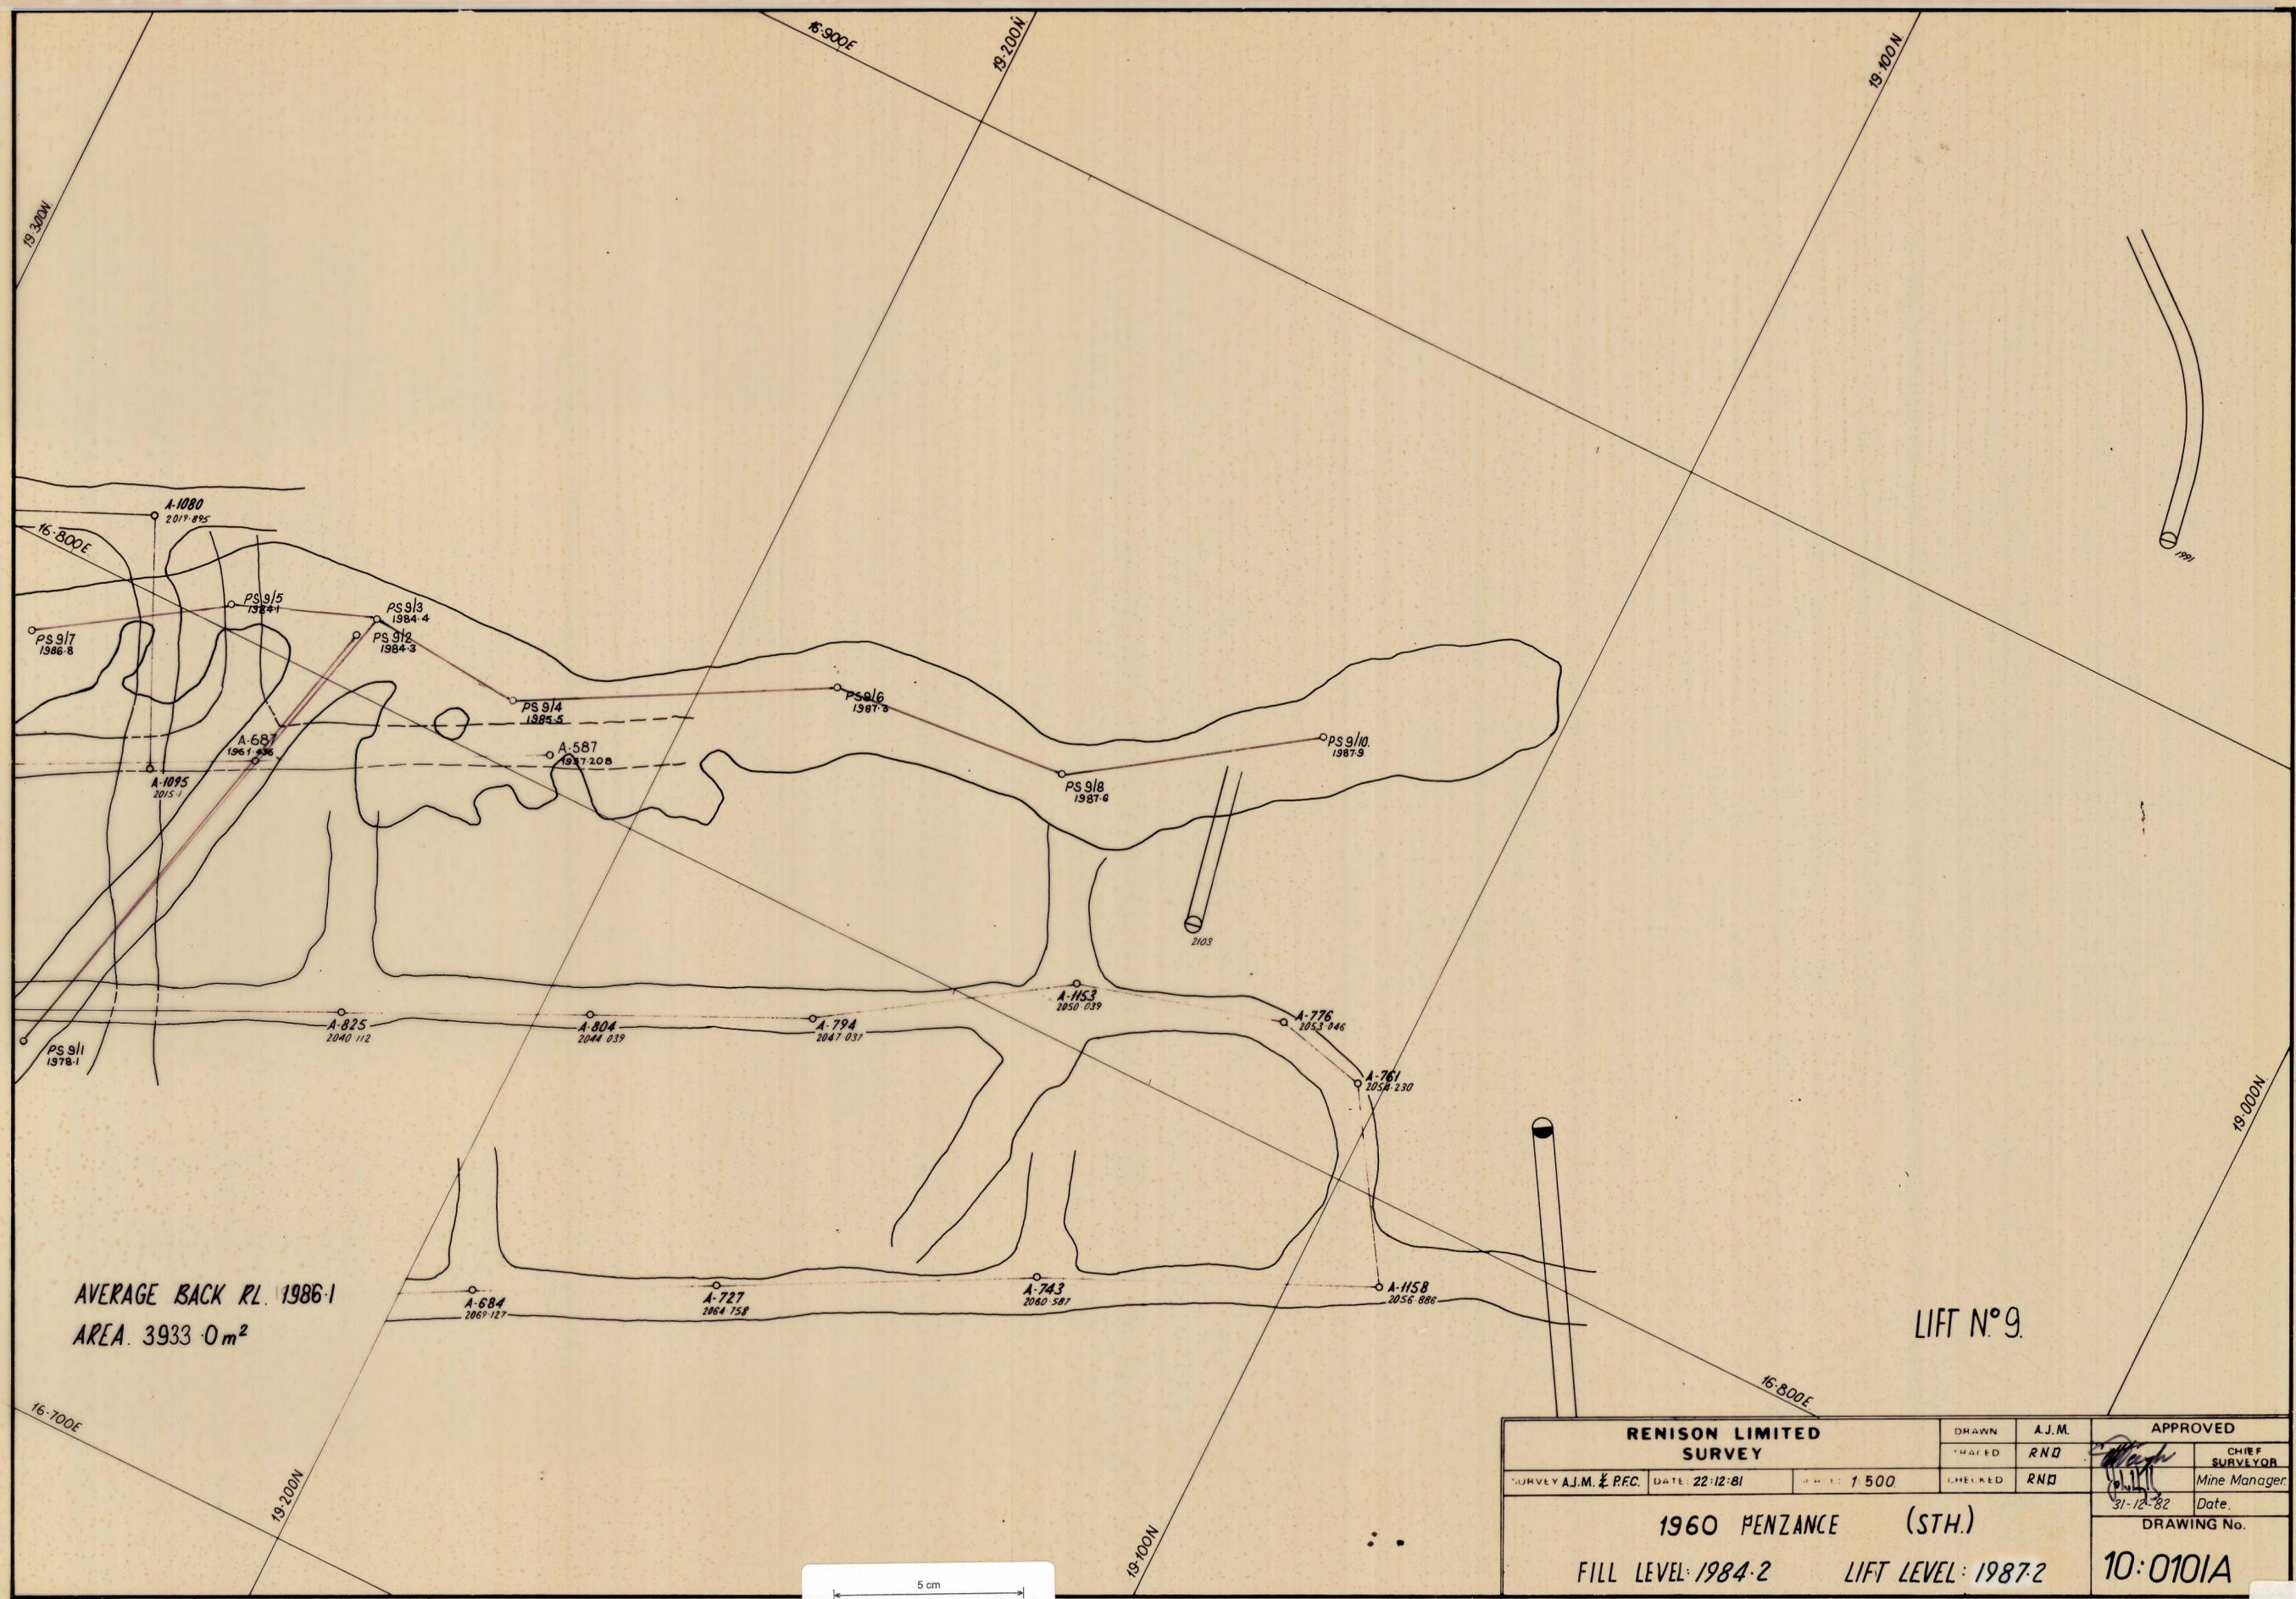

AVERAGE BACK RL 1986-1
 AREA. 3933.0m²

LIFT N°9.

RENISON LIMITED SURVEY <small>SURVEY A.J.M. & P.F.C. DATE: 22-12-81 SCALE: 1:500</small>		<small>DRAWN</small> <small>TRACED</small>	<small>A.J.M.</small> <small>RND</small>	<small>APPROVED</small> <small>CHIEF SURVEYOR</small>
		<small>CHECKED</small>	<small>RND</small>	<small>Mine Manager.</small> <small>Date.</small> <small>31-12-82</small>
1960 PENZANCE (STH.) FILL LEVEL: 1984.2 LIFT LEVEL: 1987.2			<small>DRAWING No.</small> 10:0101A	

5 cm
 0376-425

83191