


0376-426

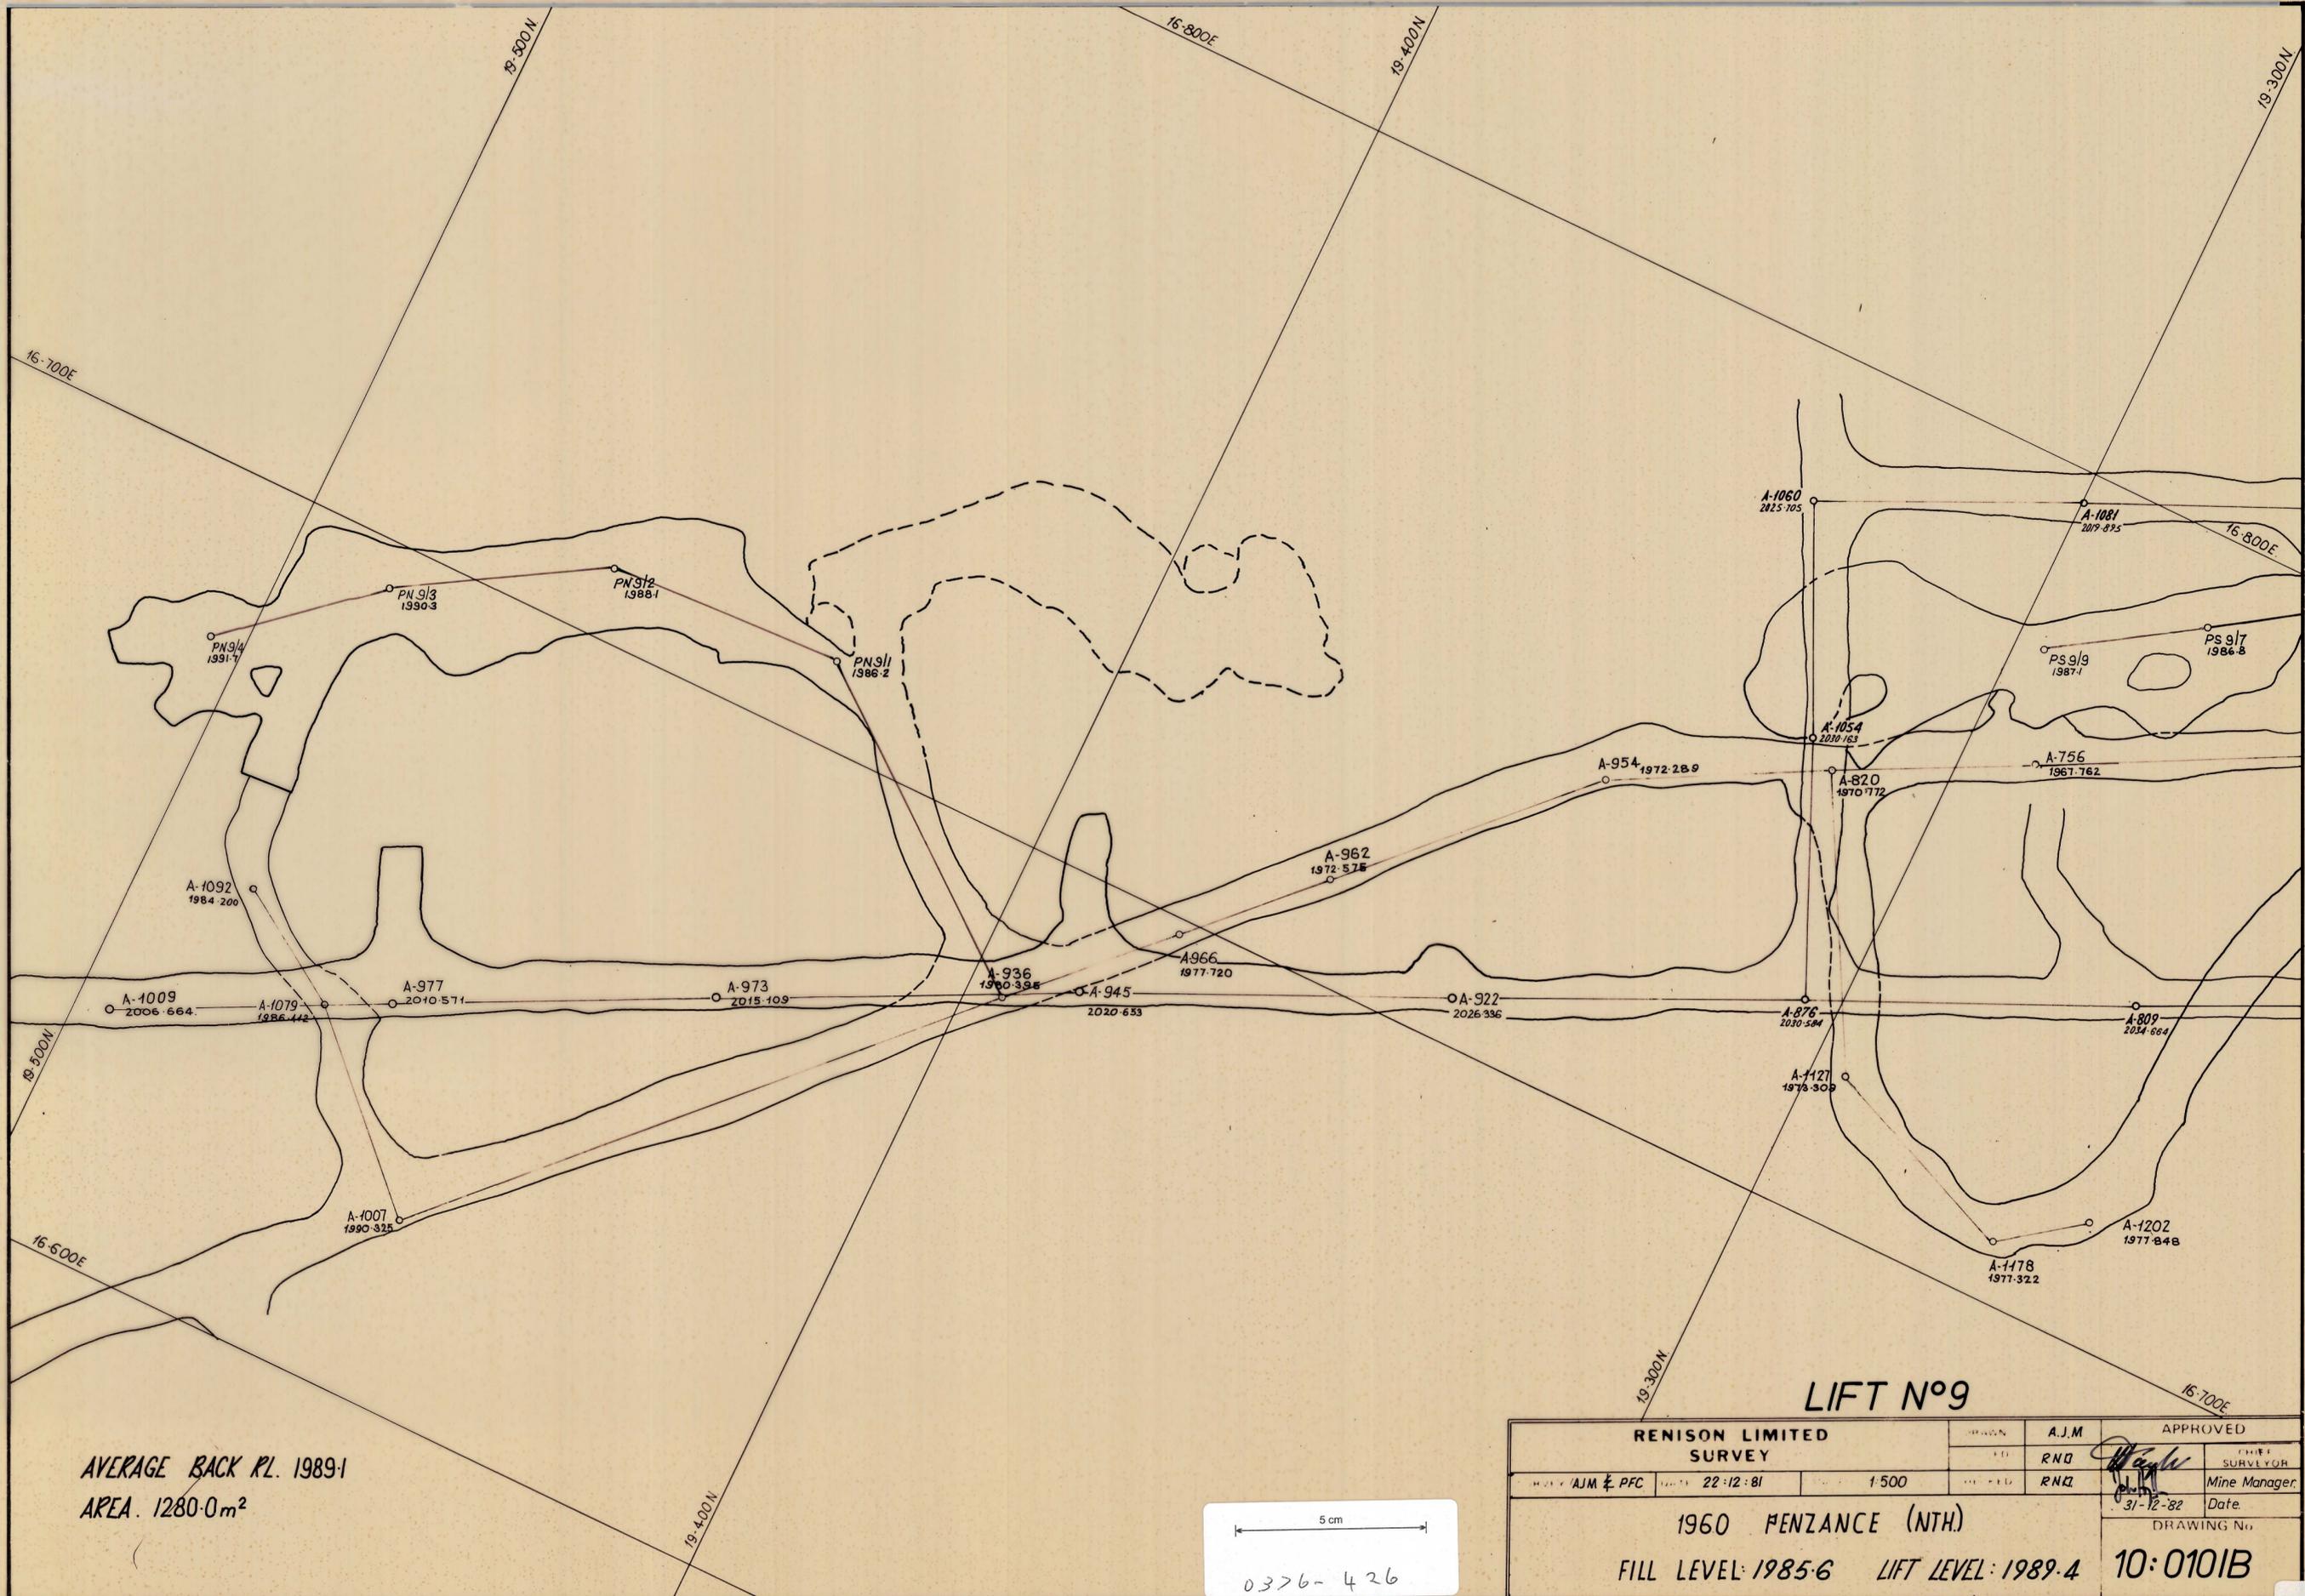

AVERAGE BACK PL. 1989-1  
 AREA. 1280.0m<sup>2</sup>

5 cm  
 0376-426

LIFT N<sup>o</sup>9

RENISON LIMITED SURVEY		DATE	A.J.M	APPROVED
BY	22-12-81	1:500	RND	CHIEF SURVEYOR
BY			RND	Mine Manager.
1960 PENZANCE (NTH.)				Date.
FILL LEVEL: 1985.6 LIFT LEVEL: 1989.4				31-12-82
				DRAWING No
				10:0101B

83192