


0376-427

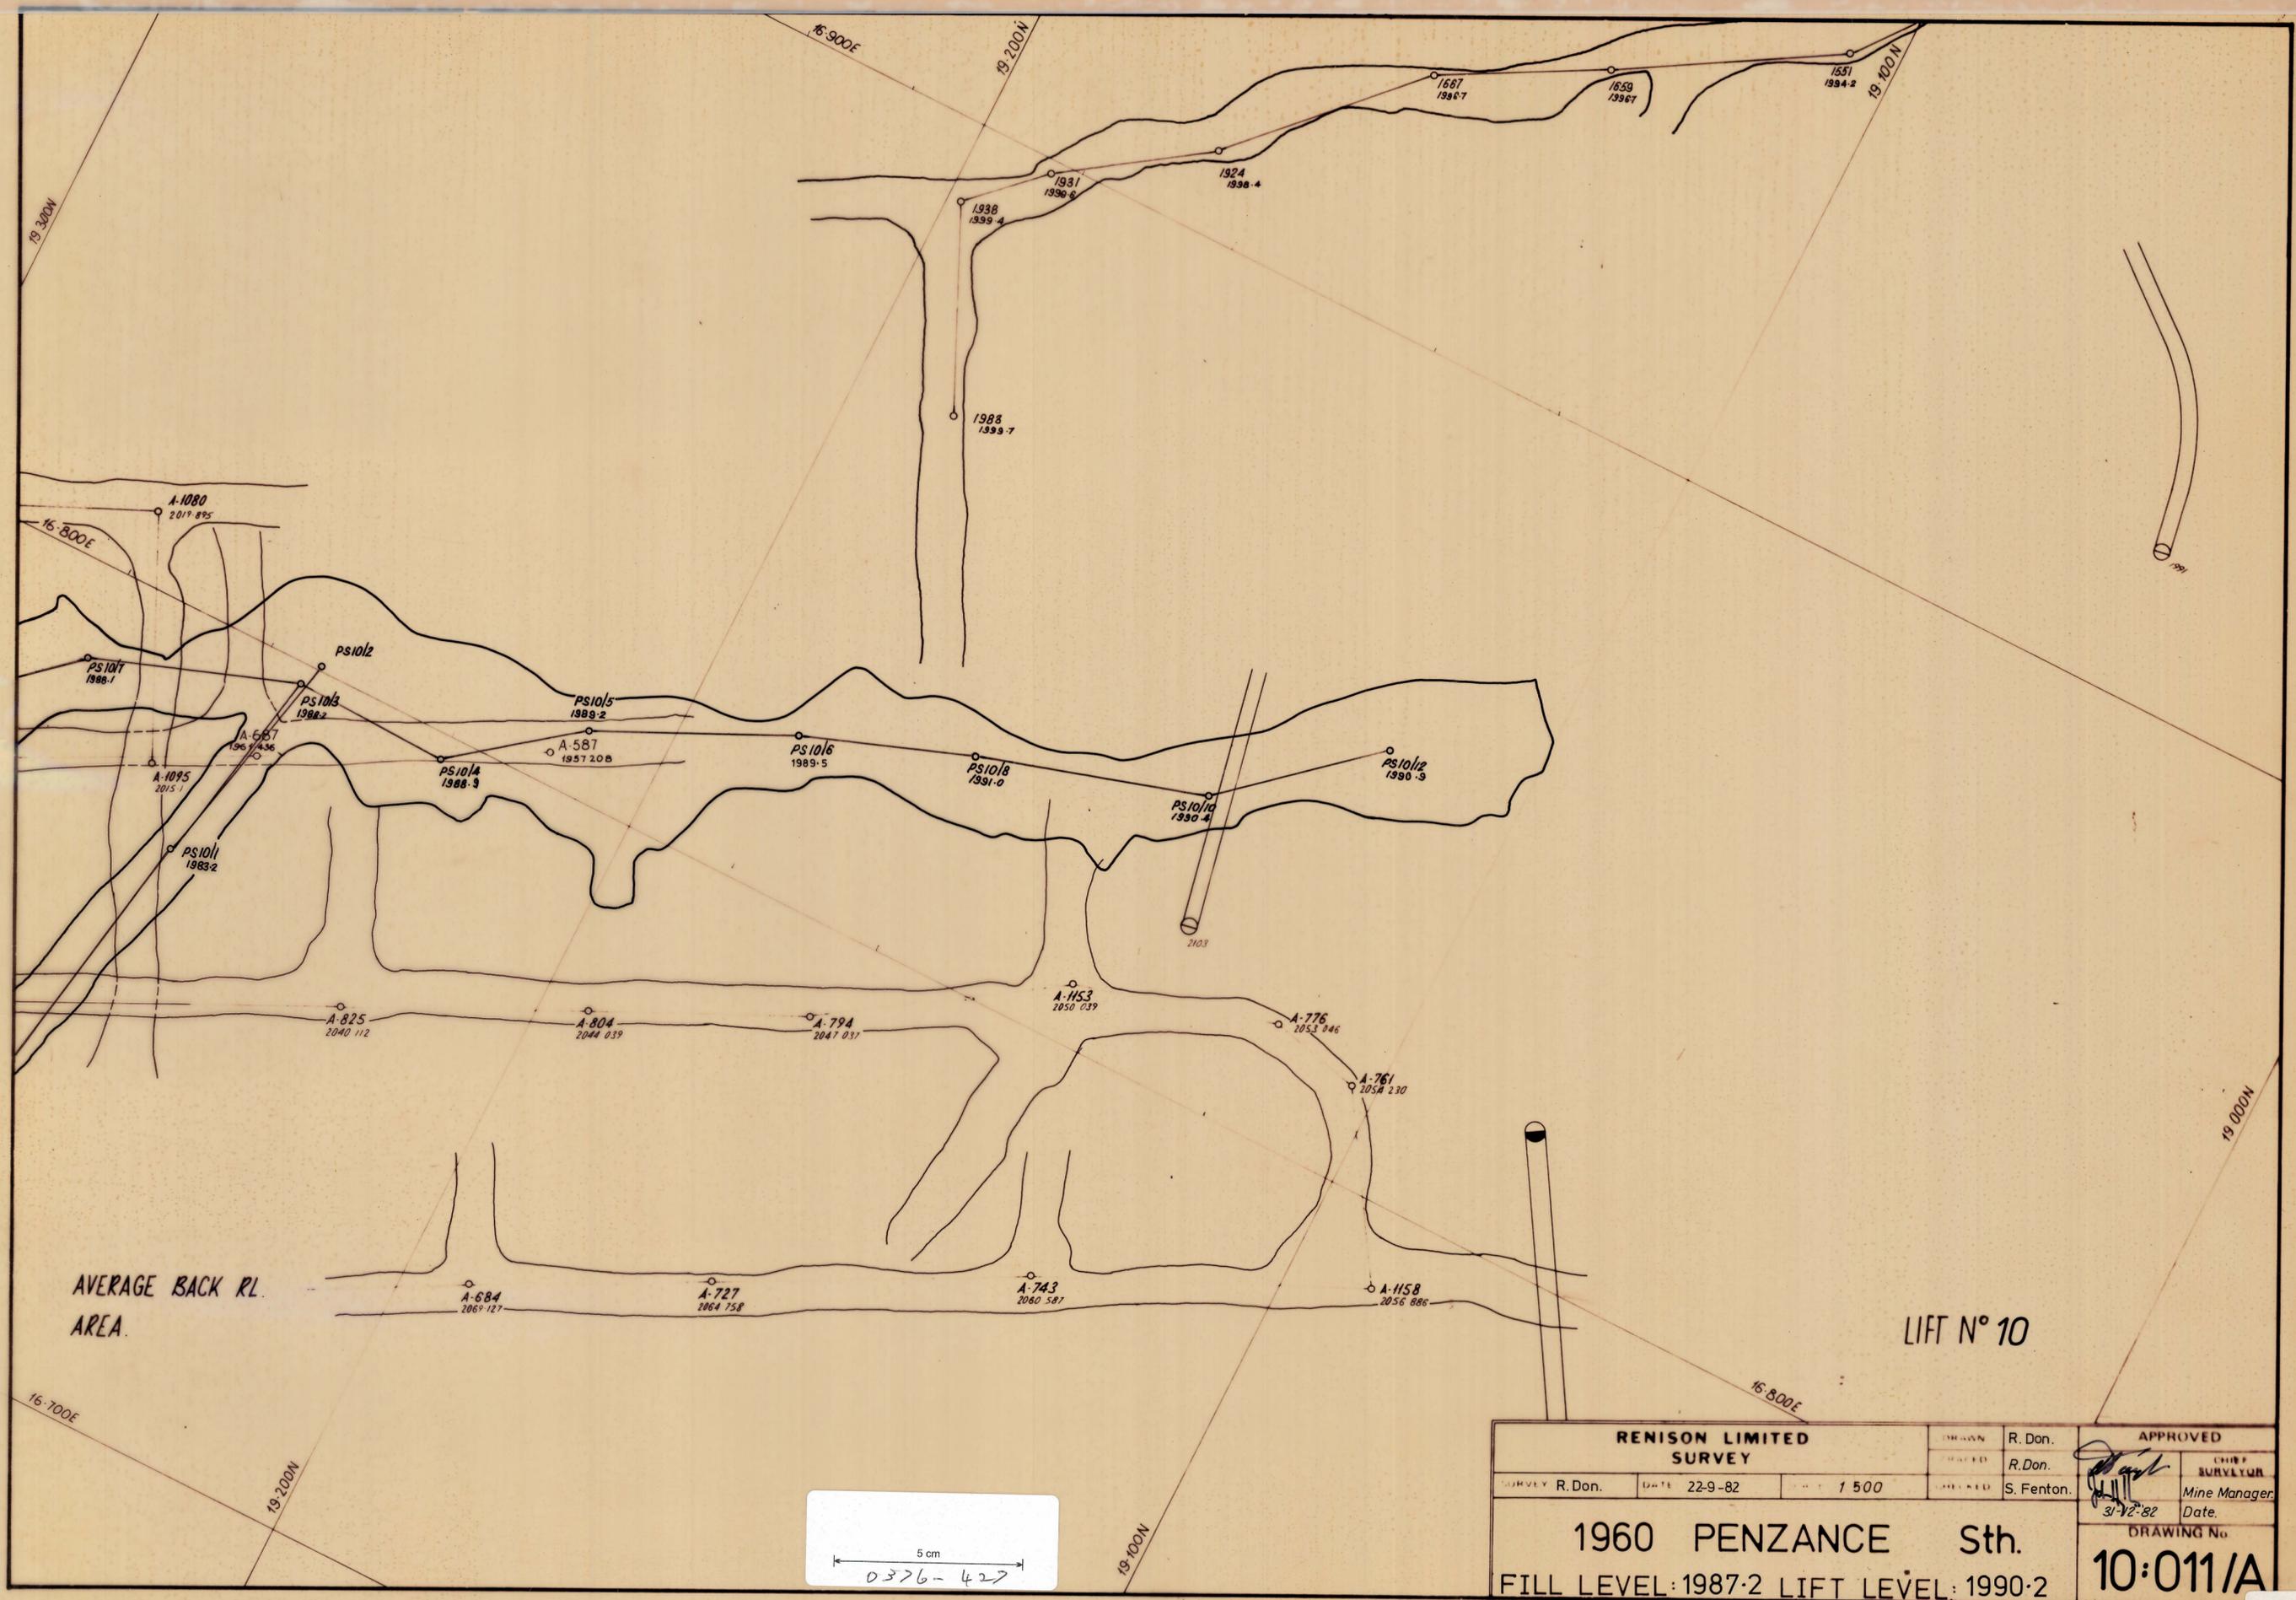


AVERAGE BACK RL AREA.

LIFT N° 10

RENISON LIMITED SURVEY DRAWN R. Don. CHECKED R. Don. SURVEY R. Don. DATE 22-9-82 1 500 CHECKED S. Fenton.			APPROVED <i>[Signature]</i> CHIEF SURVEYOR Date 31-12-82 Mine Manager	
			DRAWING No 10:011/A	

1960 PENZANCE Sth.
 FILL LEVEL: 1987.2 LIFT LEVEL: 1990.2

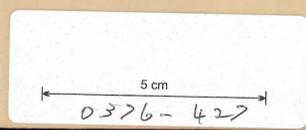

83193