


AVERAGE BACK RL: 2089.94  
 AREA: 1892.5

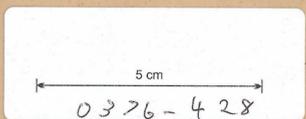

LIFT N°6

<b>RENISON LIMITED SURVEY</b> SURVEY: A.J.M.    DATE: 18-7-77    SCALE: 1:500.			DRAWN: A.J.M. TRACED: R.N.D.	APPROVED <i>[Signature]</i> CHIEF SURVEYOR
			CHECKED: R.N.D.	Date: 31.12.1982 Mine Manager
2075 MURCHISON FILL LEVEL: 2087.7    LIFT RL: 2089.69		DRAWING No. 9-006		