



0376-434

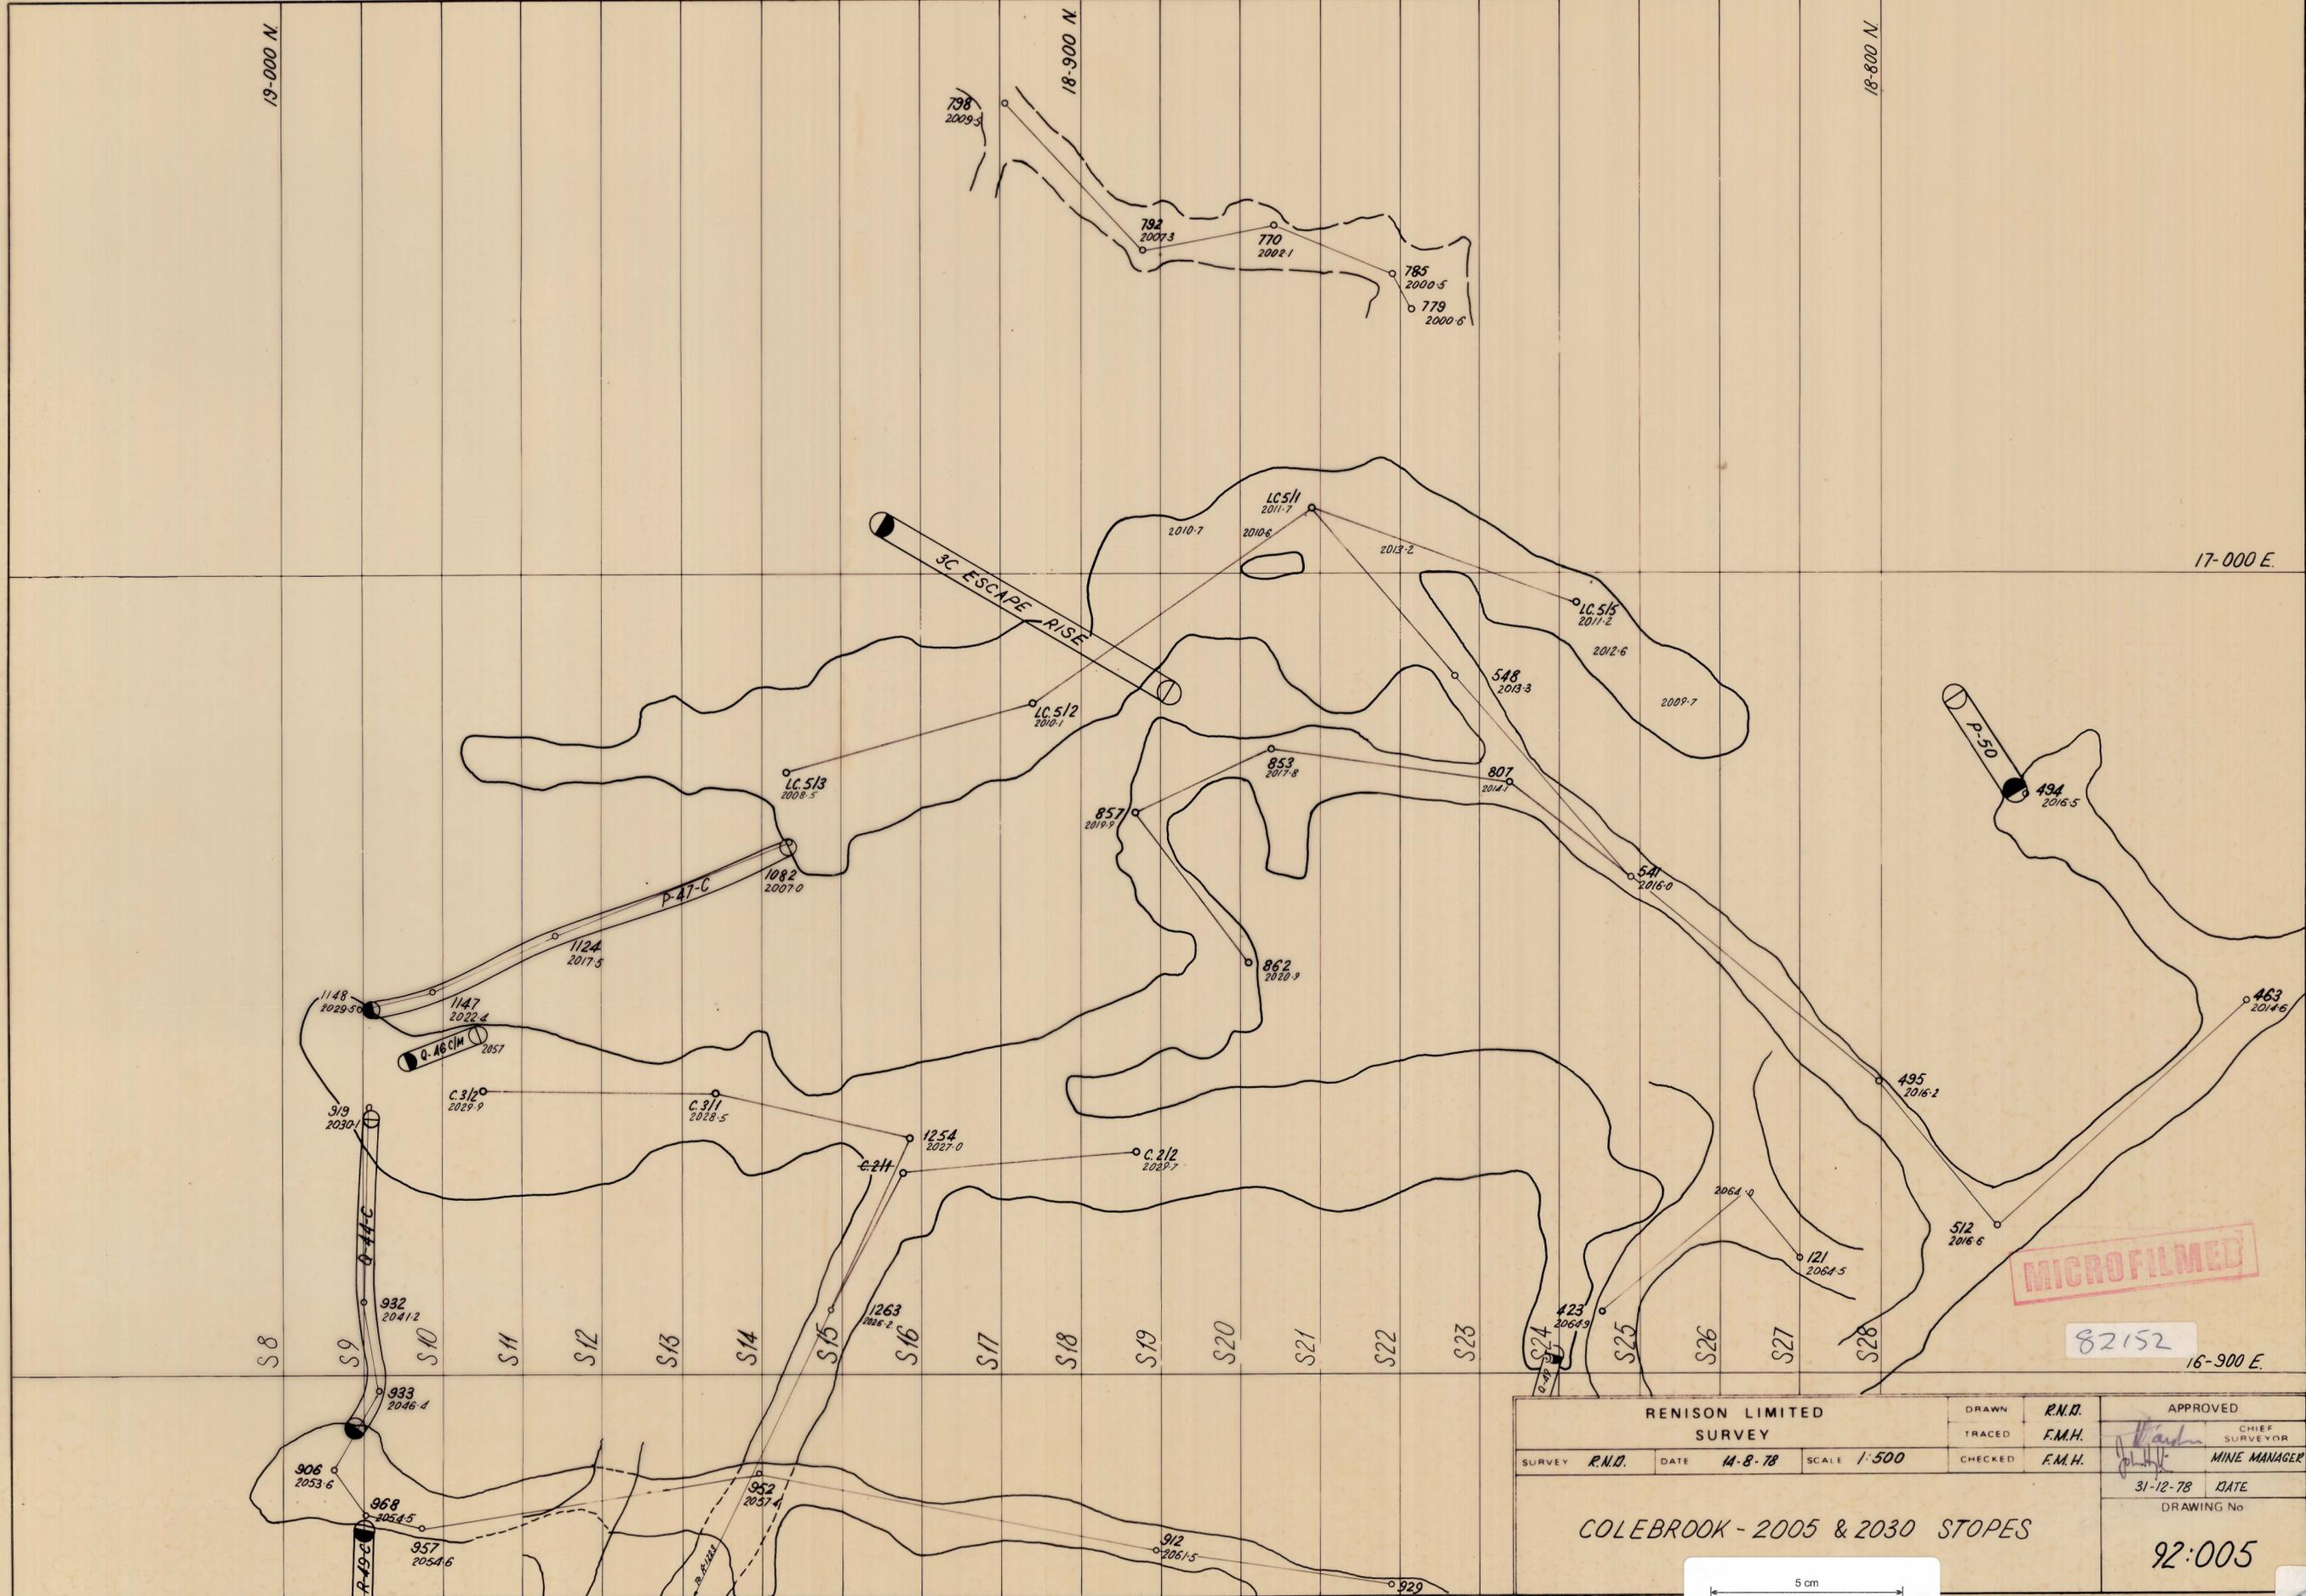

MICROFILMED

82152

RENISON LIMITED SURVEY				DRAWN	R.N.D.	APPROVED	
SURVEY				TRACED	F.M.H.	CHIEF SURVEYOR	
R.N.D.	DATE	14-8-78	SCALE	CHECKED	F.M.H.	MINE MANAGER	
COLEBROOK - 2005 & 2030 STOPES						31-12-78	DATE
						DRAWING No	
						92:005	

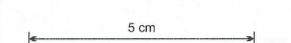

0376-434

83218