


0376-435

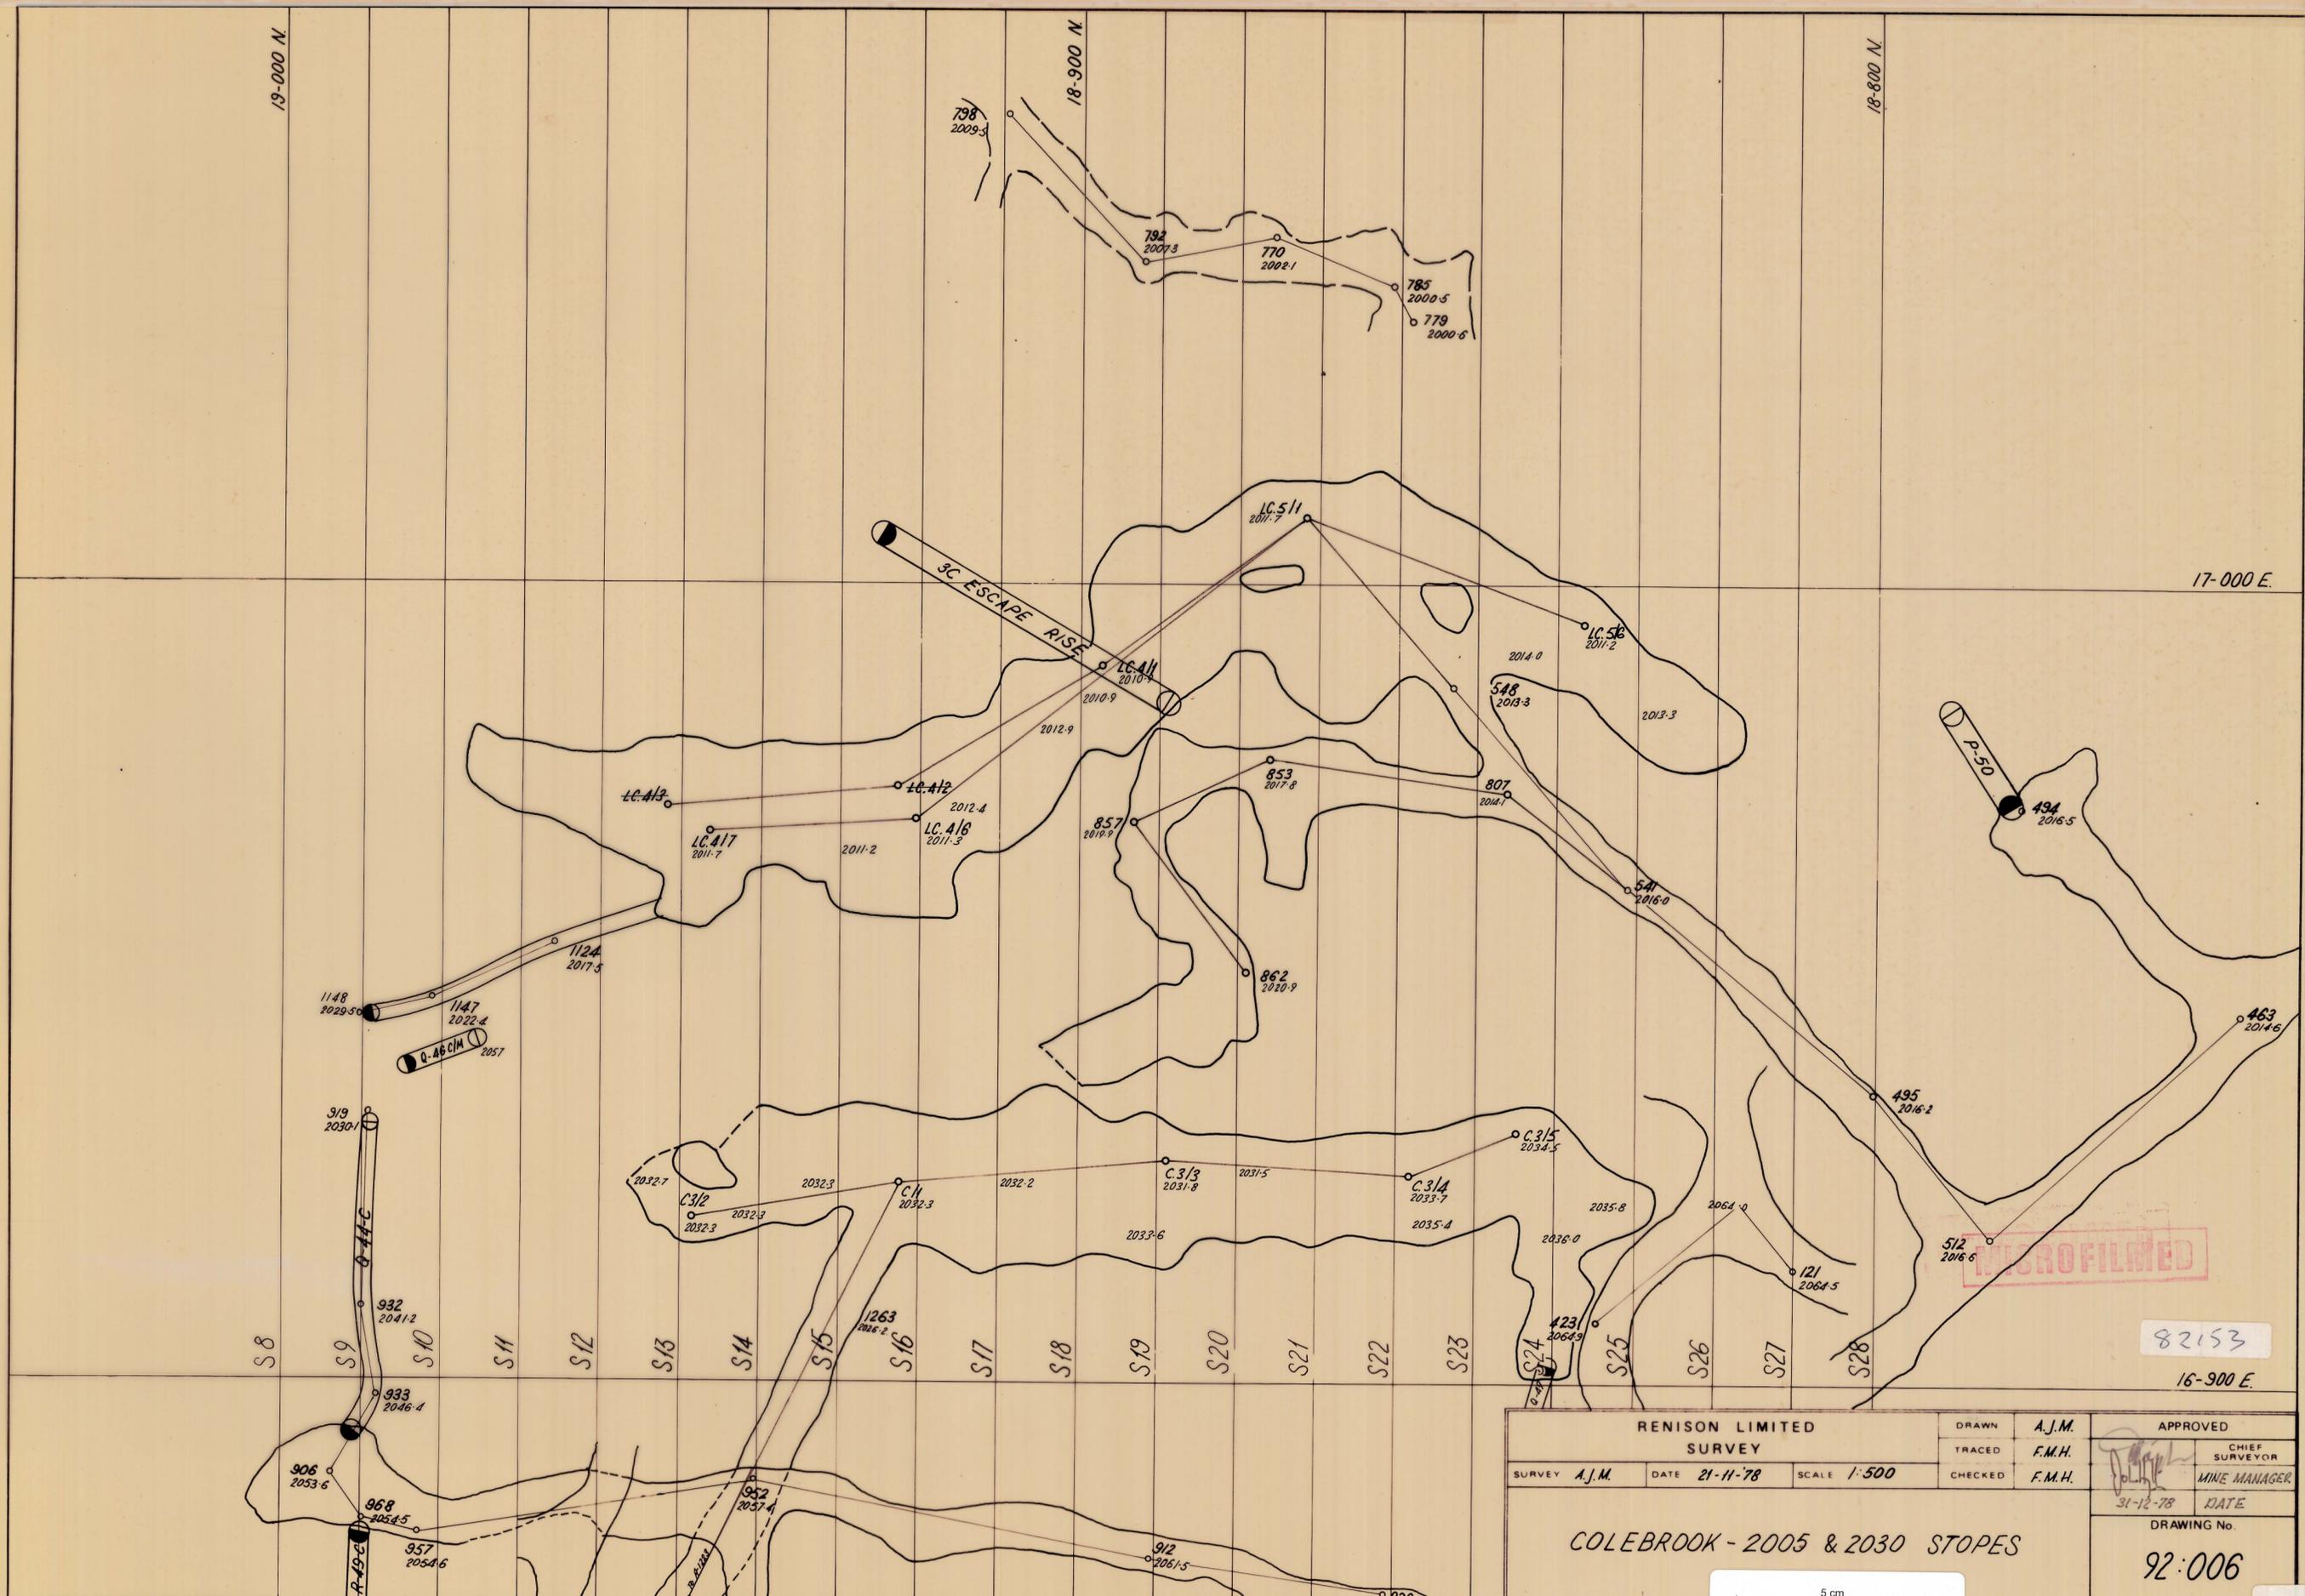

REXON LIMITED SURVEY			DRAWN	A.J.M.	APPROVED
			TRACED	F.M.H.	CHIEF SURVEYOR
SURVEY A.J.M.			CHECKED	F.M.H.	MINE MANAGER
DATE 21-11-78			31-12-78		DATE
SCALE 1:500			DRAWING No.		
COLEBROOK - 2005 & 2030 STOPES			92:006		

5 cm
0376-435

82153
16-900 E.

83219