


0376-440

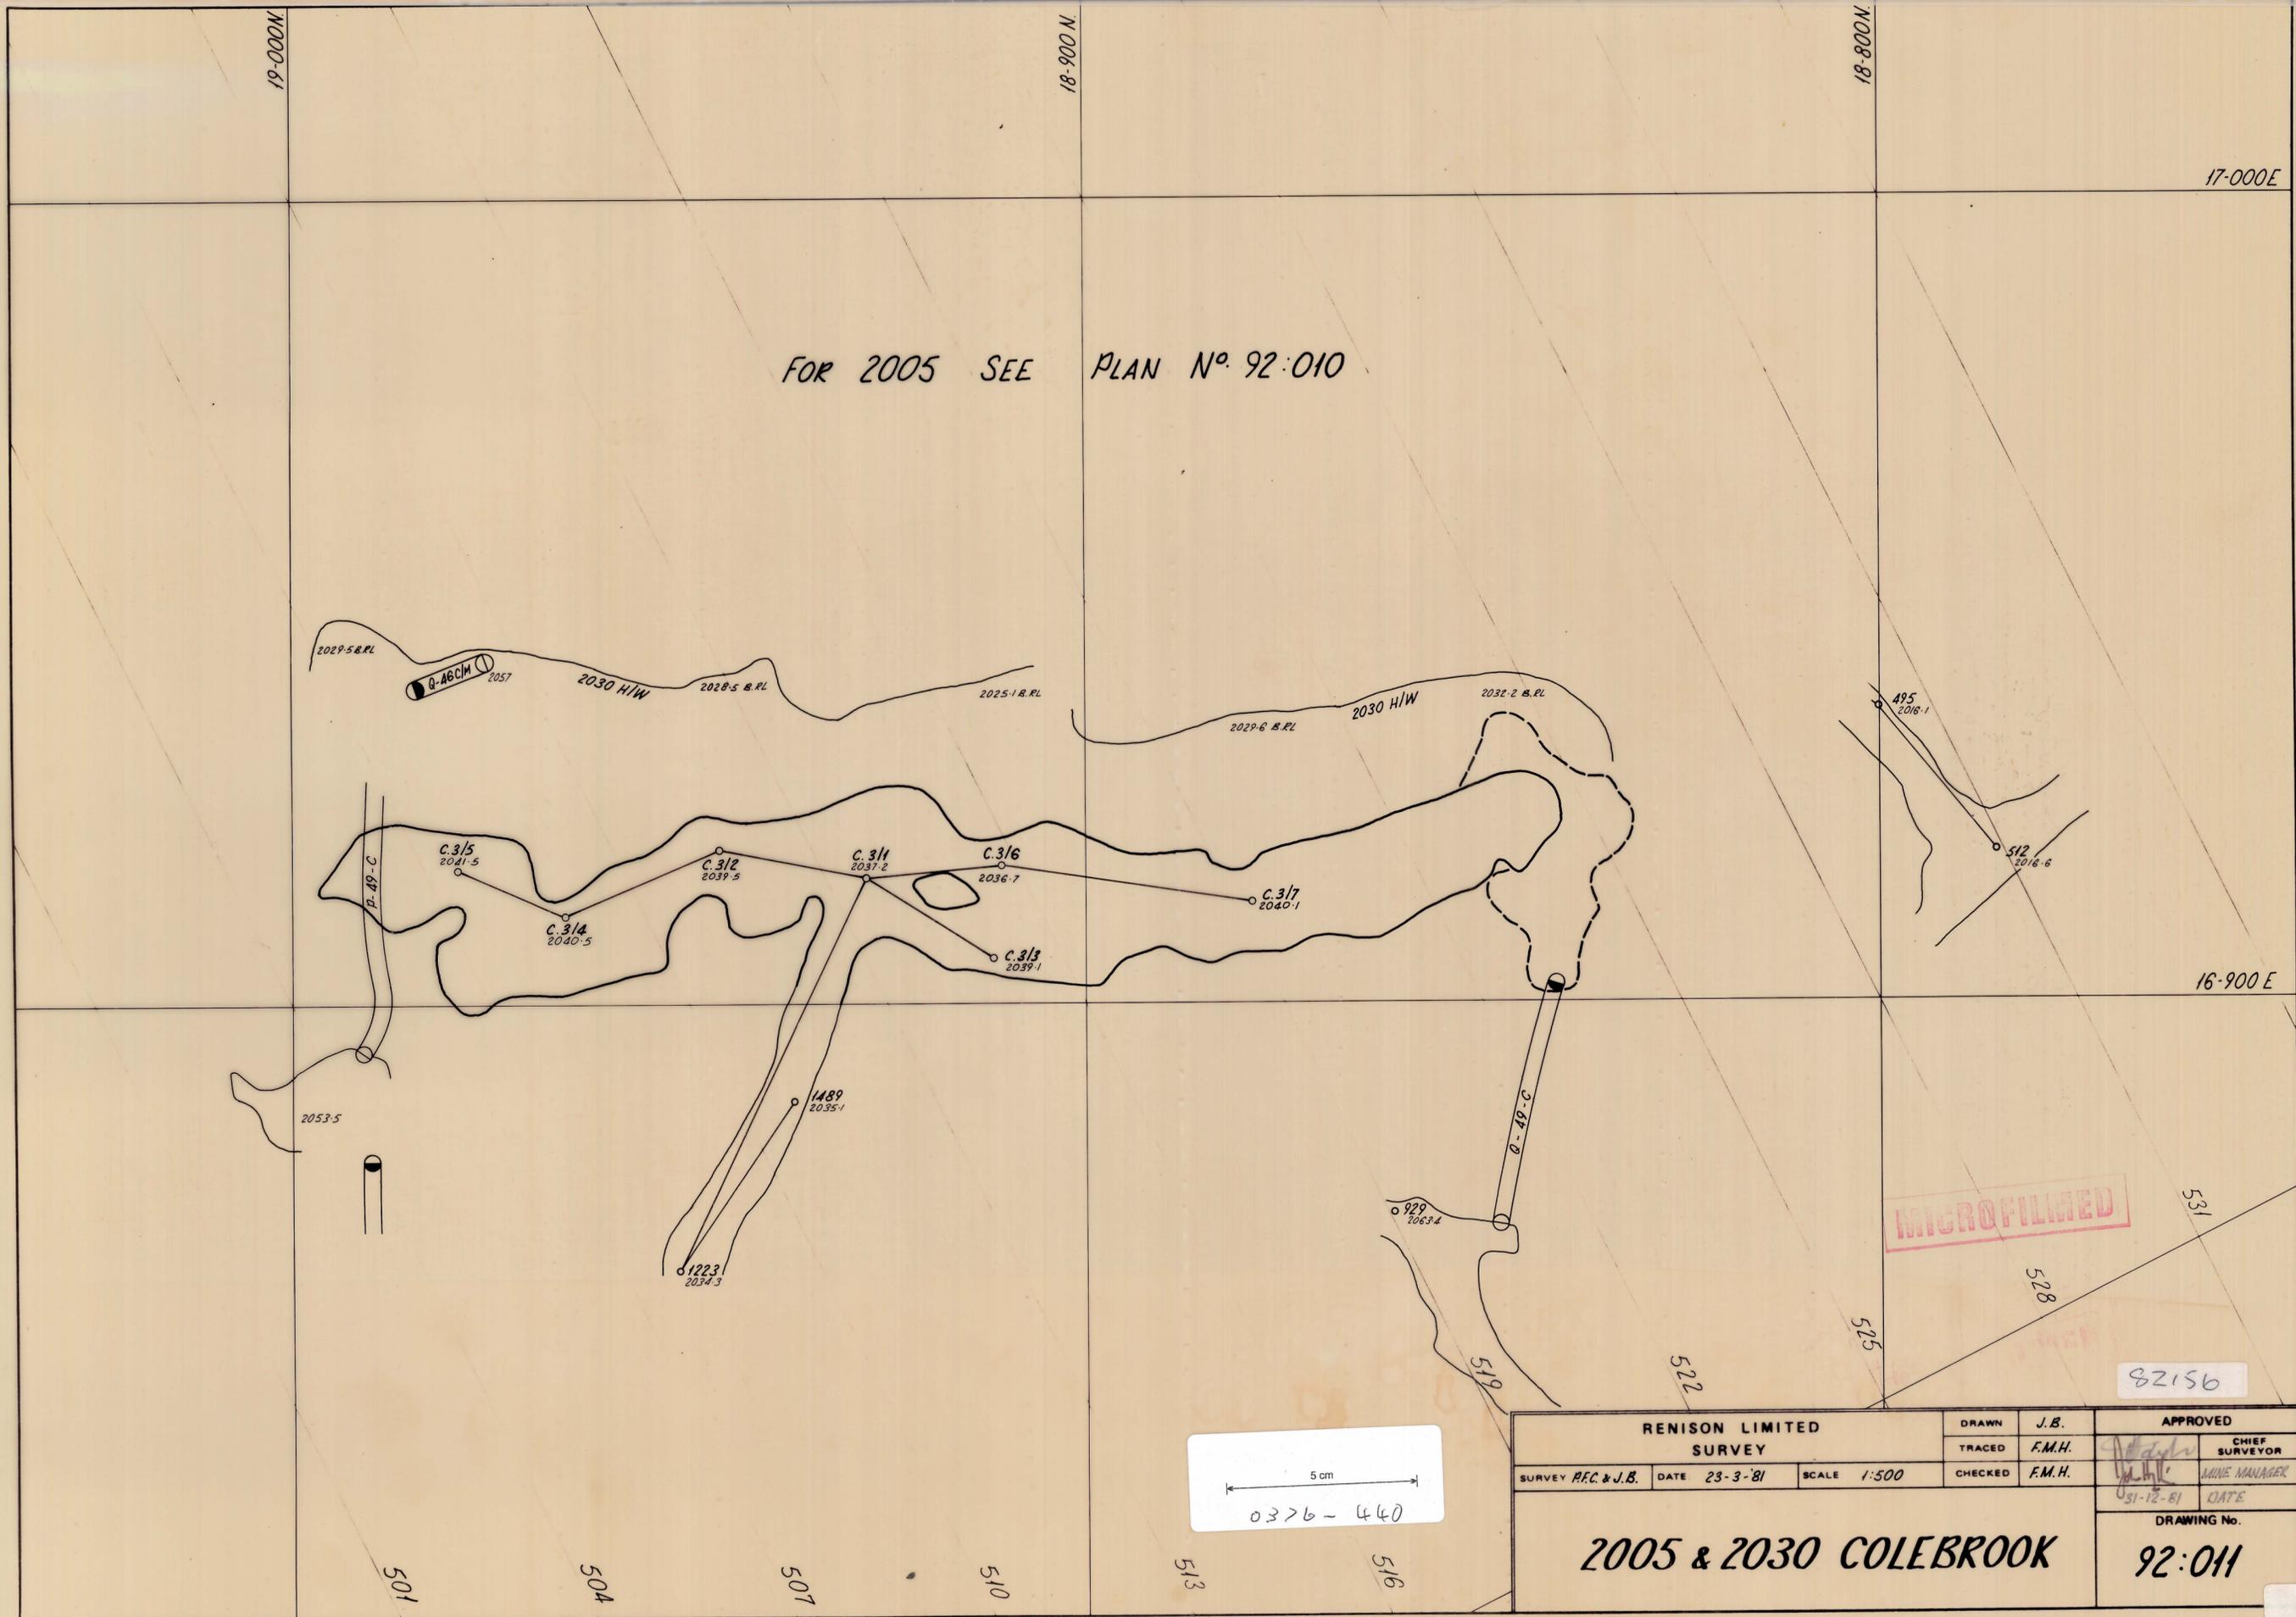

FOR 2005 SEE PLAN No. 92:010

5 cm
0376-440

MICROFILMED

82156

RENISON LIMITED SURVEY			DRAWN	J.B.	APPROVED	
			TRACED	F.M.H.	CHIEF SURVEYOR	
			CHECKED	F.M.H.	MINE MANAGER	
SURVEY	RFC & J.B.	DATE	23-3-'81	SCALE	1:500	DATE
2005 & 2030 COLEBROOK						DRAWING No.
						92:011

83224