


0376-443

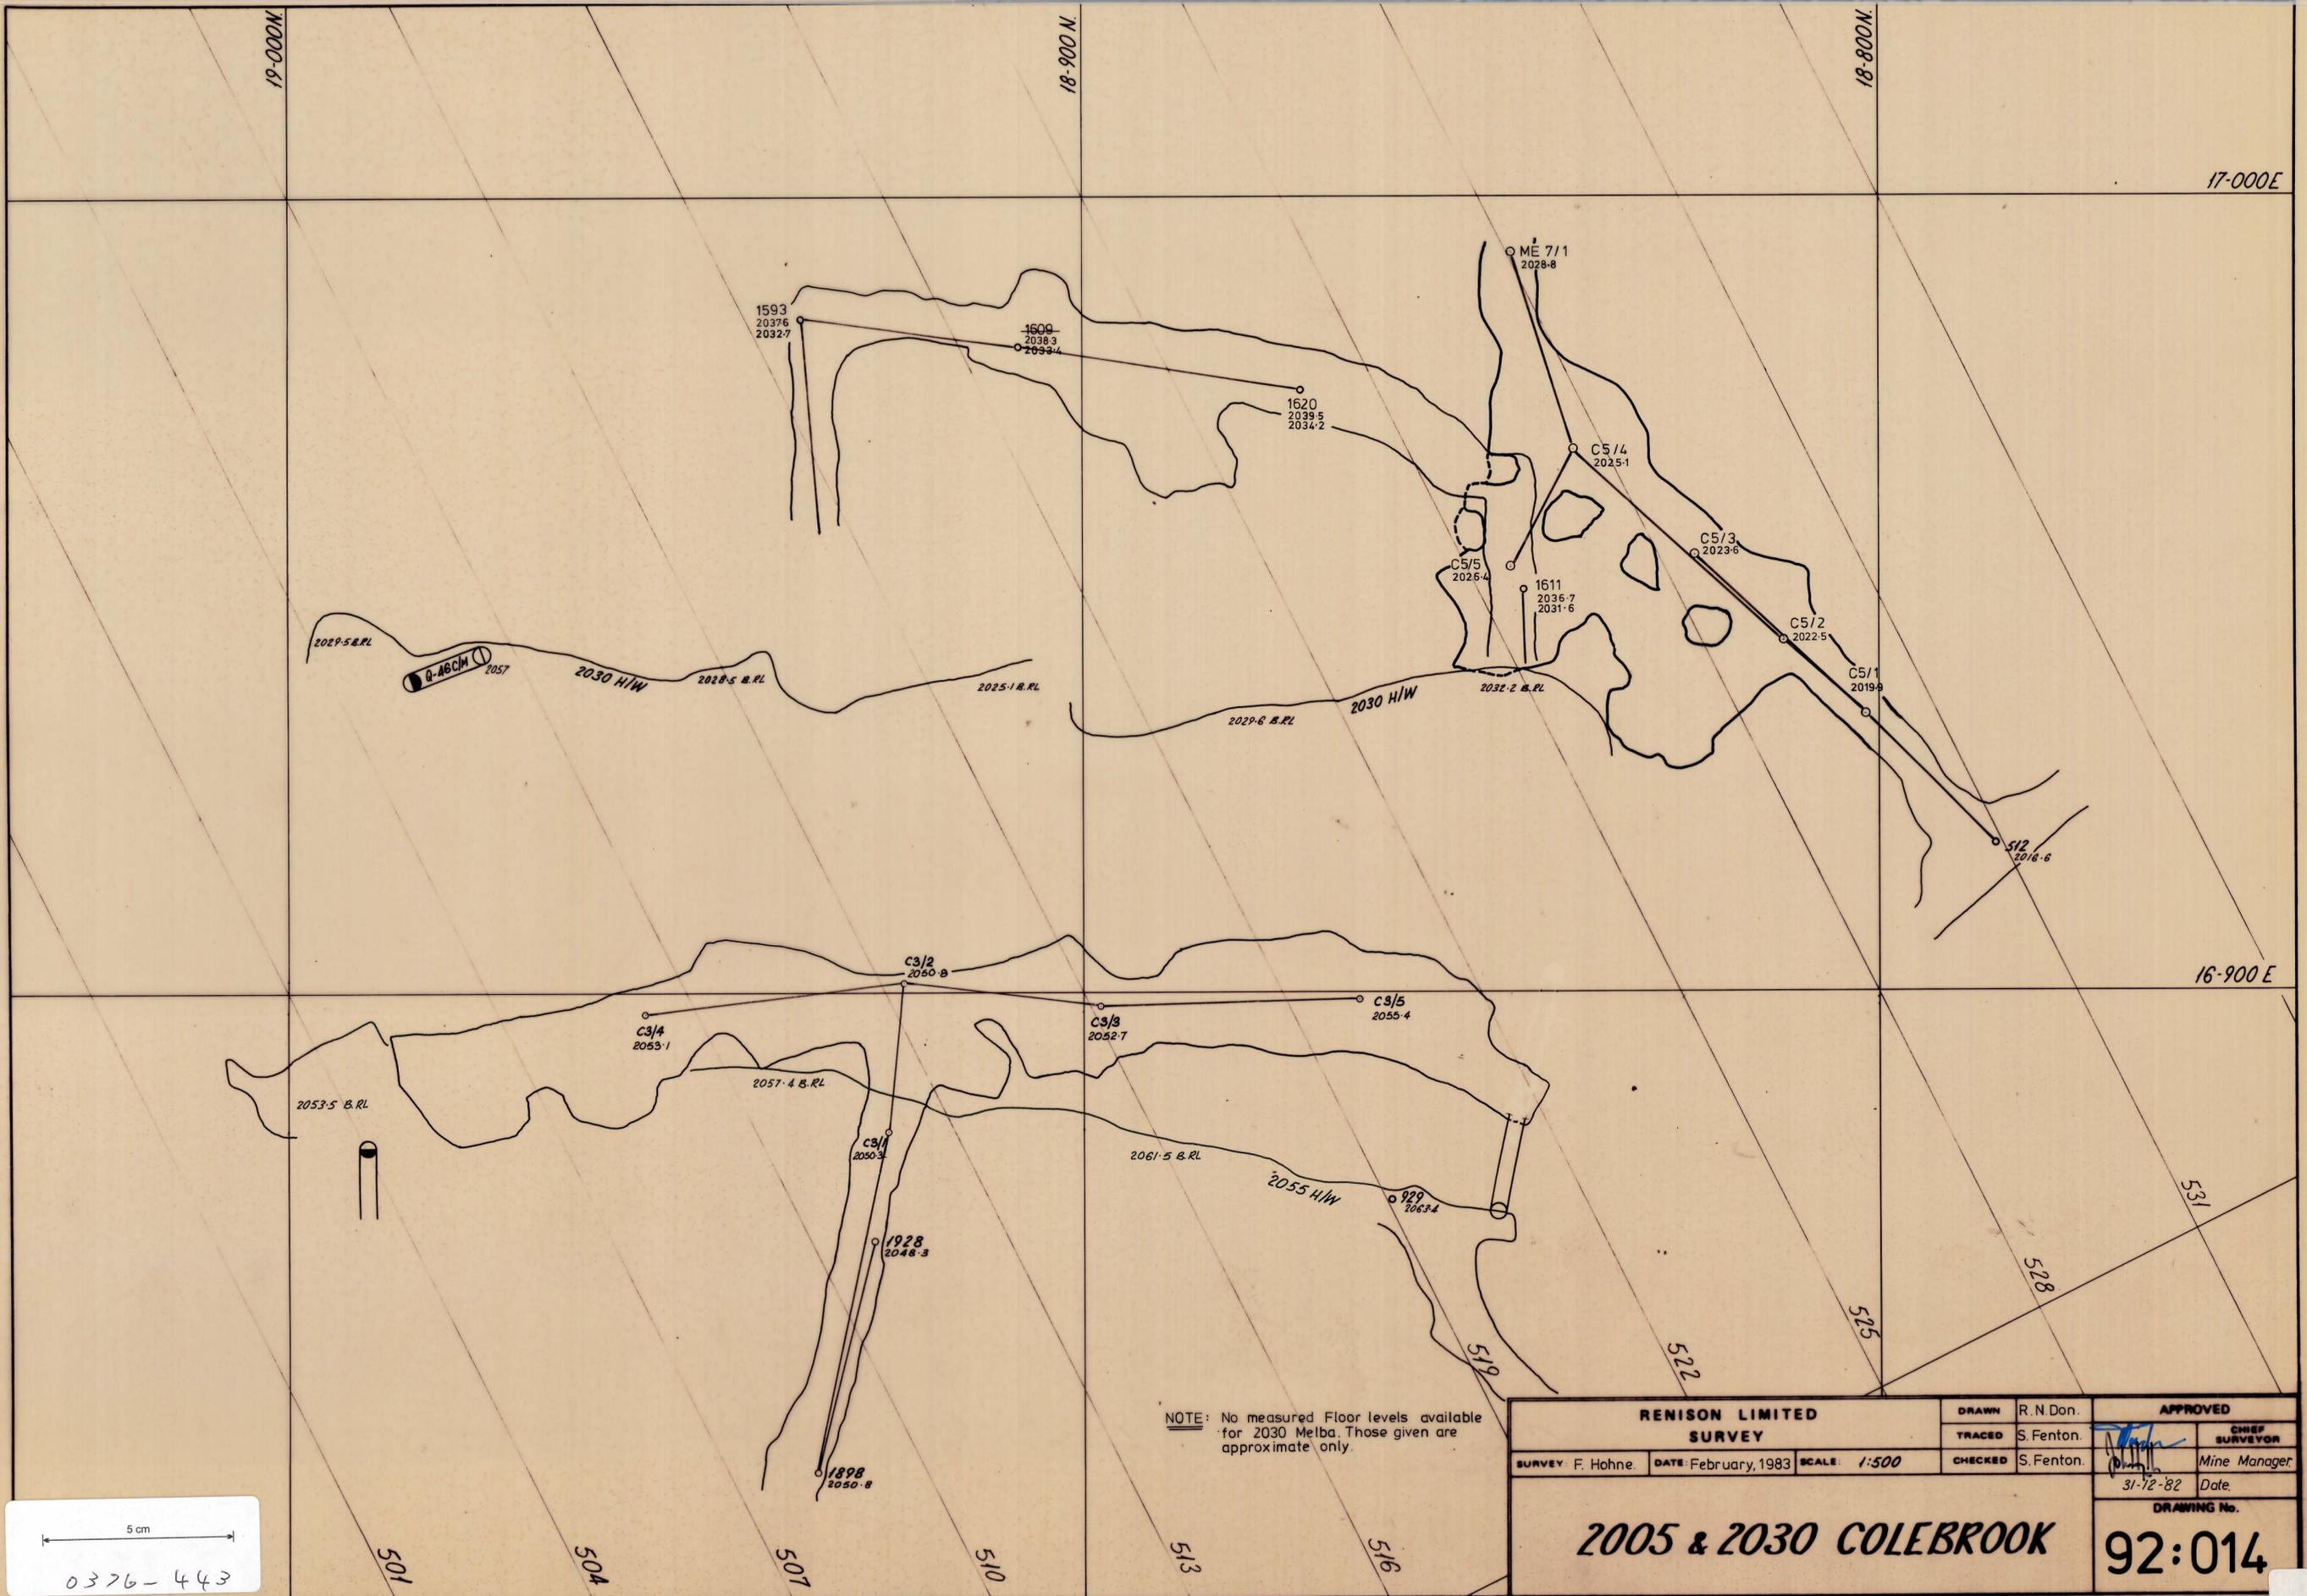

5 cm
0376-443

RENISON LIMITED SURVEY			DRAWN	R. N. Don.	APPROVED		
			TRACED	S. Fenton.			[Signature]
SURVEY: F. Hohne.		DATE: February, 1983	SCALE: 1:500	CHECKED	S. Fenton.	Mine Manager.	
2005 & 2030 COLEBROOK						Date.	31-12-82
						DRAWING No.	

83227