


0376-446

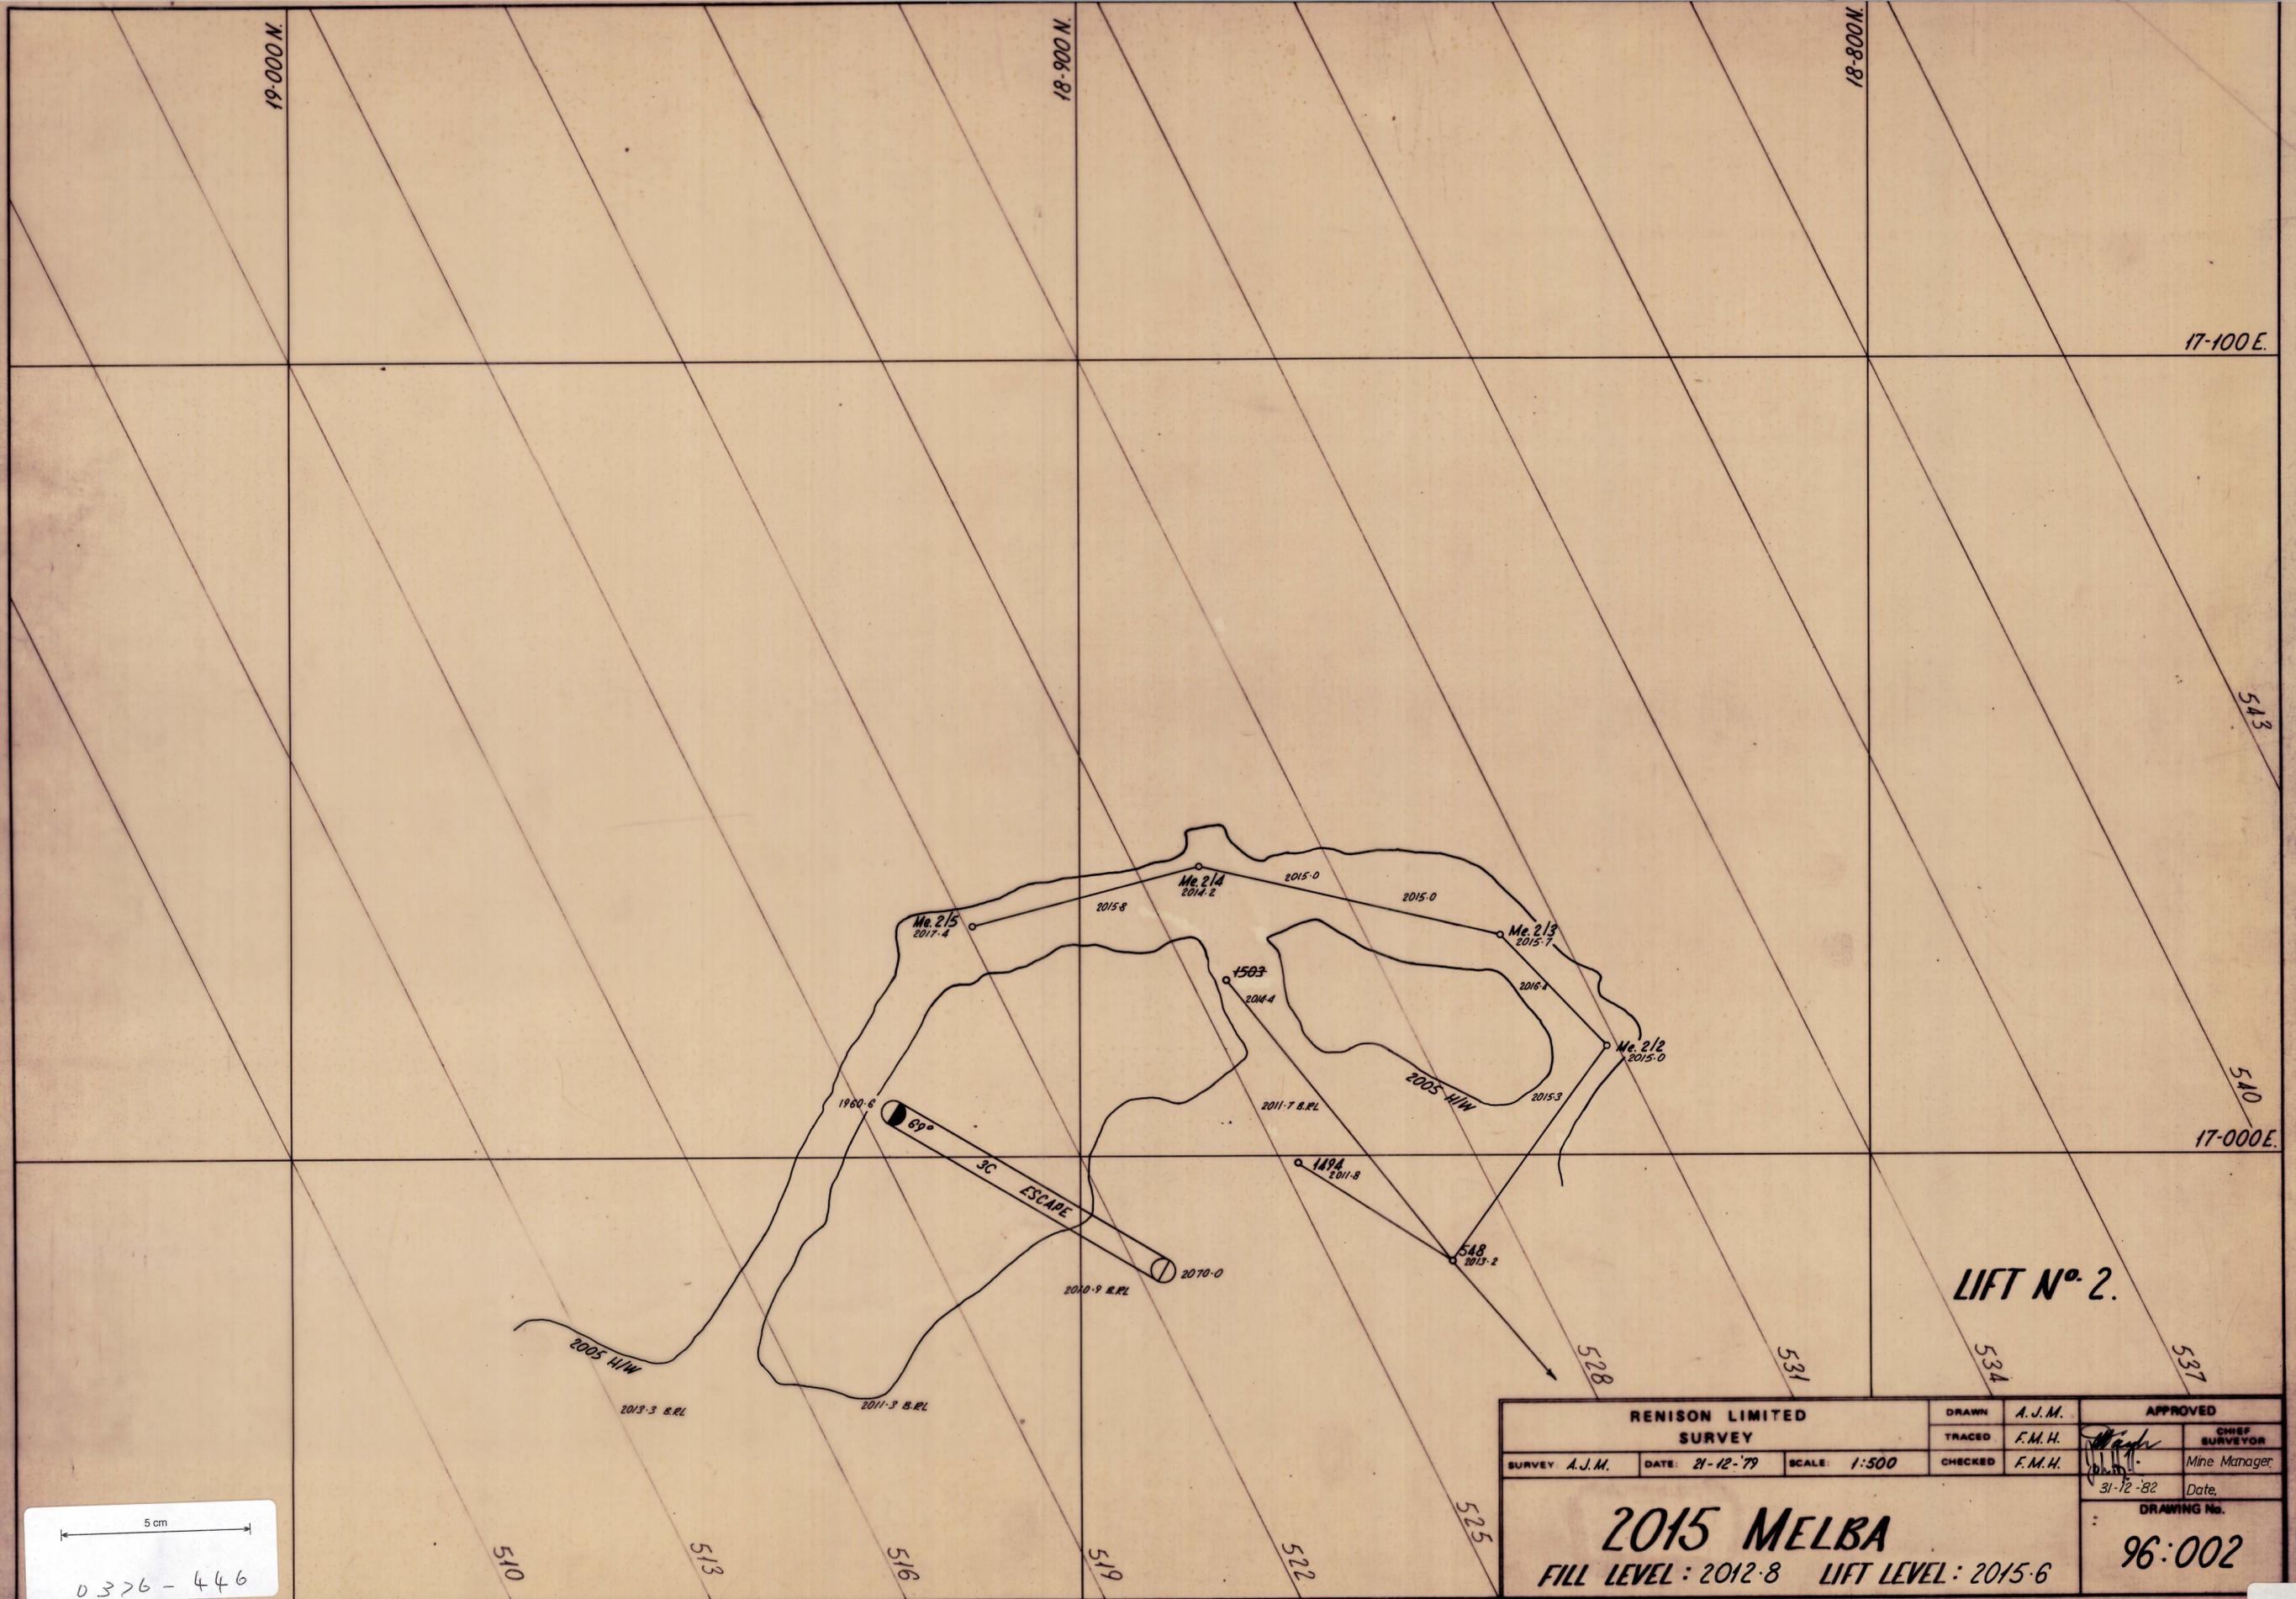

LIFT No. 2.

RENISON LIMITED SURVEY			DRAWN	A. J. M.	APPROVED
			TRACED	F. M. H.	CHIEF SURVEYOR
SURVEY	A. J. M.	DATE: 21-12-79	CHECKED	F. M. H.	Mine Manager
			31-12-82		Date
2015 MELBA					DRAWING No.
FILL LEVEL: 2012.8					96:002
LIFT LEVEL: 2015.6					

5 cm

0376-446

83230