


0326-447

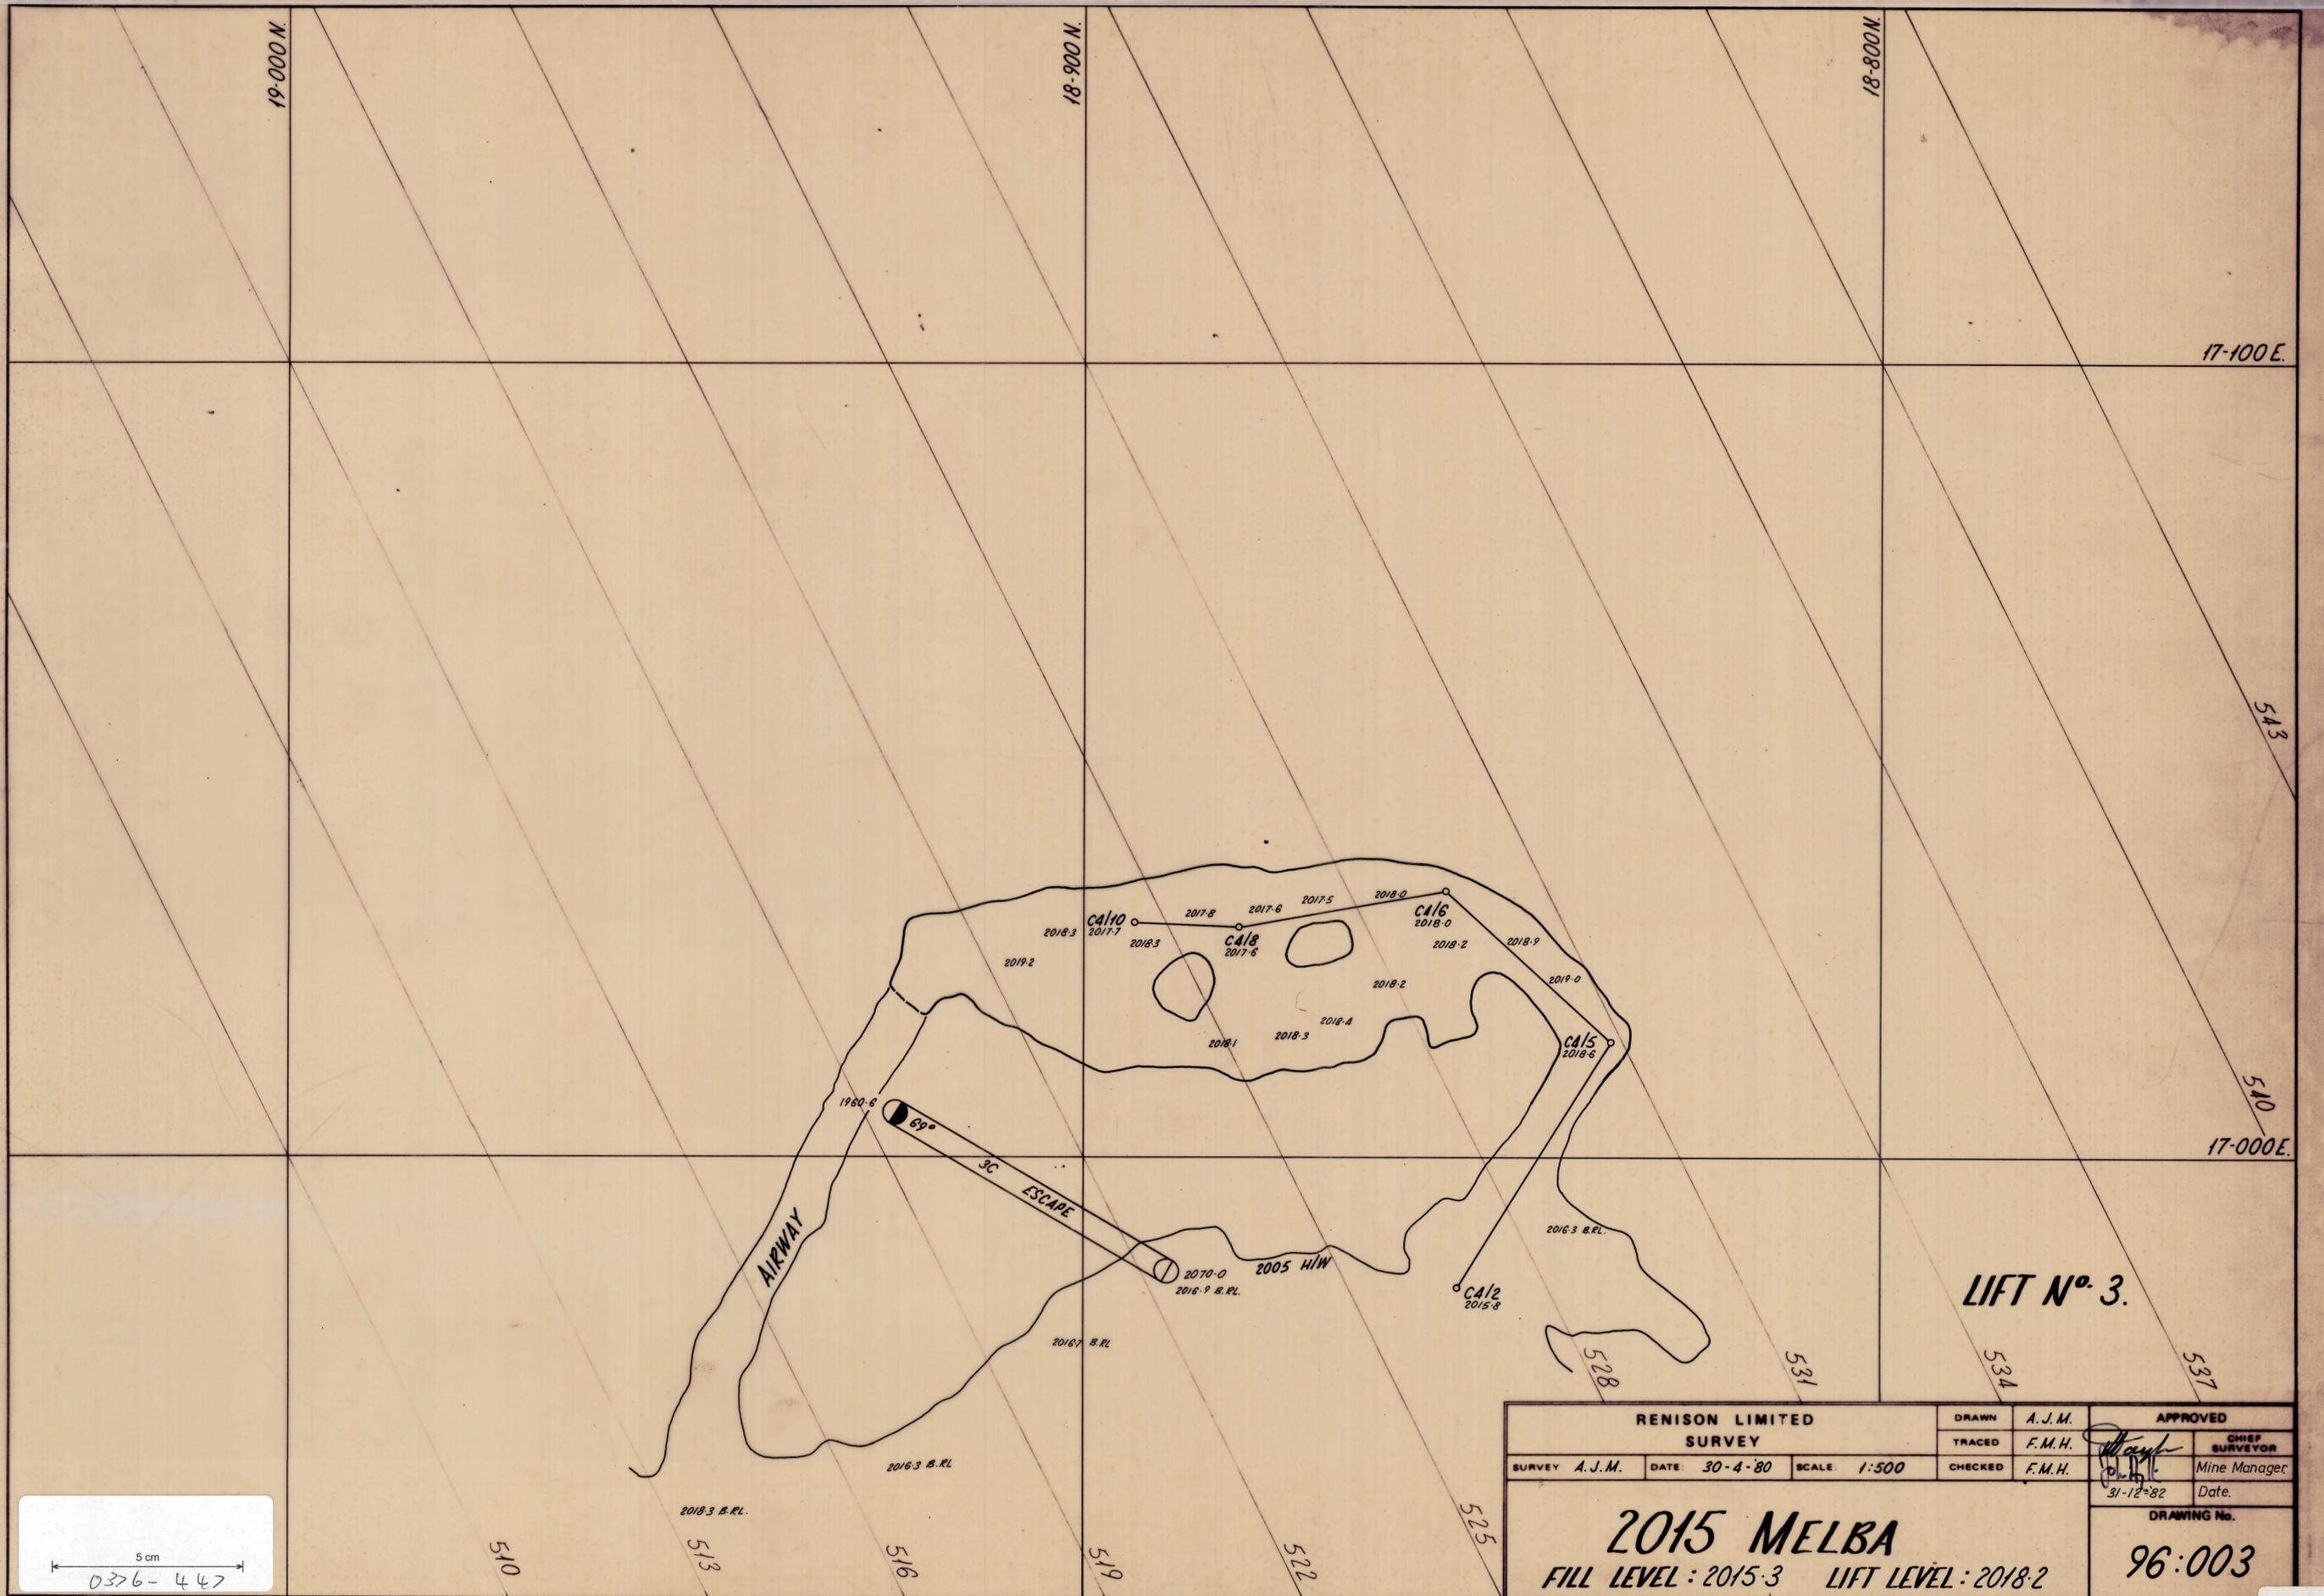

<b>RENISON LIMITED SURVEY</b>				DRAWN	A. J. M.	<b>APPROVED</b>	
				TRACED	F. M. H.	 CHIEF SURVEYOR	
SURVEY	A. J. M.	DATE	30-4-80	CHECKED	F. M. H.	Mine Manager Date: 31-12-82	
SCALE: 1:500				<b>2015 MELBA</b>		DRAWING No.	
				FILL LEVEL: 2015-3		LIFT LEVEL: 2018-2	
				<b>96:003</b>			

5 cm  
0326-447

83231