

0376-448

19-000 N

18-900 N

18-800 N

17-100 E

543

540

17-000 E

537

LIFT N° 4.

534

531

528

525


522

519

516

513

510

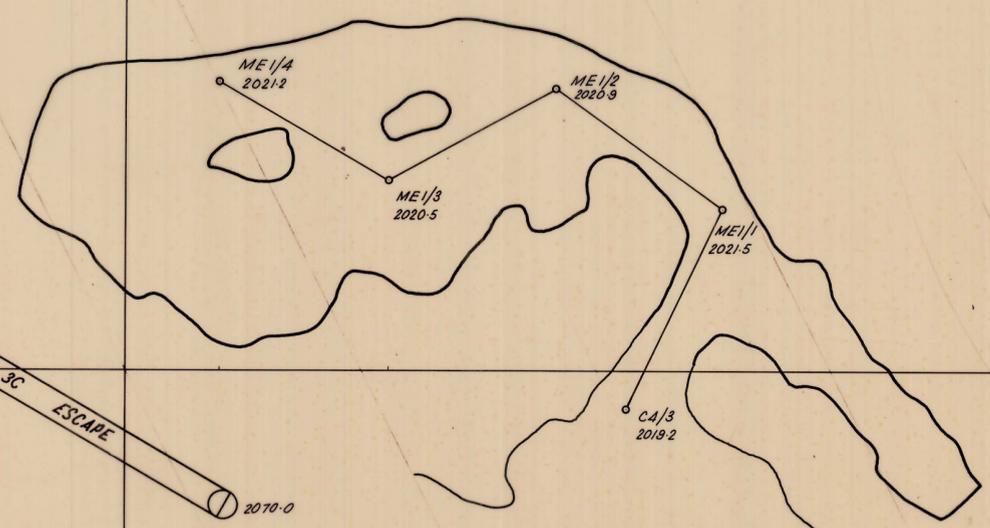

5 cm  
0376-448

DRAWN P.F.C.-J.B.		APPROVED	
TRACED J.B.		CHIEF SURVEYOR	
SURVEY P.F.C.-J.B.		31-12-82 Date	
DATE 14-11-80		Date	
SCALE 1:500		DRAWING No.	
2015 MELBA		96:004	
FILL LEVEL: 2018-1		LIFT LEVEL: 2021-2	

83232