


0376-449

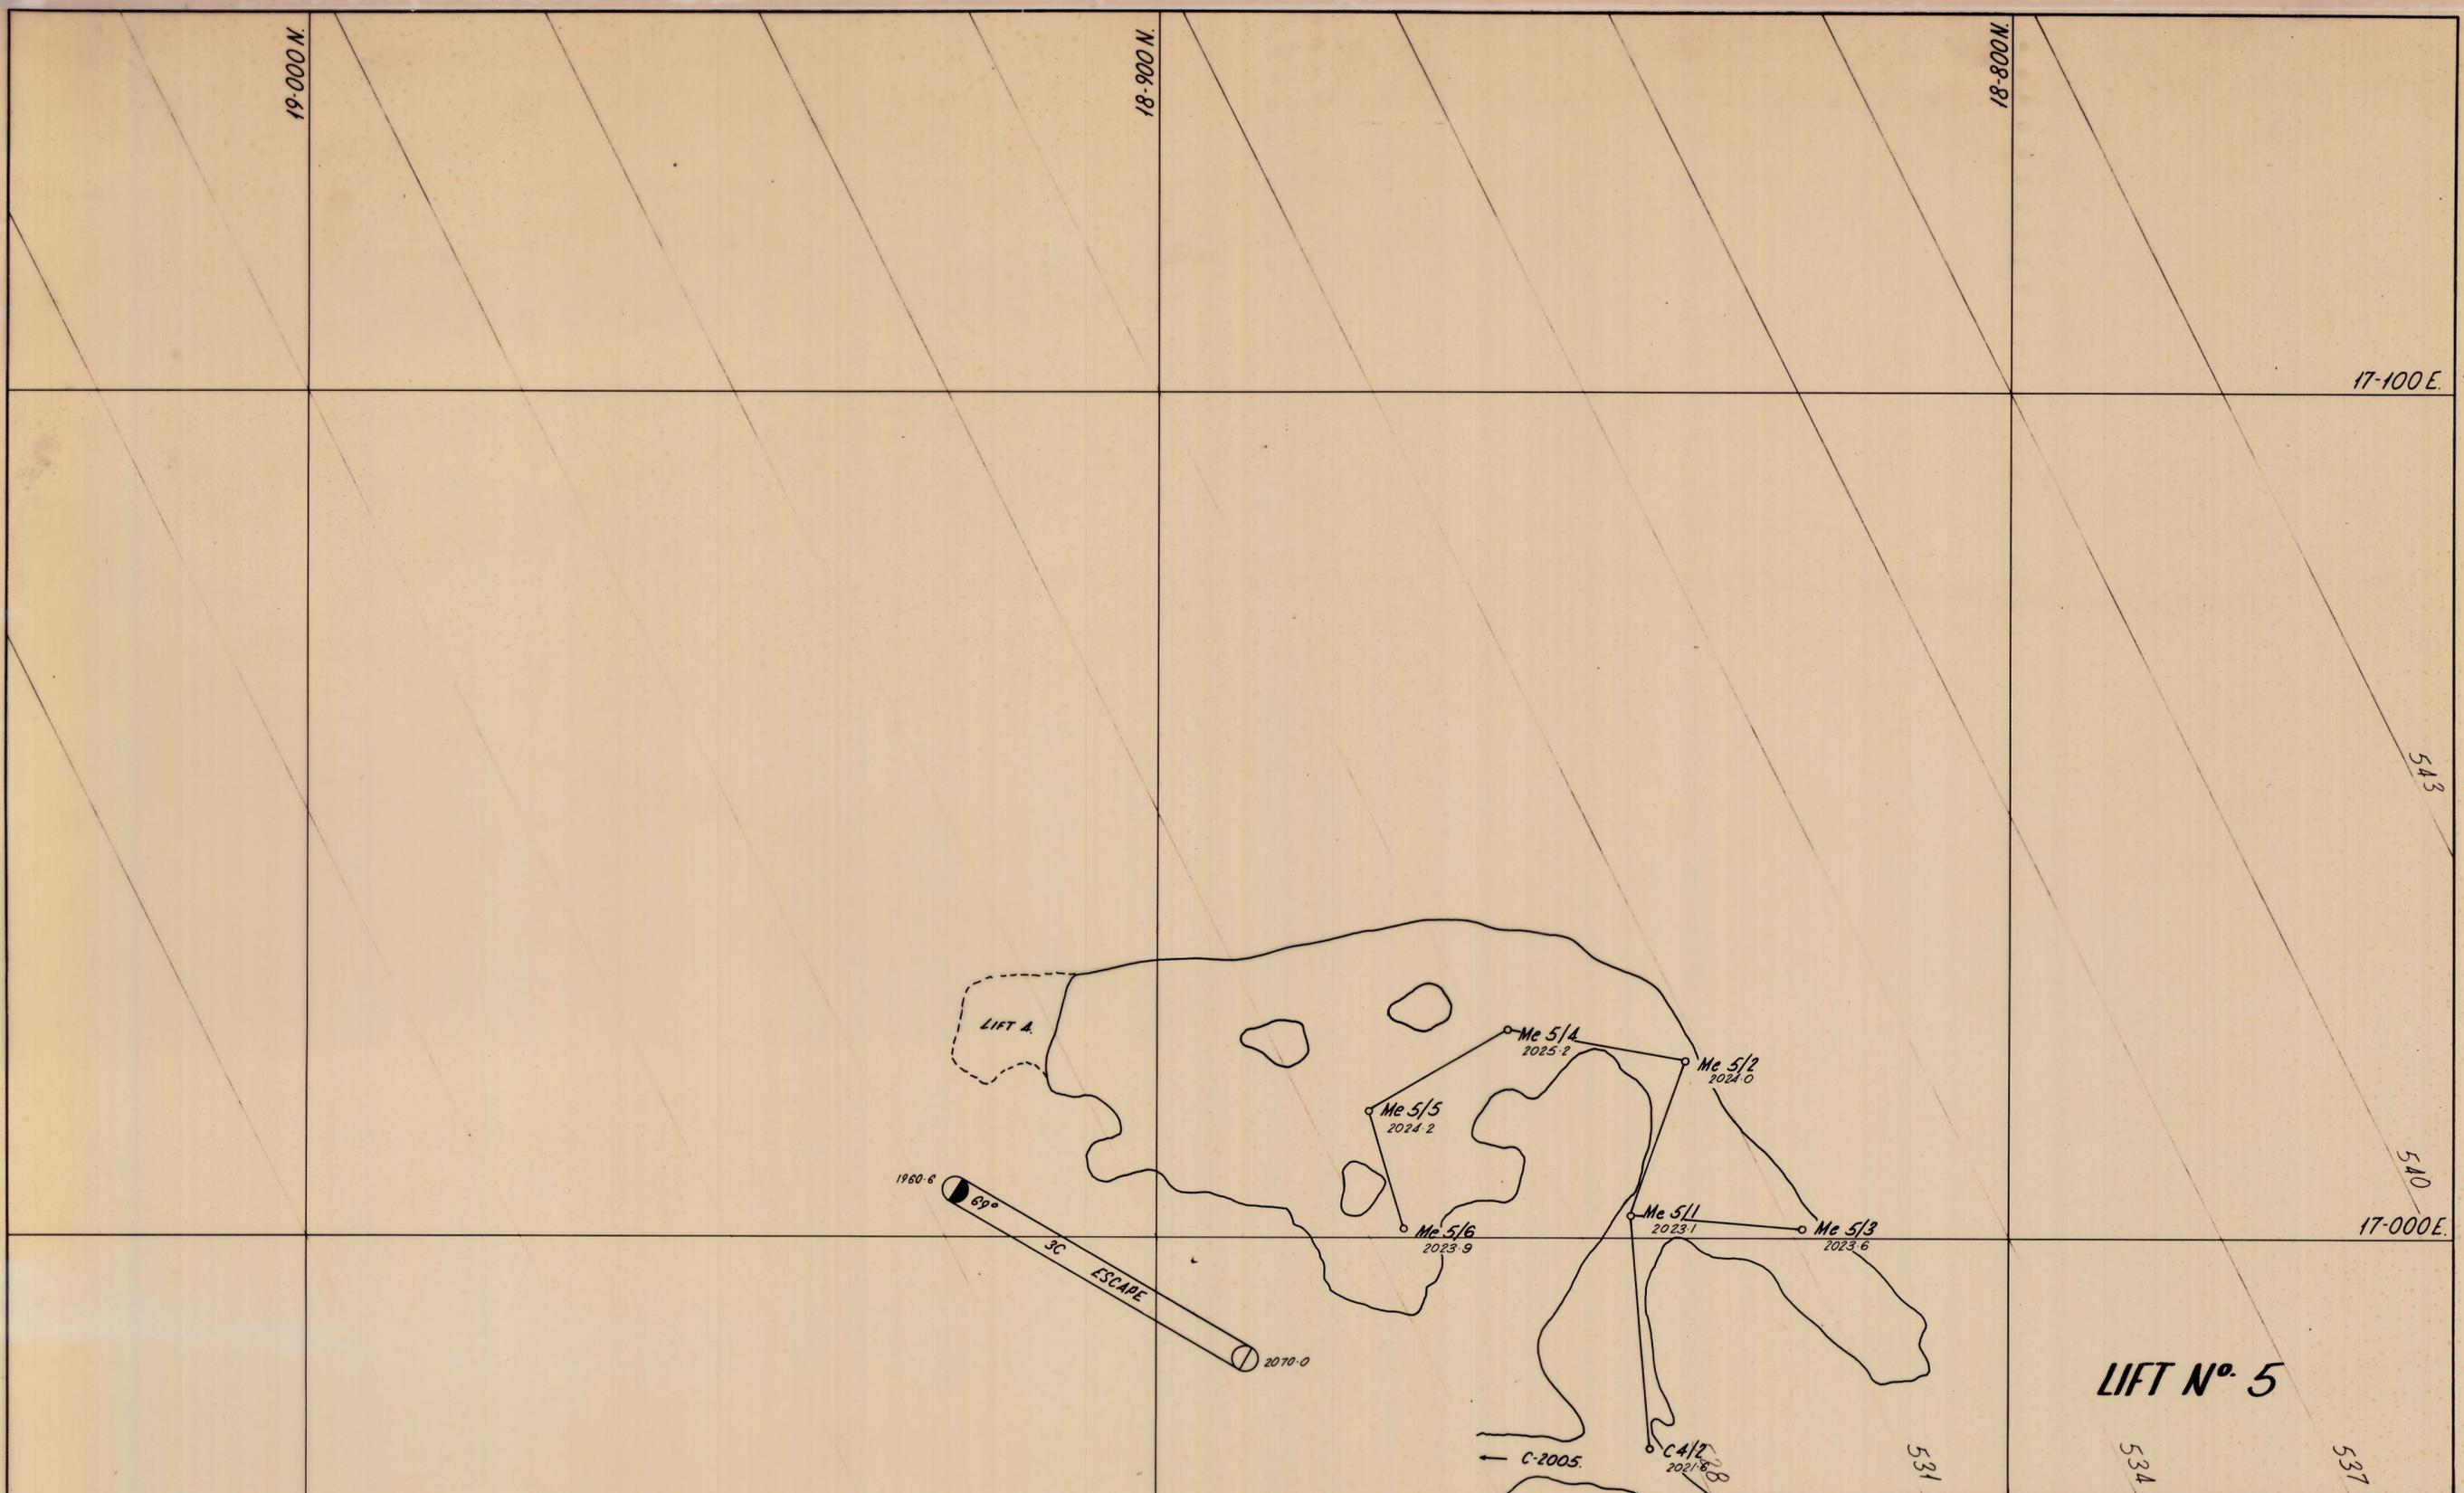

RENISON LIMITED SURVEY			DRAWN PFC. A.J.M.	APPROVED	
			TRACED A.J.M.	CHIEF SURVEYOR	
SURVEY PFC. A.J.M.	DATE 12-8-'81.	SCALE 1:500	CHECKED A.J.M.	Date. 31-12-'82	
2015 MELBA			DRAWING No. 96:005.		
FILL LEVEL: 2021-2			LIFT LEVEL: 2024-2		

83233