

0376-450

19-000 N

18-900 N


18-800 N

17-100 E

543

540

17-000 E

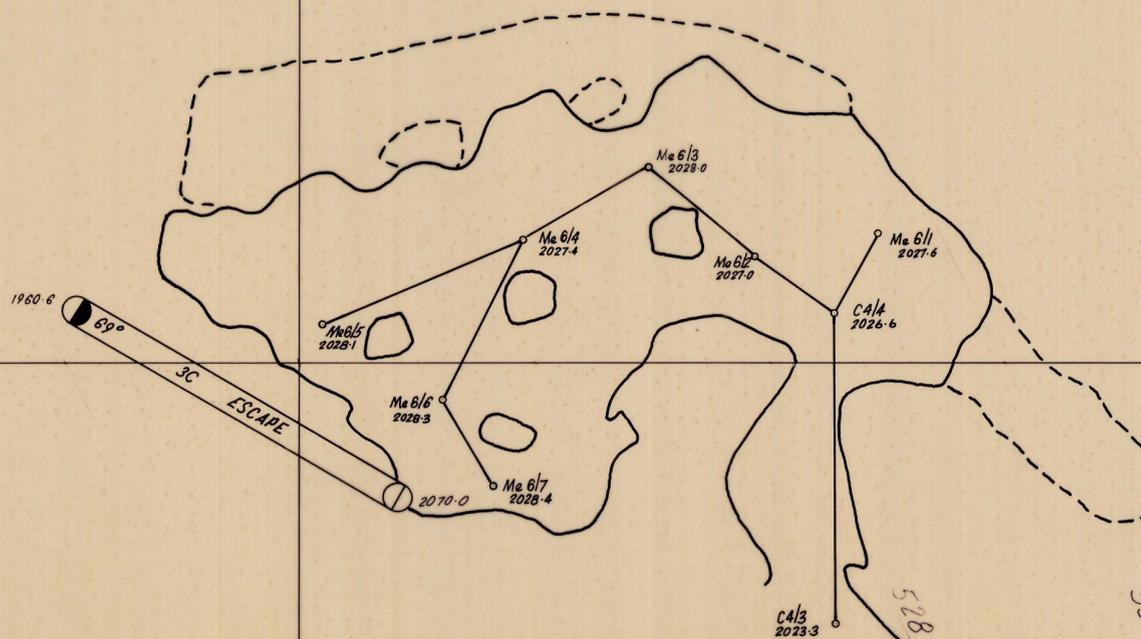

LIFT N° 6

RENISON LIMITED SURVEY			DRAWN	PCM	APPROVED	
			TRACED	RND	 CHIEF SURVEYOR	
SURVEY PGM	DATE 30-4-82	SCALE 1:500	CHECKED	RND	Mine Manager Date: 31-12-82	
<b>2015 MELBA</b> FILL LEVEL : 2024.0 LIFT LEVEL : 2027.6					DRAWING No. 96:006	

5 cm  
 0376-450

83234