


0376-452

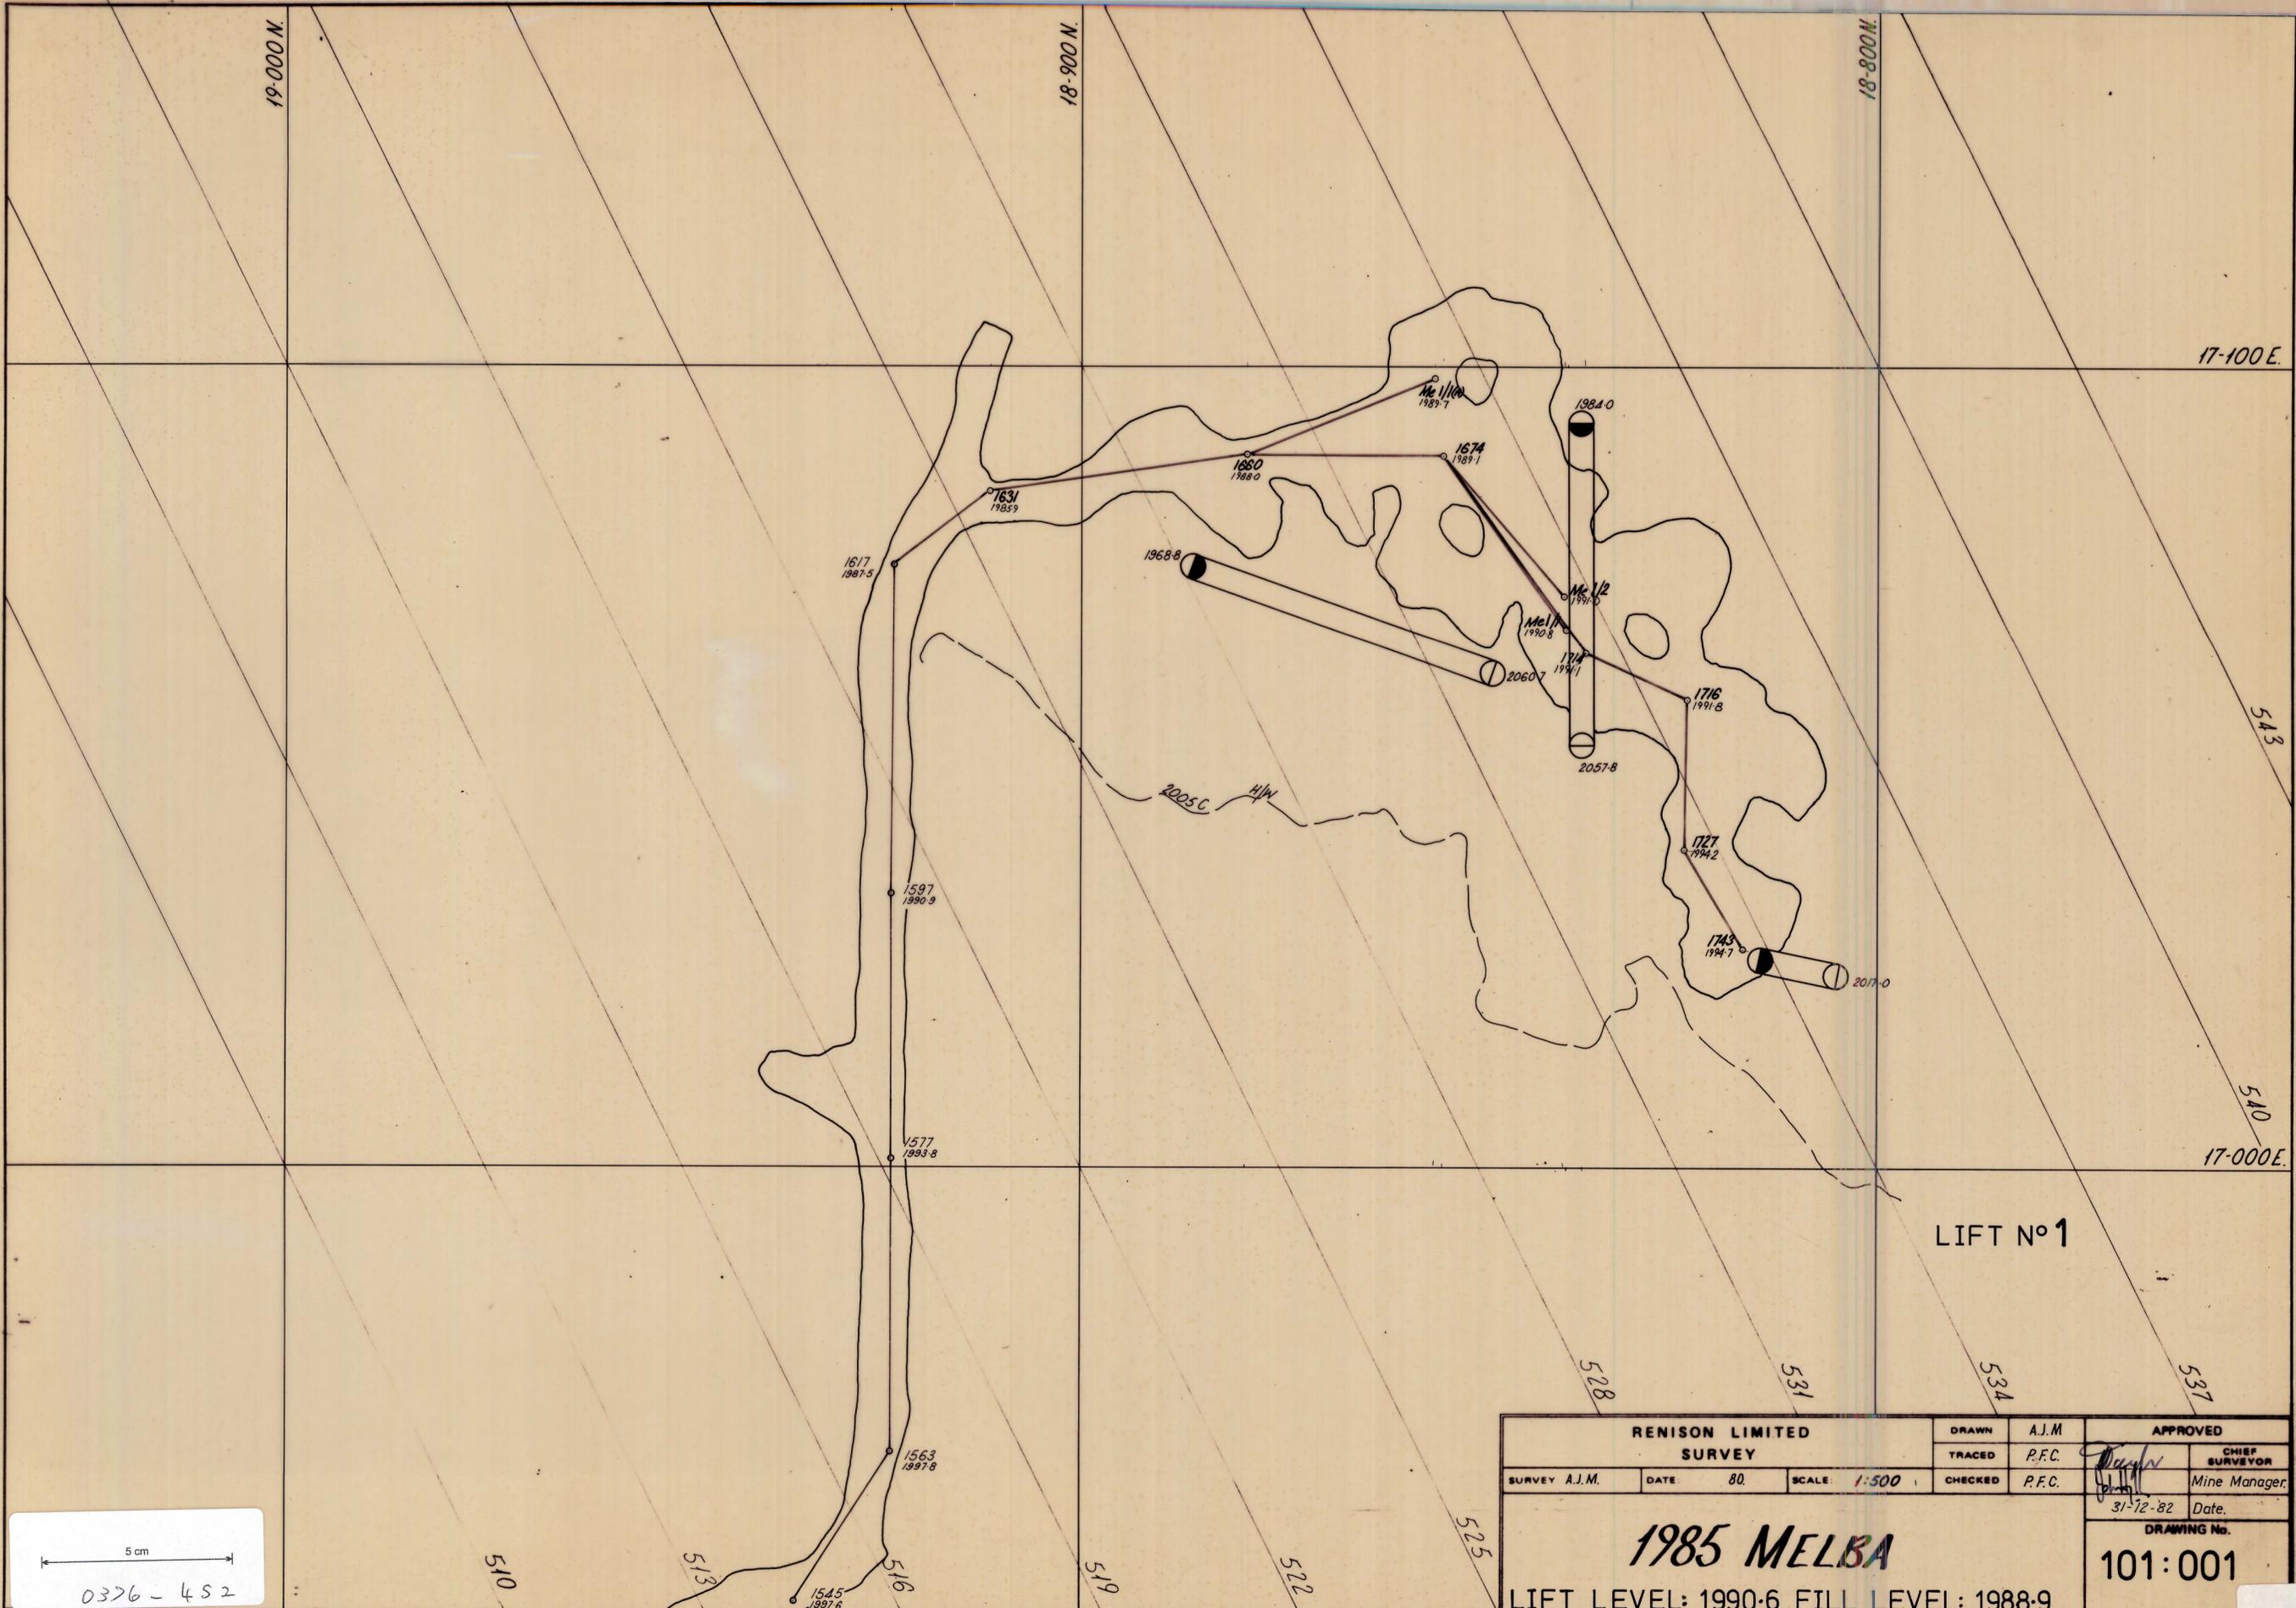

5 cm
0376-452

RENISON LIMITED SURVEY			DRAWN A.J.M.	APPROVED	
SURVEY A.J.M.	DATE	SCALE	TRACED	P.F.C.	CHIEF SURVEYOR
	80	1:500	CHECKED	P.F.C.	Mine Manager
<h1>1985 MELBA</h1> <p>LIFT LEVEL: 1990.6 FILL LEVEL: 1988.9</p>					<p>31-72-82 Date.</p> <p>DRAWING No.</p> <h2>101:001</h2>
					<p>83236</p>