
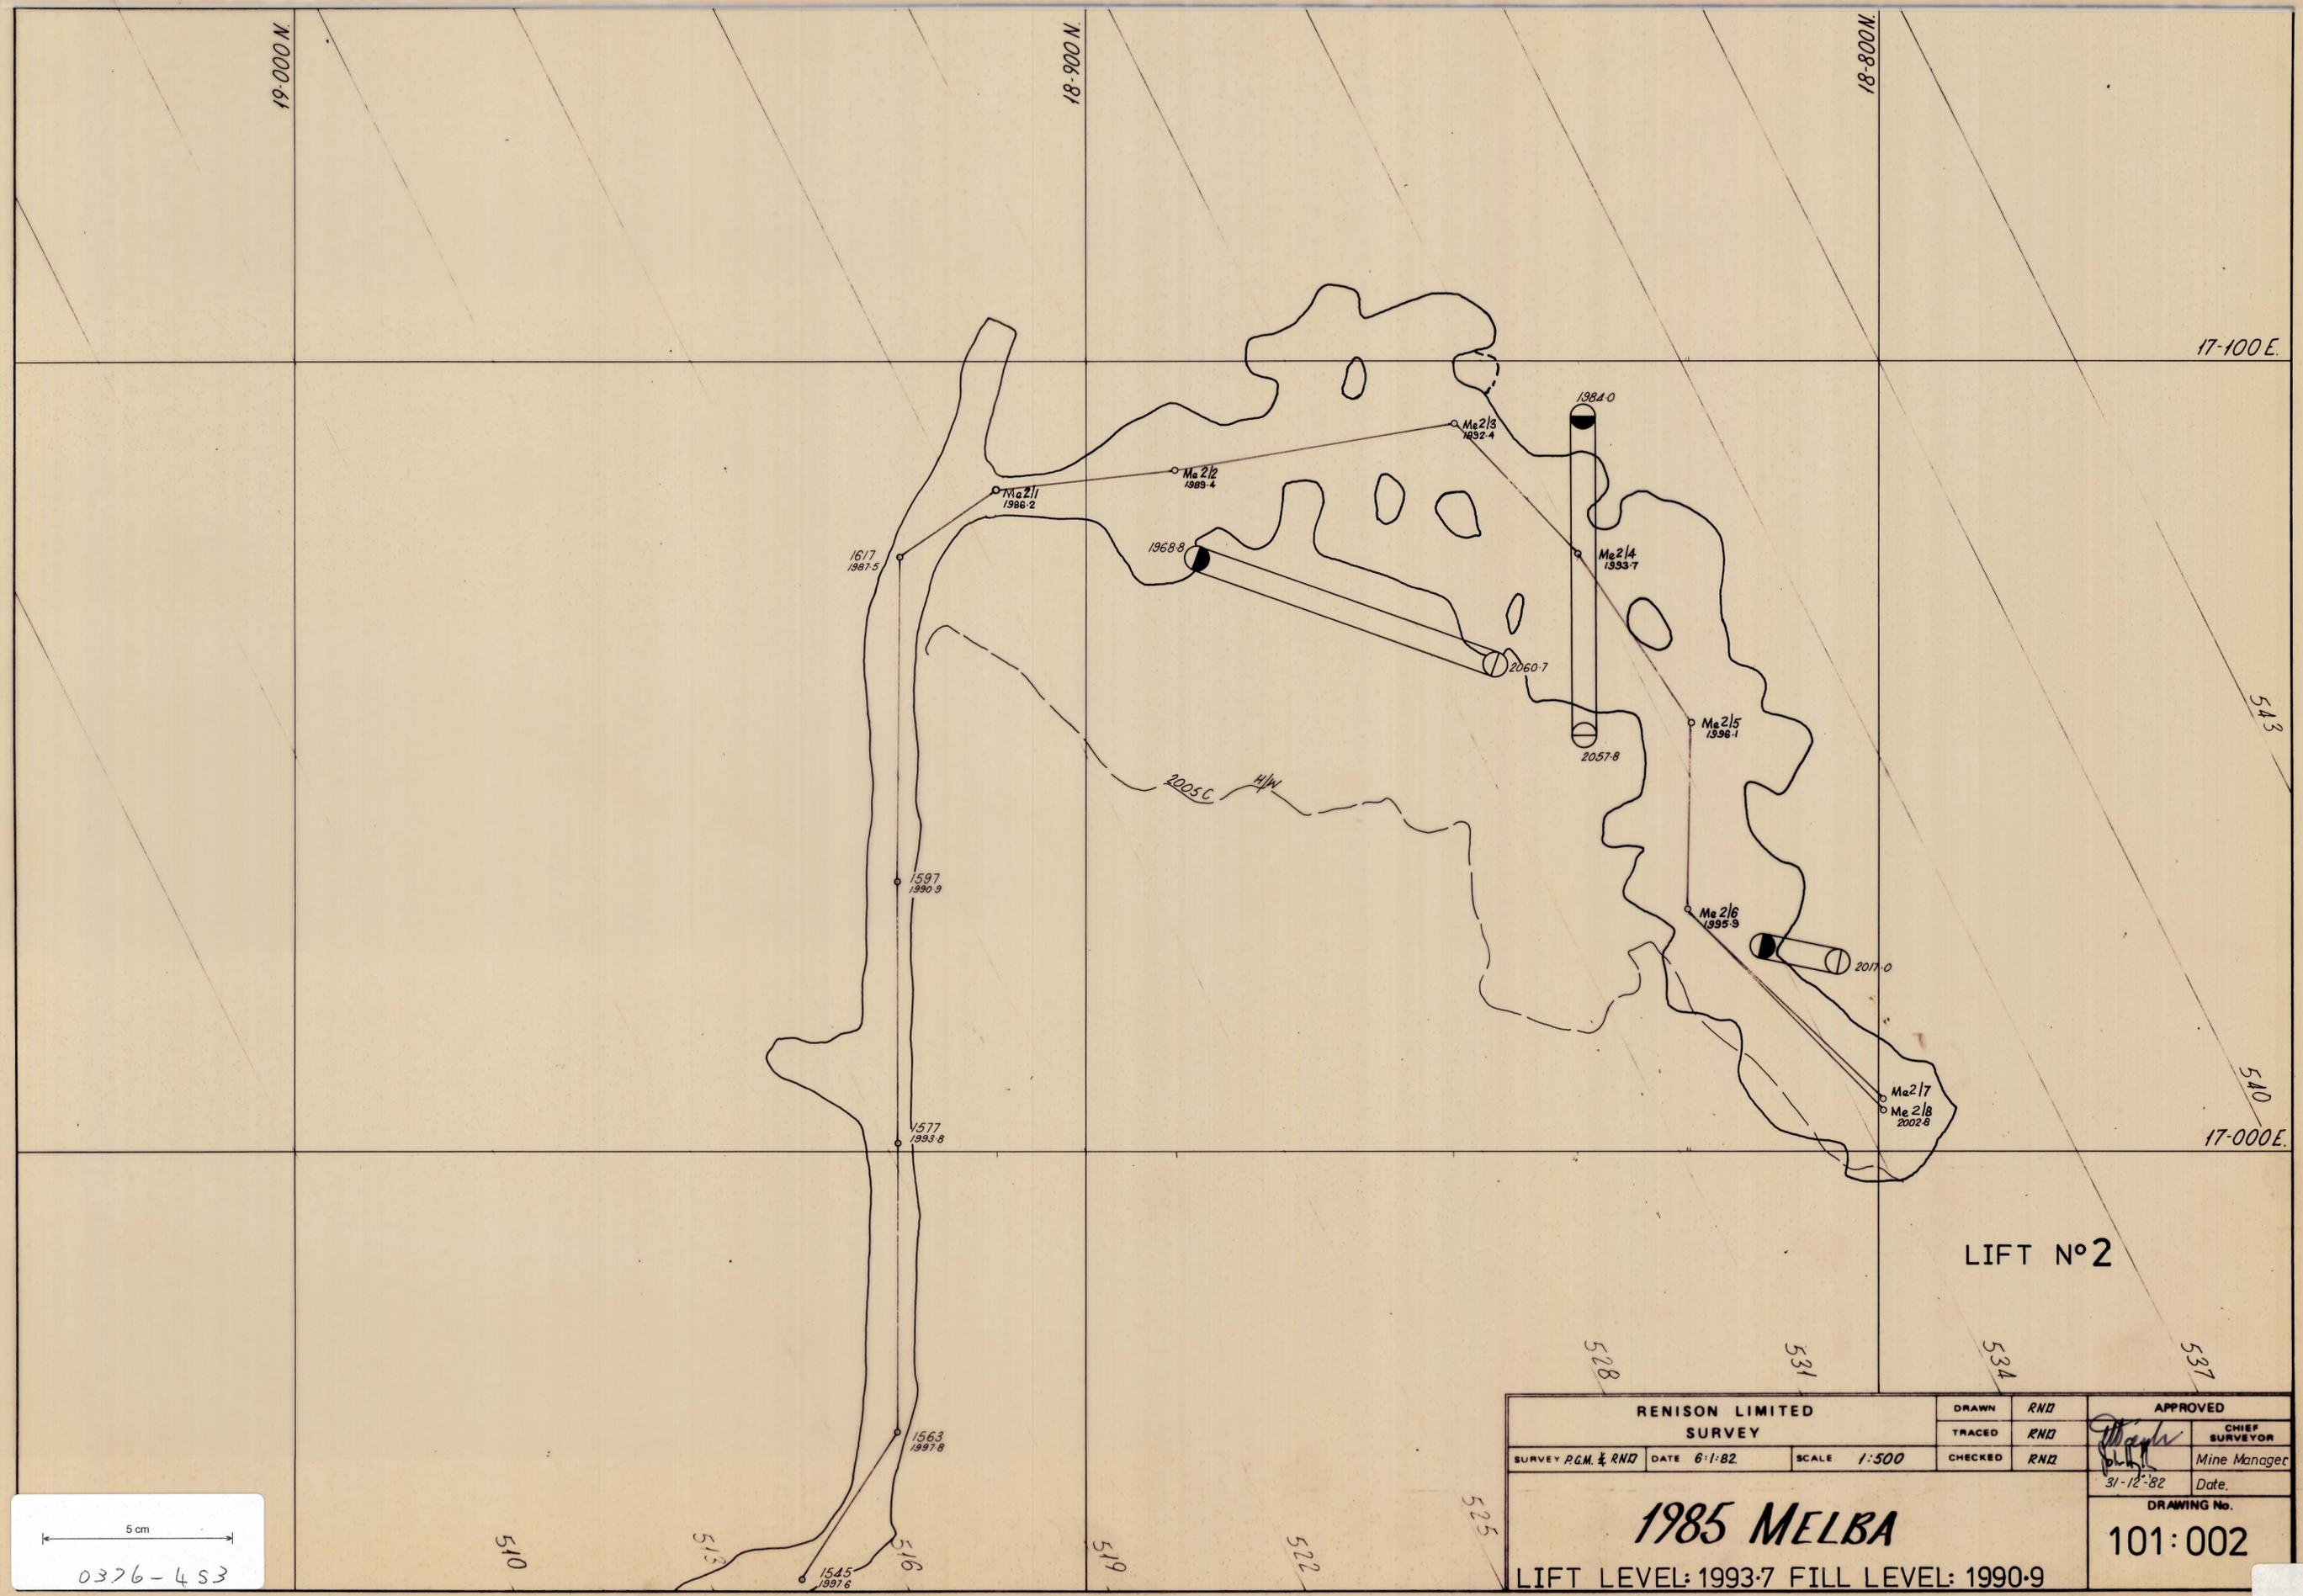


0376-453

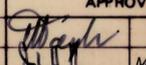

5 cm
0376-453

RENISON LIMITED SURVEY			DRAWN	RNZ	APPROVED	
			TRACED	RNZ	 CHIEF SURVEYOR	
SURVEY P.G.M. & RNZ	DATE 6-1-82	SCALE 1:500	CHECKED	RNZ	Mine Manager Date 31-12-82	
1985 MELBA					DRAWING No.	
LIFT LEVEL: 1993.7 FILL LEVEL: 1990.9					101:002	

83237