


0376-454

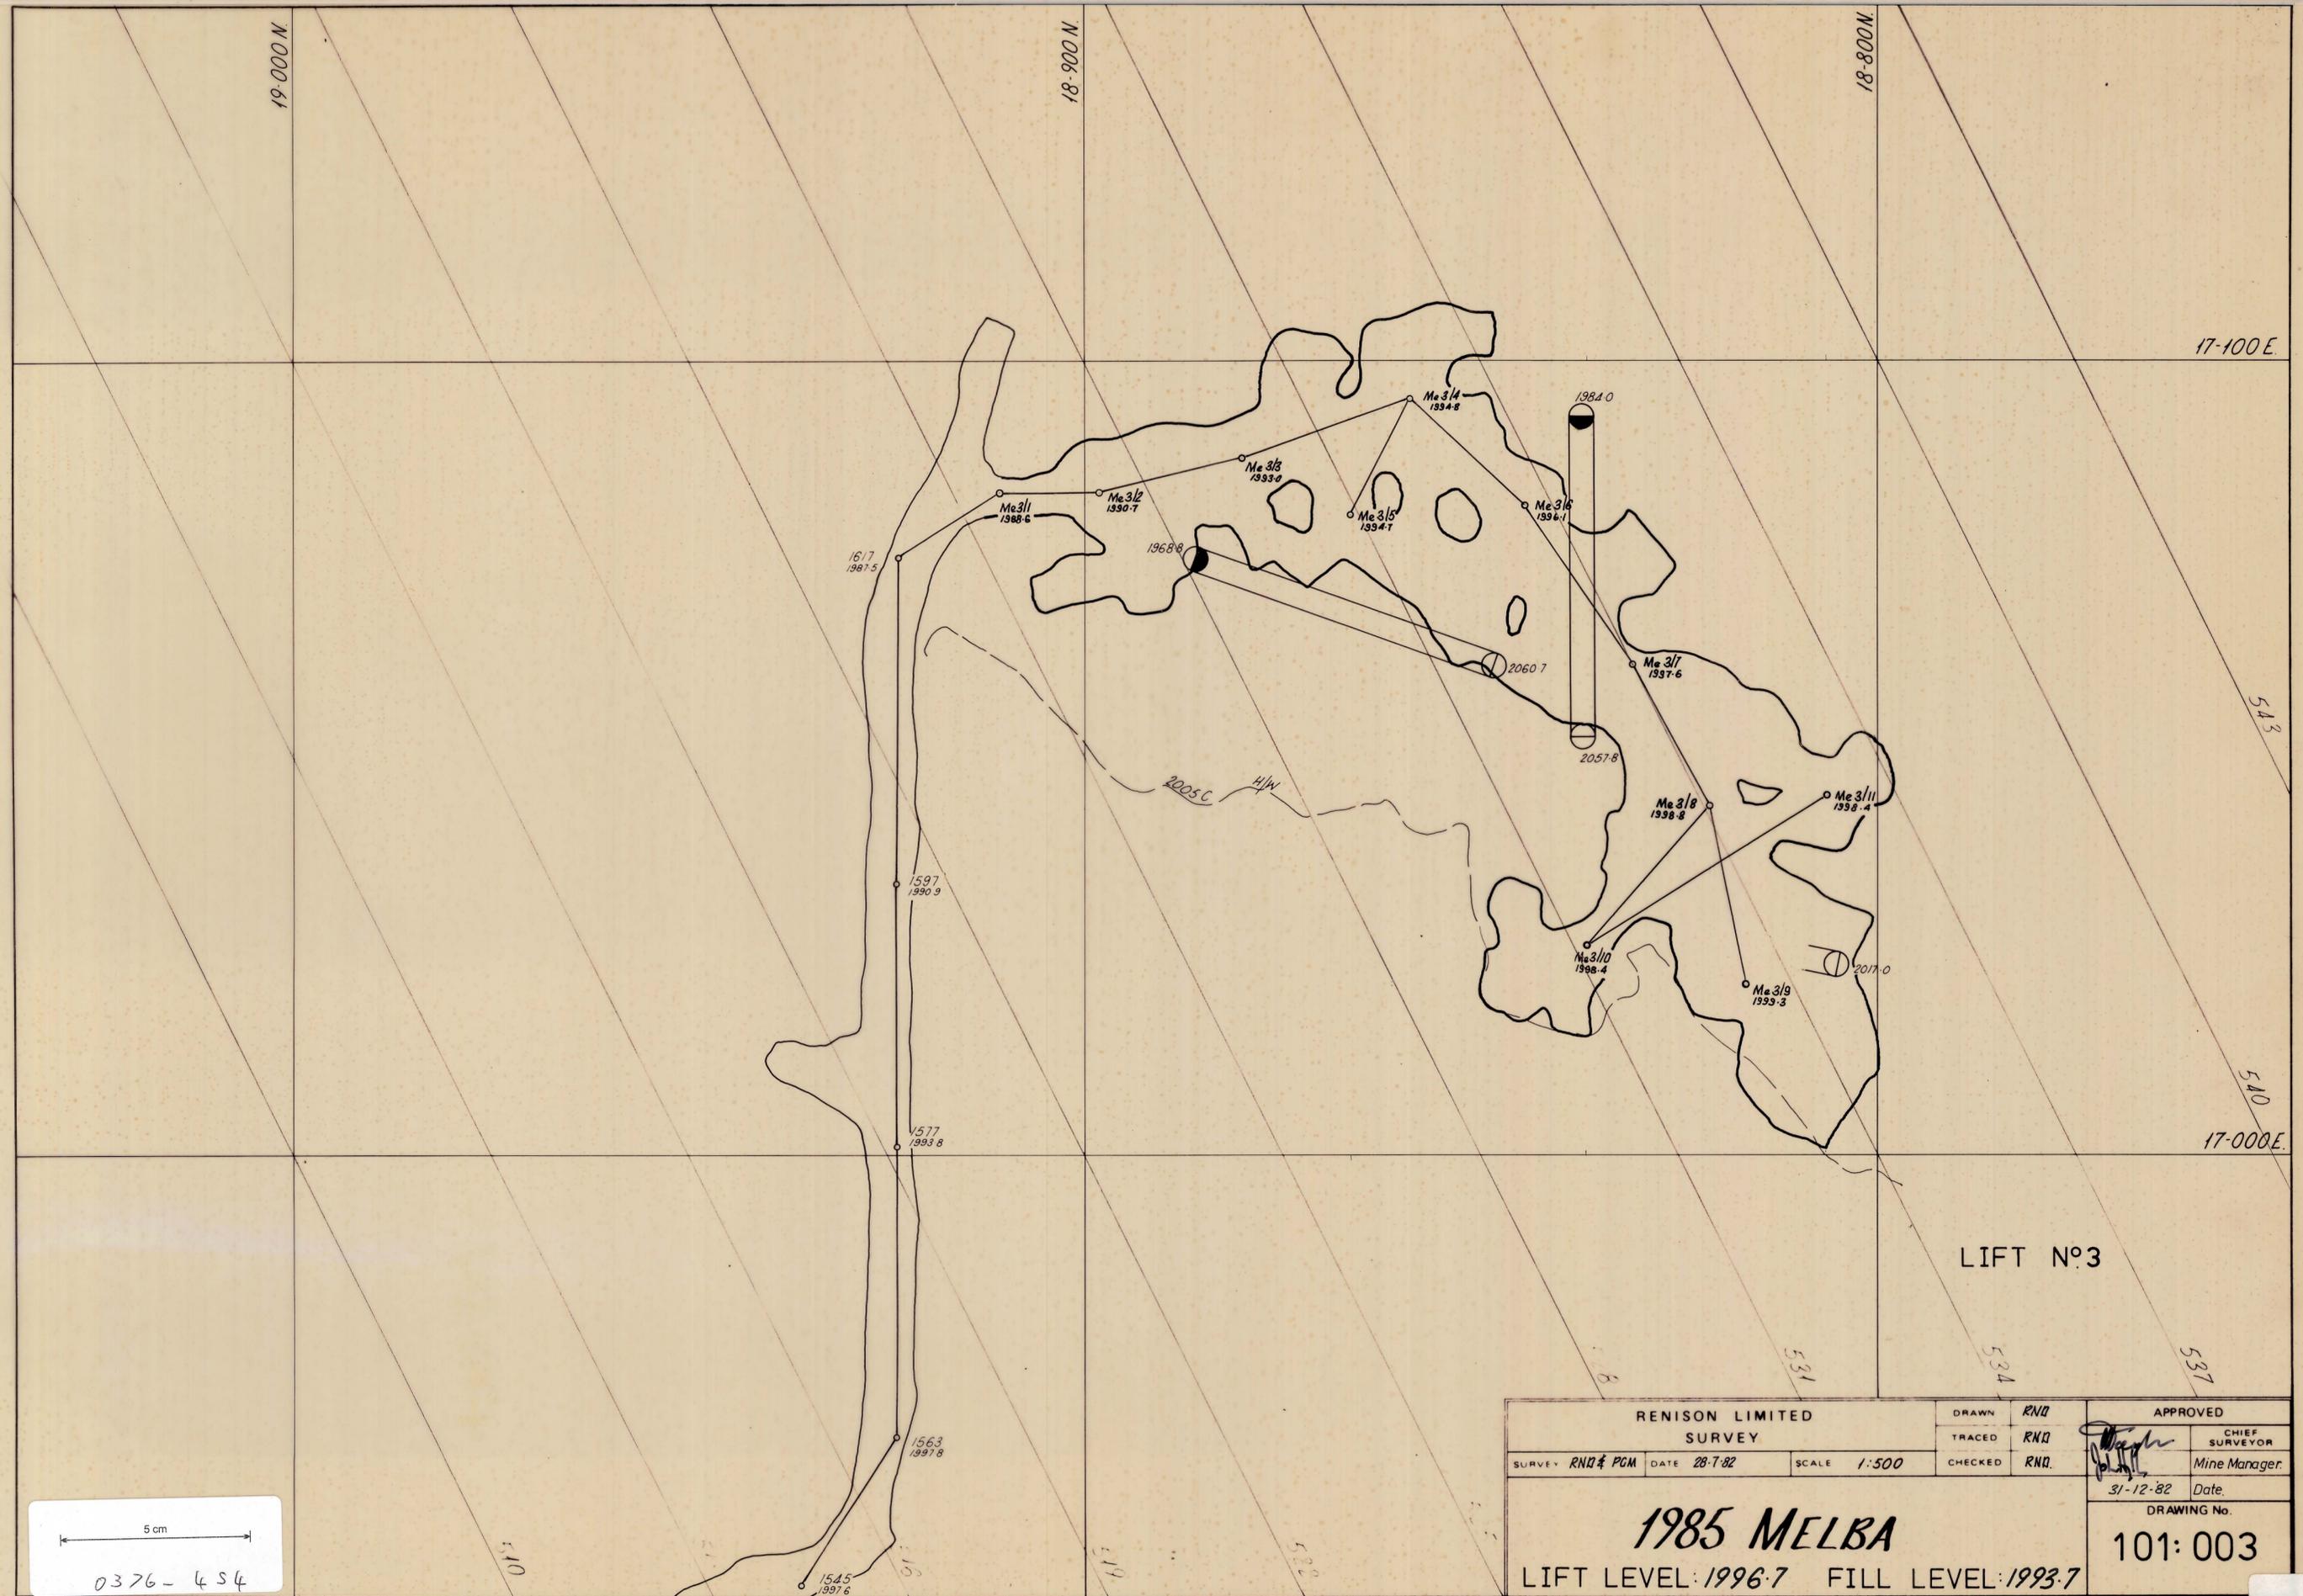

5 cm
0376-454

RENISON LIMITED SURVEY			DRAWN RND	APPROVED	
			TRACED RND	CHIEF SURVEYOR	
SURVEY RND & PGM	DATE 28-7-82	SCALE 1:500	CHECKED RND	Mine Manager.	
1985 MELBA LIFT LEVEL: 1996.7 FILL LEVEL: 1993.7			31-12-82 Date.		
			DRAWING No. 101:003		

83238