


0376-455

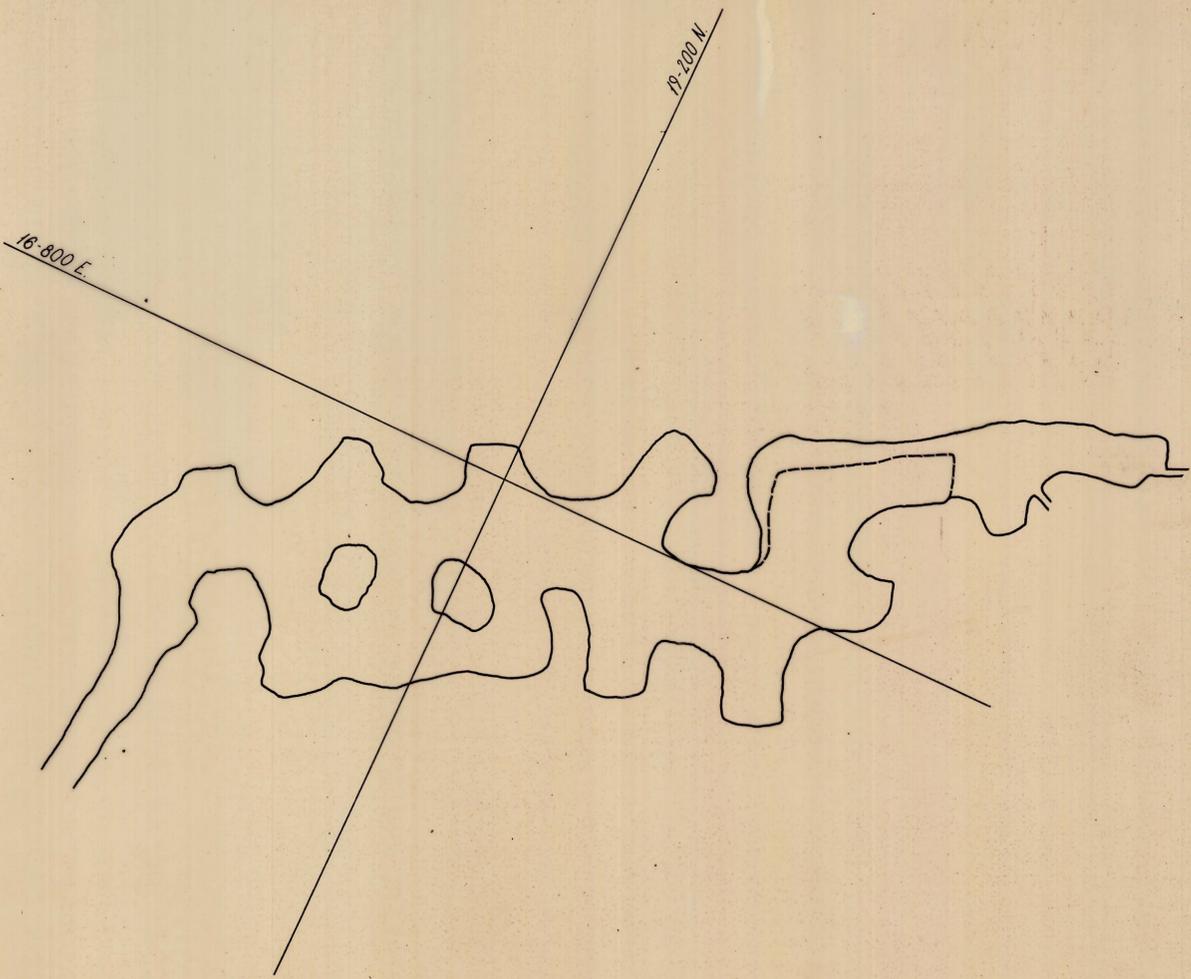

5 cm

0376-455

DATE	MANAGER	SURVEYOR	RENISON LIMITED SURVEY.		DRAWING No.
31-12-78	<i>[Signature]</i>	<i>[Signature]</i>	DRAWN F.M.H.	DATE 17-2-77	68:014.
31-12-82	<i>[Signature]</i>	<i>[Signature]</i>	SCALE 1:500.		
			2075 MURCHISON STOPE.		
			LEVEL: 2081.		

83150