


0376 - 463



MASTEAF.PF

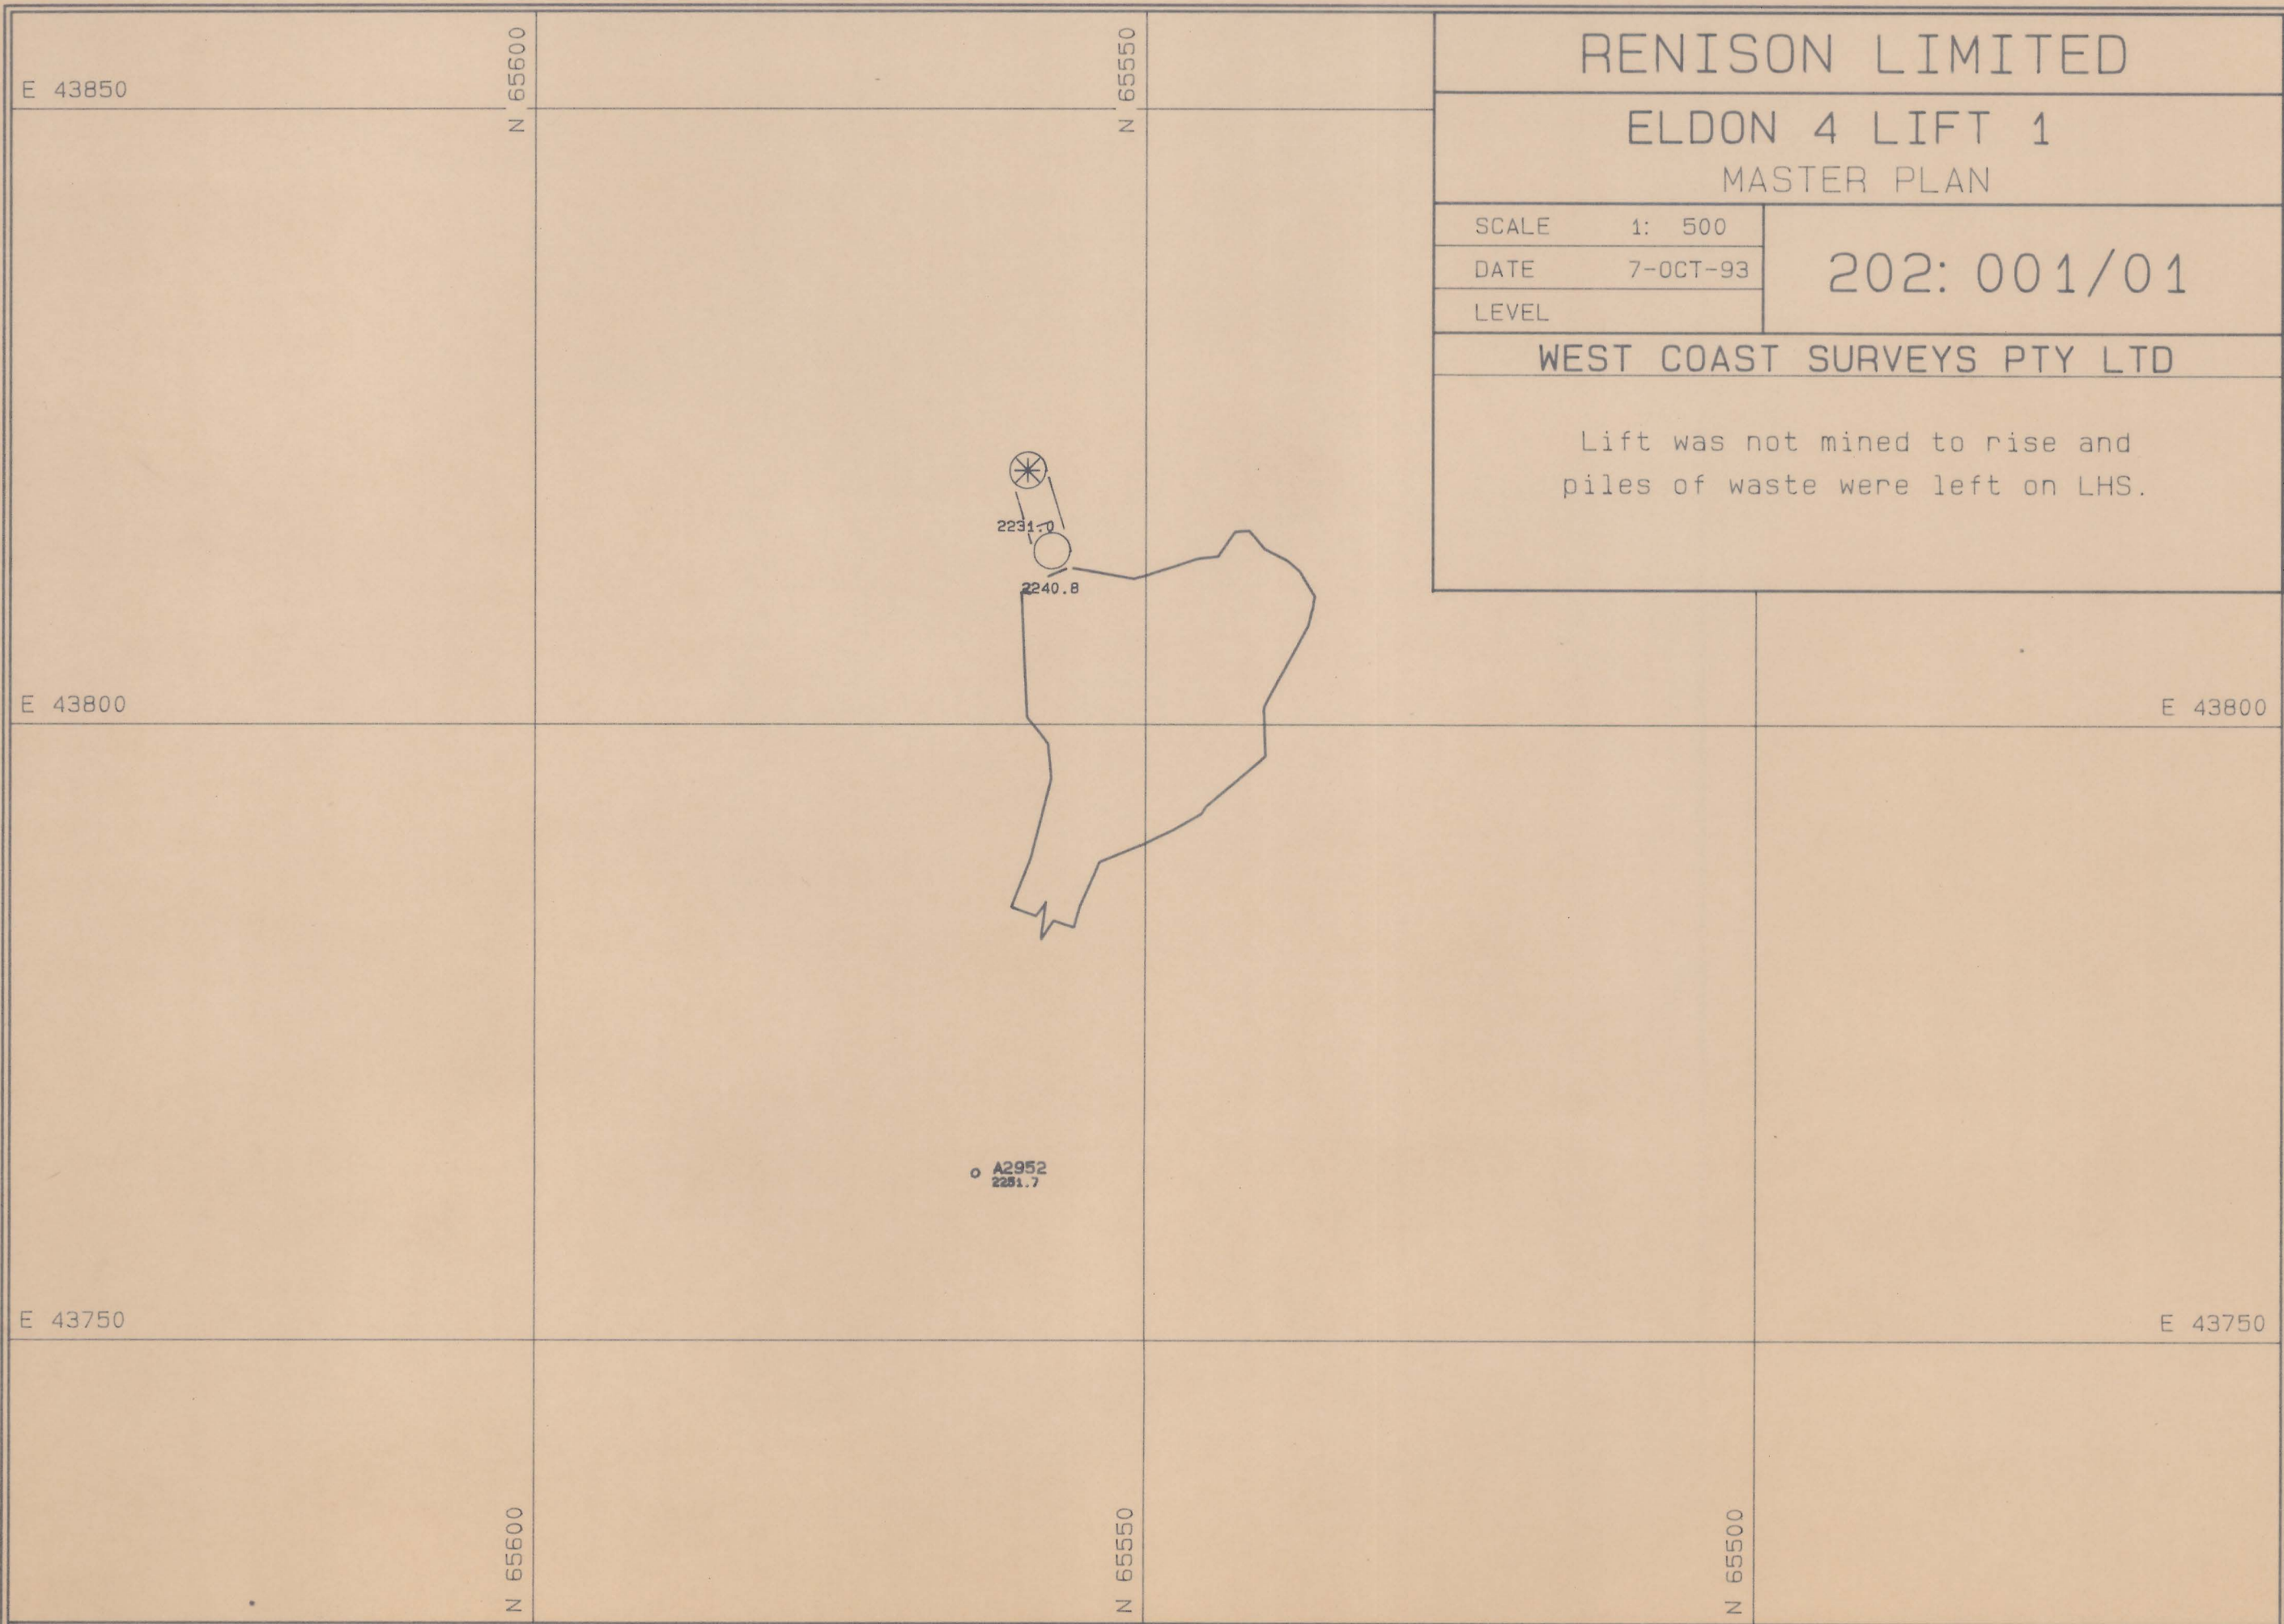