
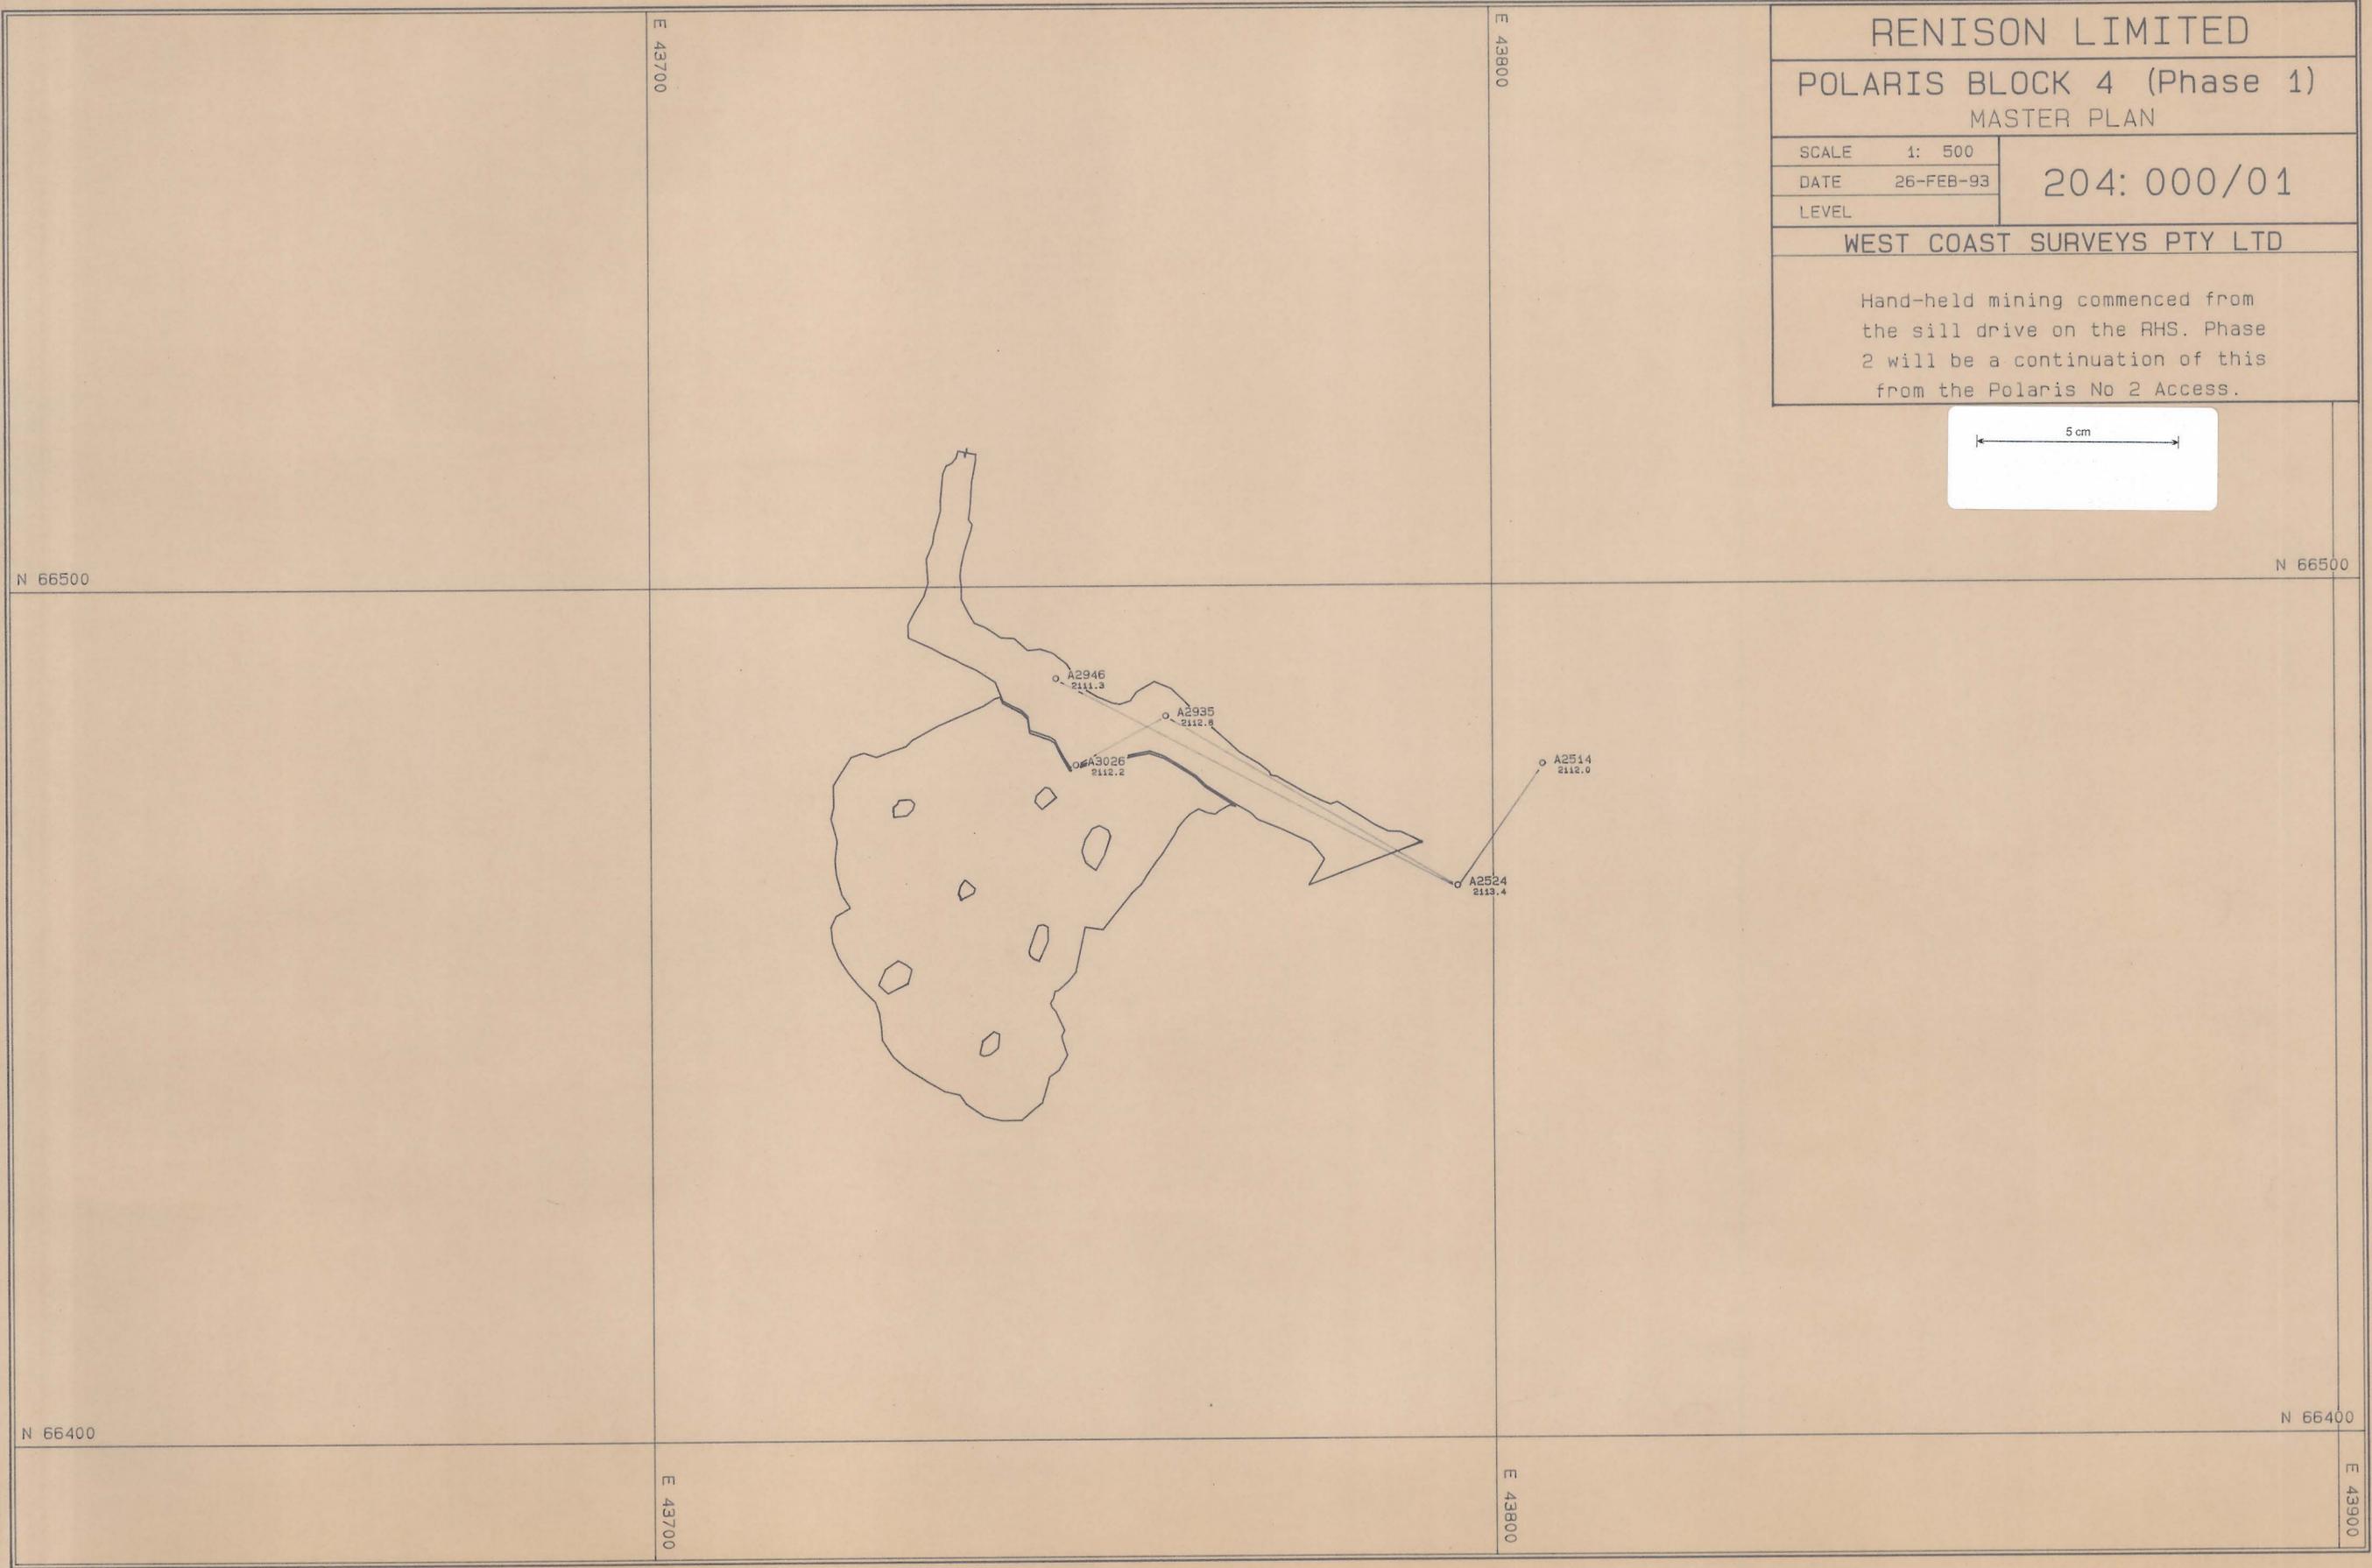


0376-464

<b>RENISON LIMITED</b>	
<b>POLARIS BLOCK 4 (Phase 1)</b>	
<b>MASTER PLAN</b>	
SCALE 1: 500	<b>204: 000/01</b>
DATE 26-FEB-93	
LEVEL	
<b>WEST COAST SURVEYS PTY LTD</b>	
<p>Hand-held mining commenced from the sill drive on the RHS. Phase 2 will be a continuation of this from the Polaris No 2 Access.</p>	

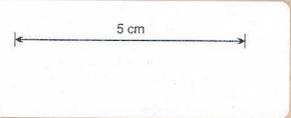

MASTEAF.PF