

0376-465


RENISON LIMITED
PIEMAN 4 SILL DRIVE
MASTER PLAN

SCALE 1: 500
DATE 24-FEB-93
LEVEL

203: 000/01

WEST COAST SURVEYS PTY LTD

This sill drive was mined from
the Pieman access, deliberately
breaking into the NE Pieman
access.

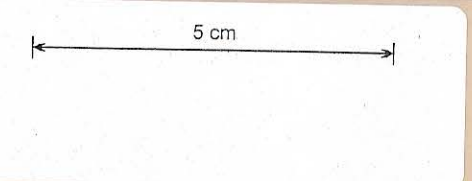

N 65800

E 43900

E 44000

E 43900

E 44000

N 65700

N 65700

