


NISON LIM I. WFST ARGENT LIFT 3 MASTER PLAN

SCALE	1: 500
DATE	6-MAY-93
LEVEL	ARW

129: 003/01
WEST COAST SURVEYS PTY LTD

Final lift before airleg mining.
Note that the drive straight ahead to the rise was SILLING, and hts shown are FLOOR HEIGHTS.

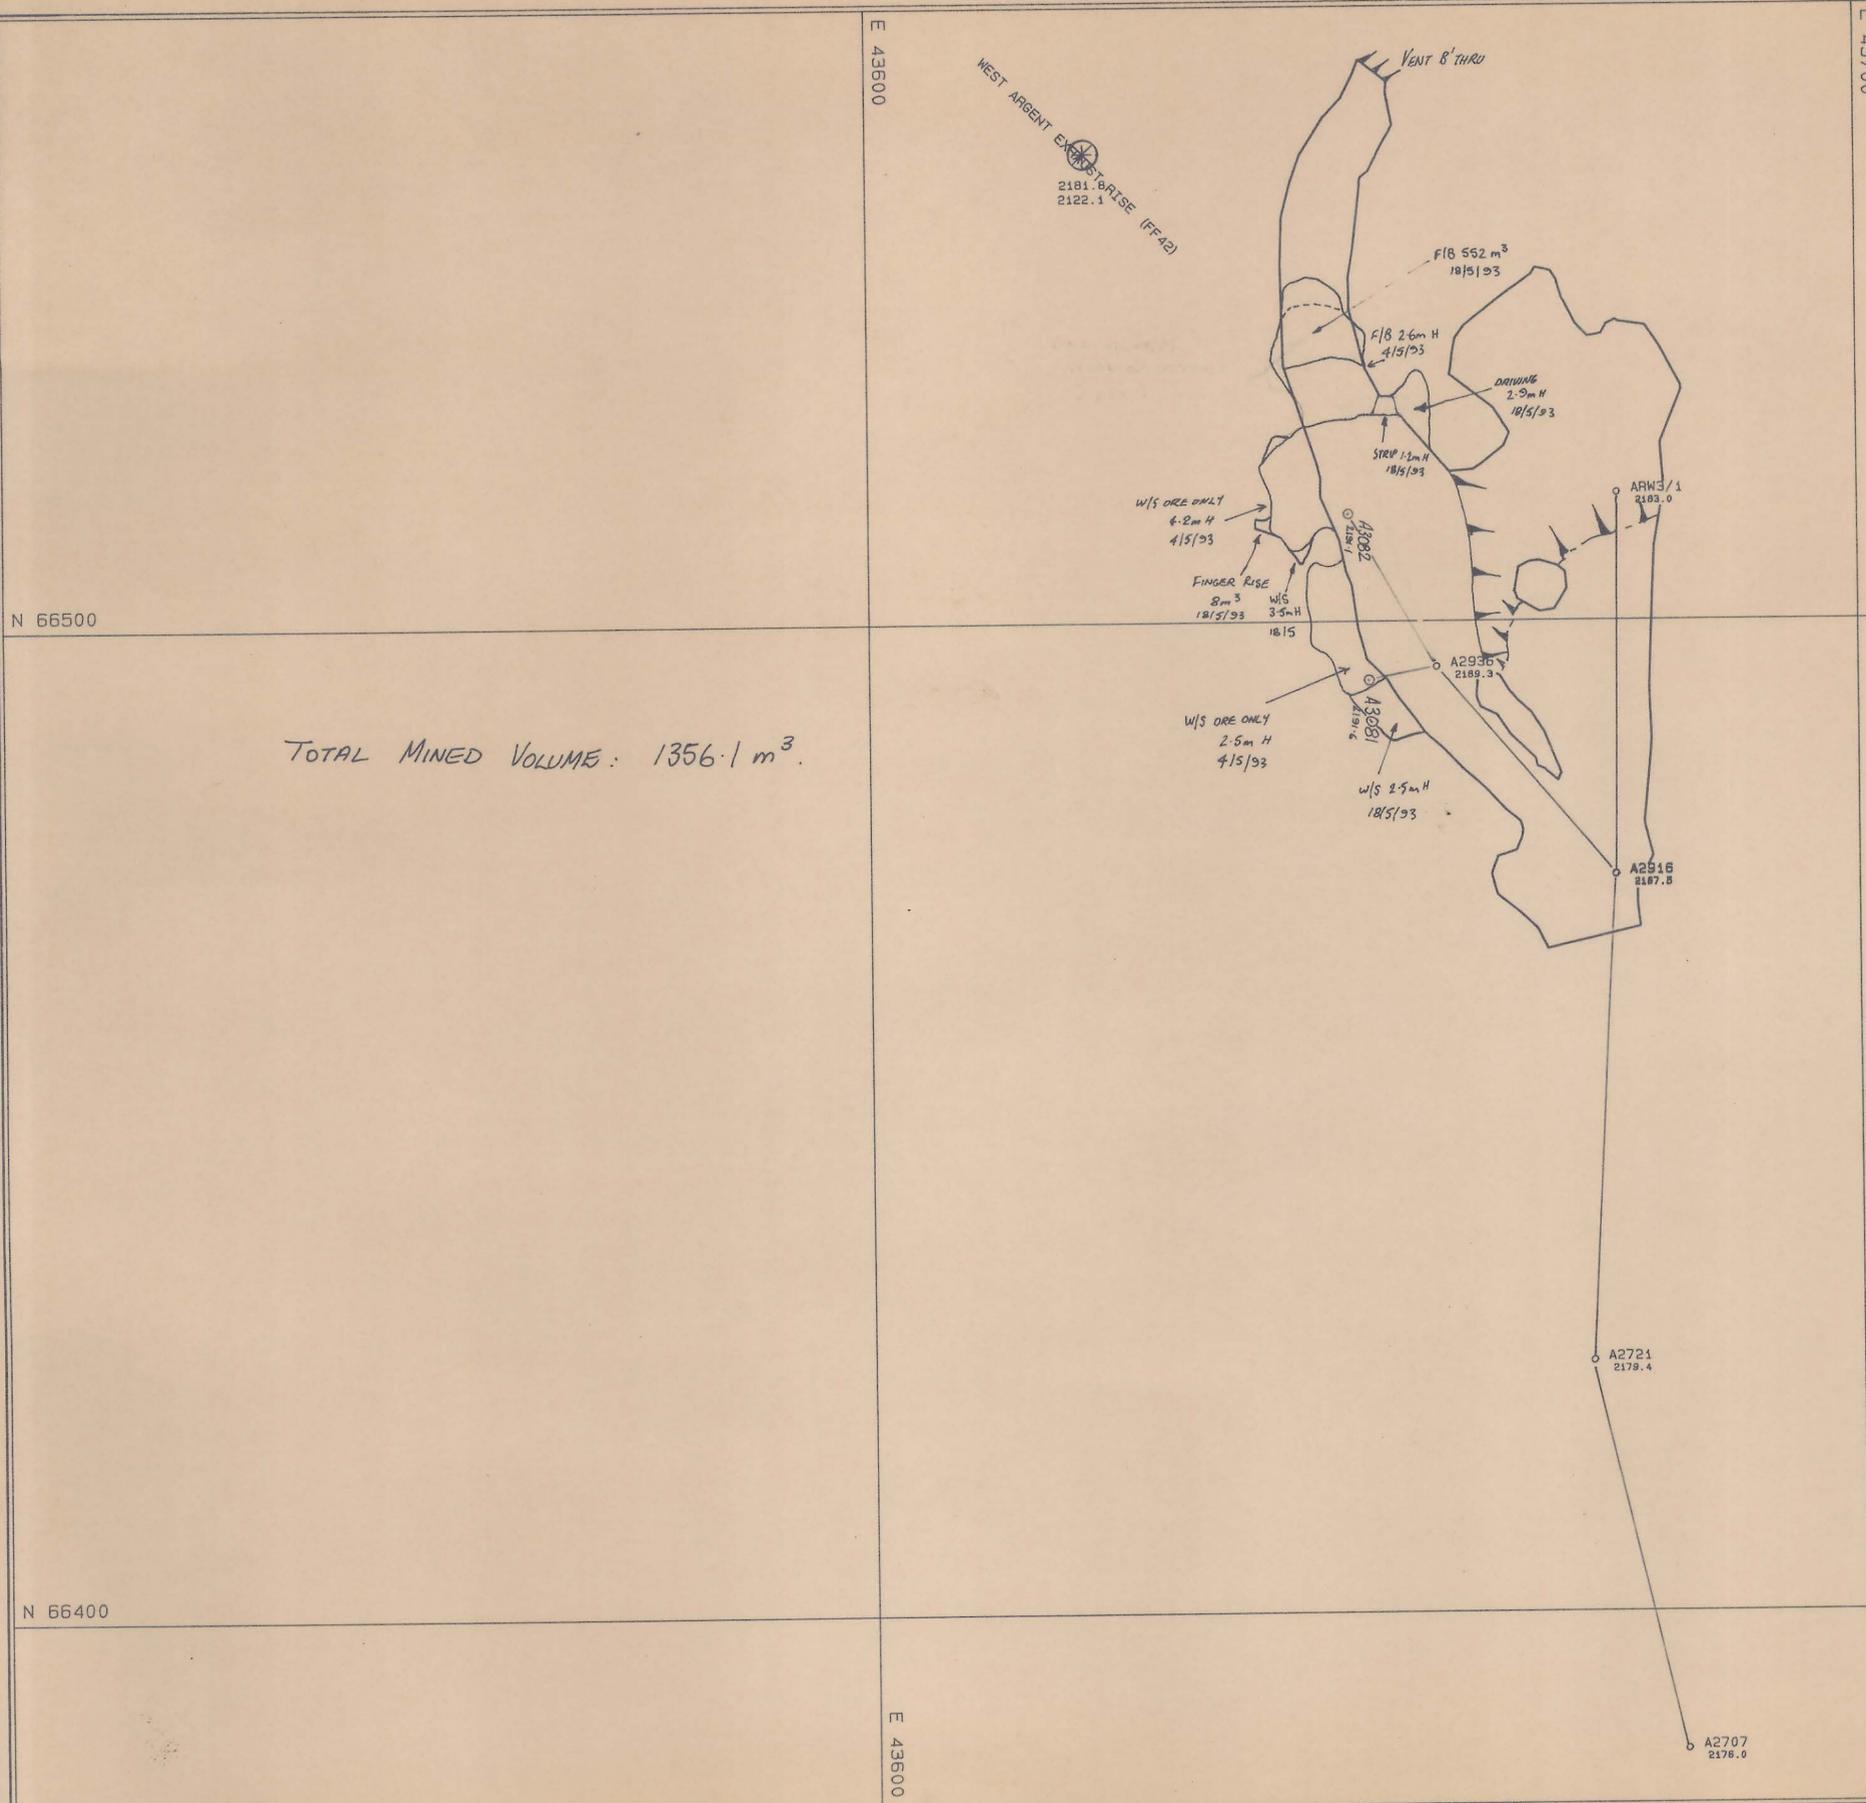

TOTAL MINED VOLUME: 1356.1 m³.

FINAL WORKING PLAN.
FILE CLOSED ON 2/6/93.
SEE LIFT 3A CONTOUR PLAN

N 66500

N 66400