


0376-467

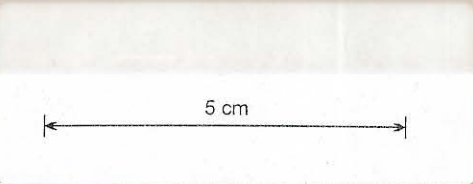


RENISON LIMITED
WEST ARGENT LIFT 3
MASTER PLAN

SCALE	1: 500
DATE	6-MAY-93
LEVEL	ARW

129: 003/01

WEST CCAST SURVEYS PTY LTD

Final lift before airleg mining.
Note that the drive straight
ahead to the rise was SILLING,
and hts shown are FLOOR HEIGHTS.

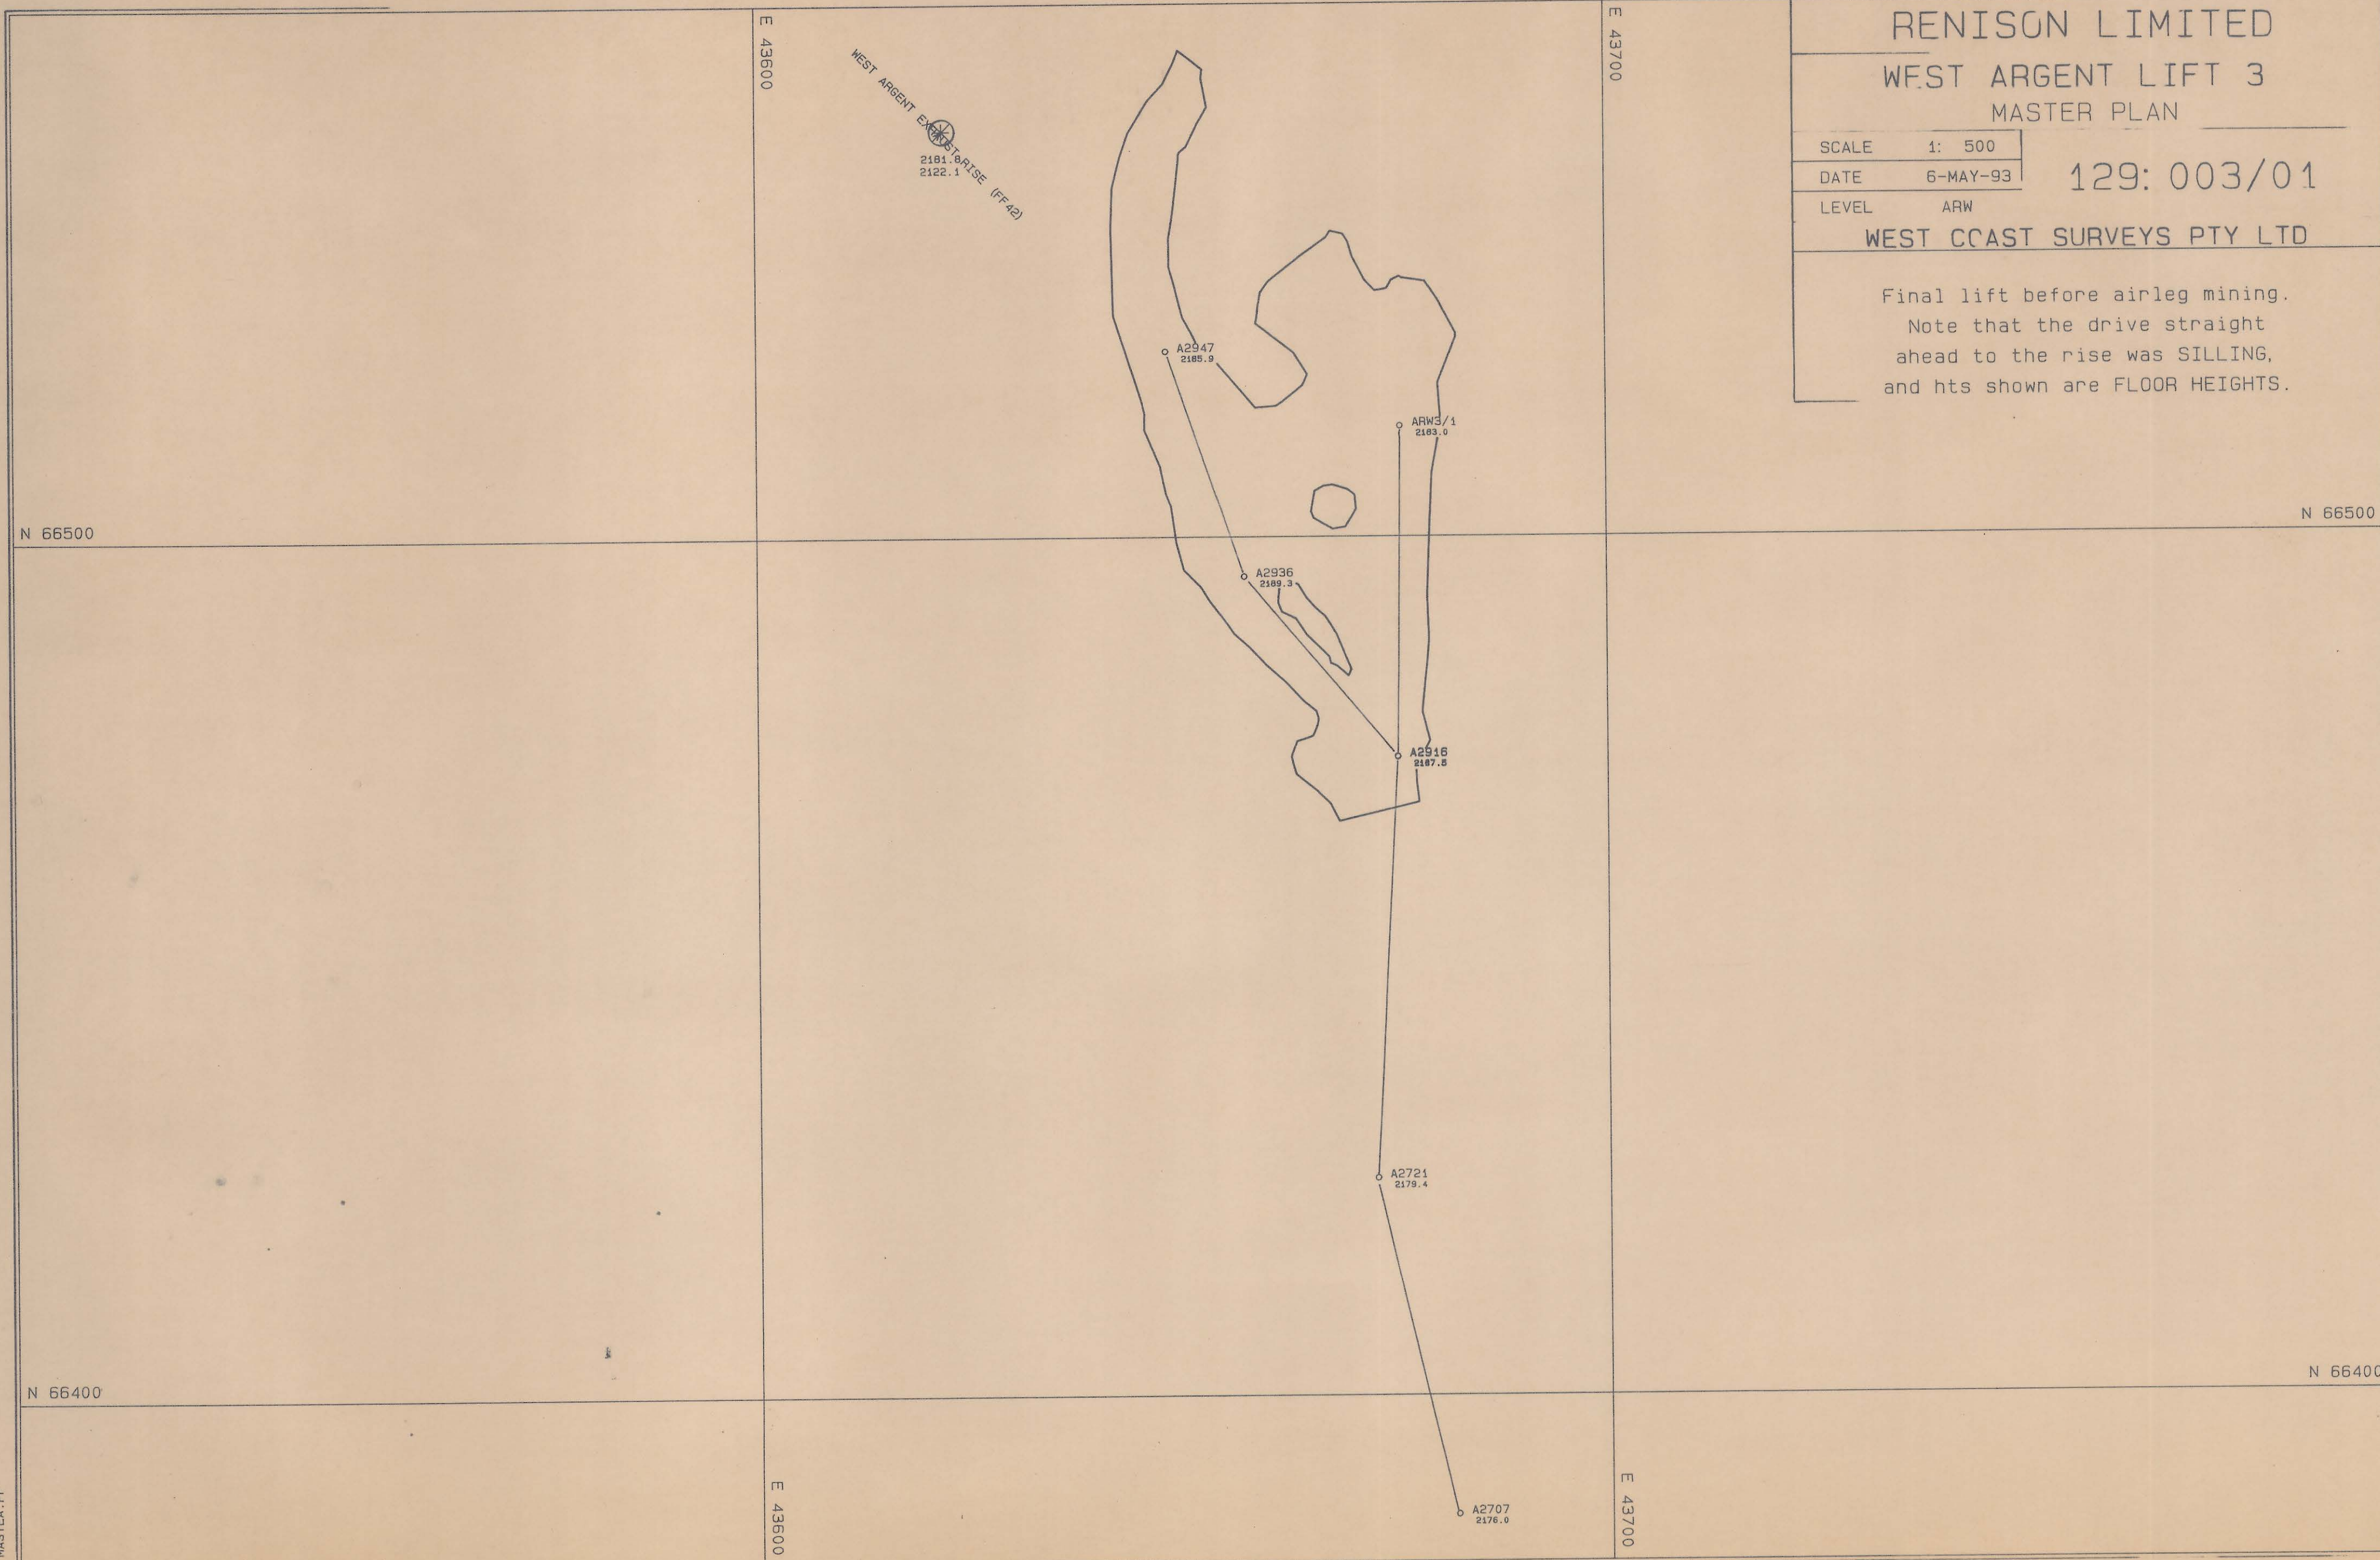

MASTEAF