

0376-468

5 cm

RENISON LIMITED

HOWARD 2000 BLOCK 2 SILL
MASTER PLAN

SCALE 1: 500


DATE 3-MAR-93

LEVEL

105: 010/01

WEST COAST SURVEYS PTY LTD

This plan shows lift 10 (LHS of access) and block 2 sill (RHS of access). No fill was placed.
Note vent b/thru to Ho2035

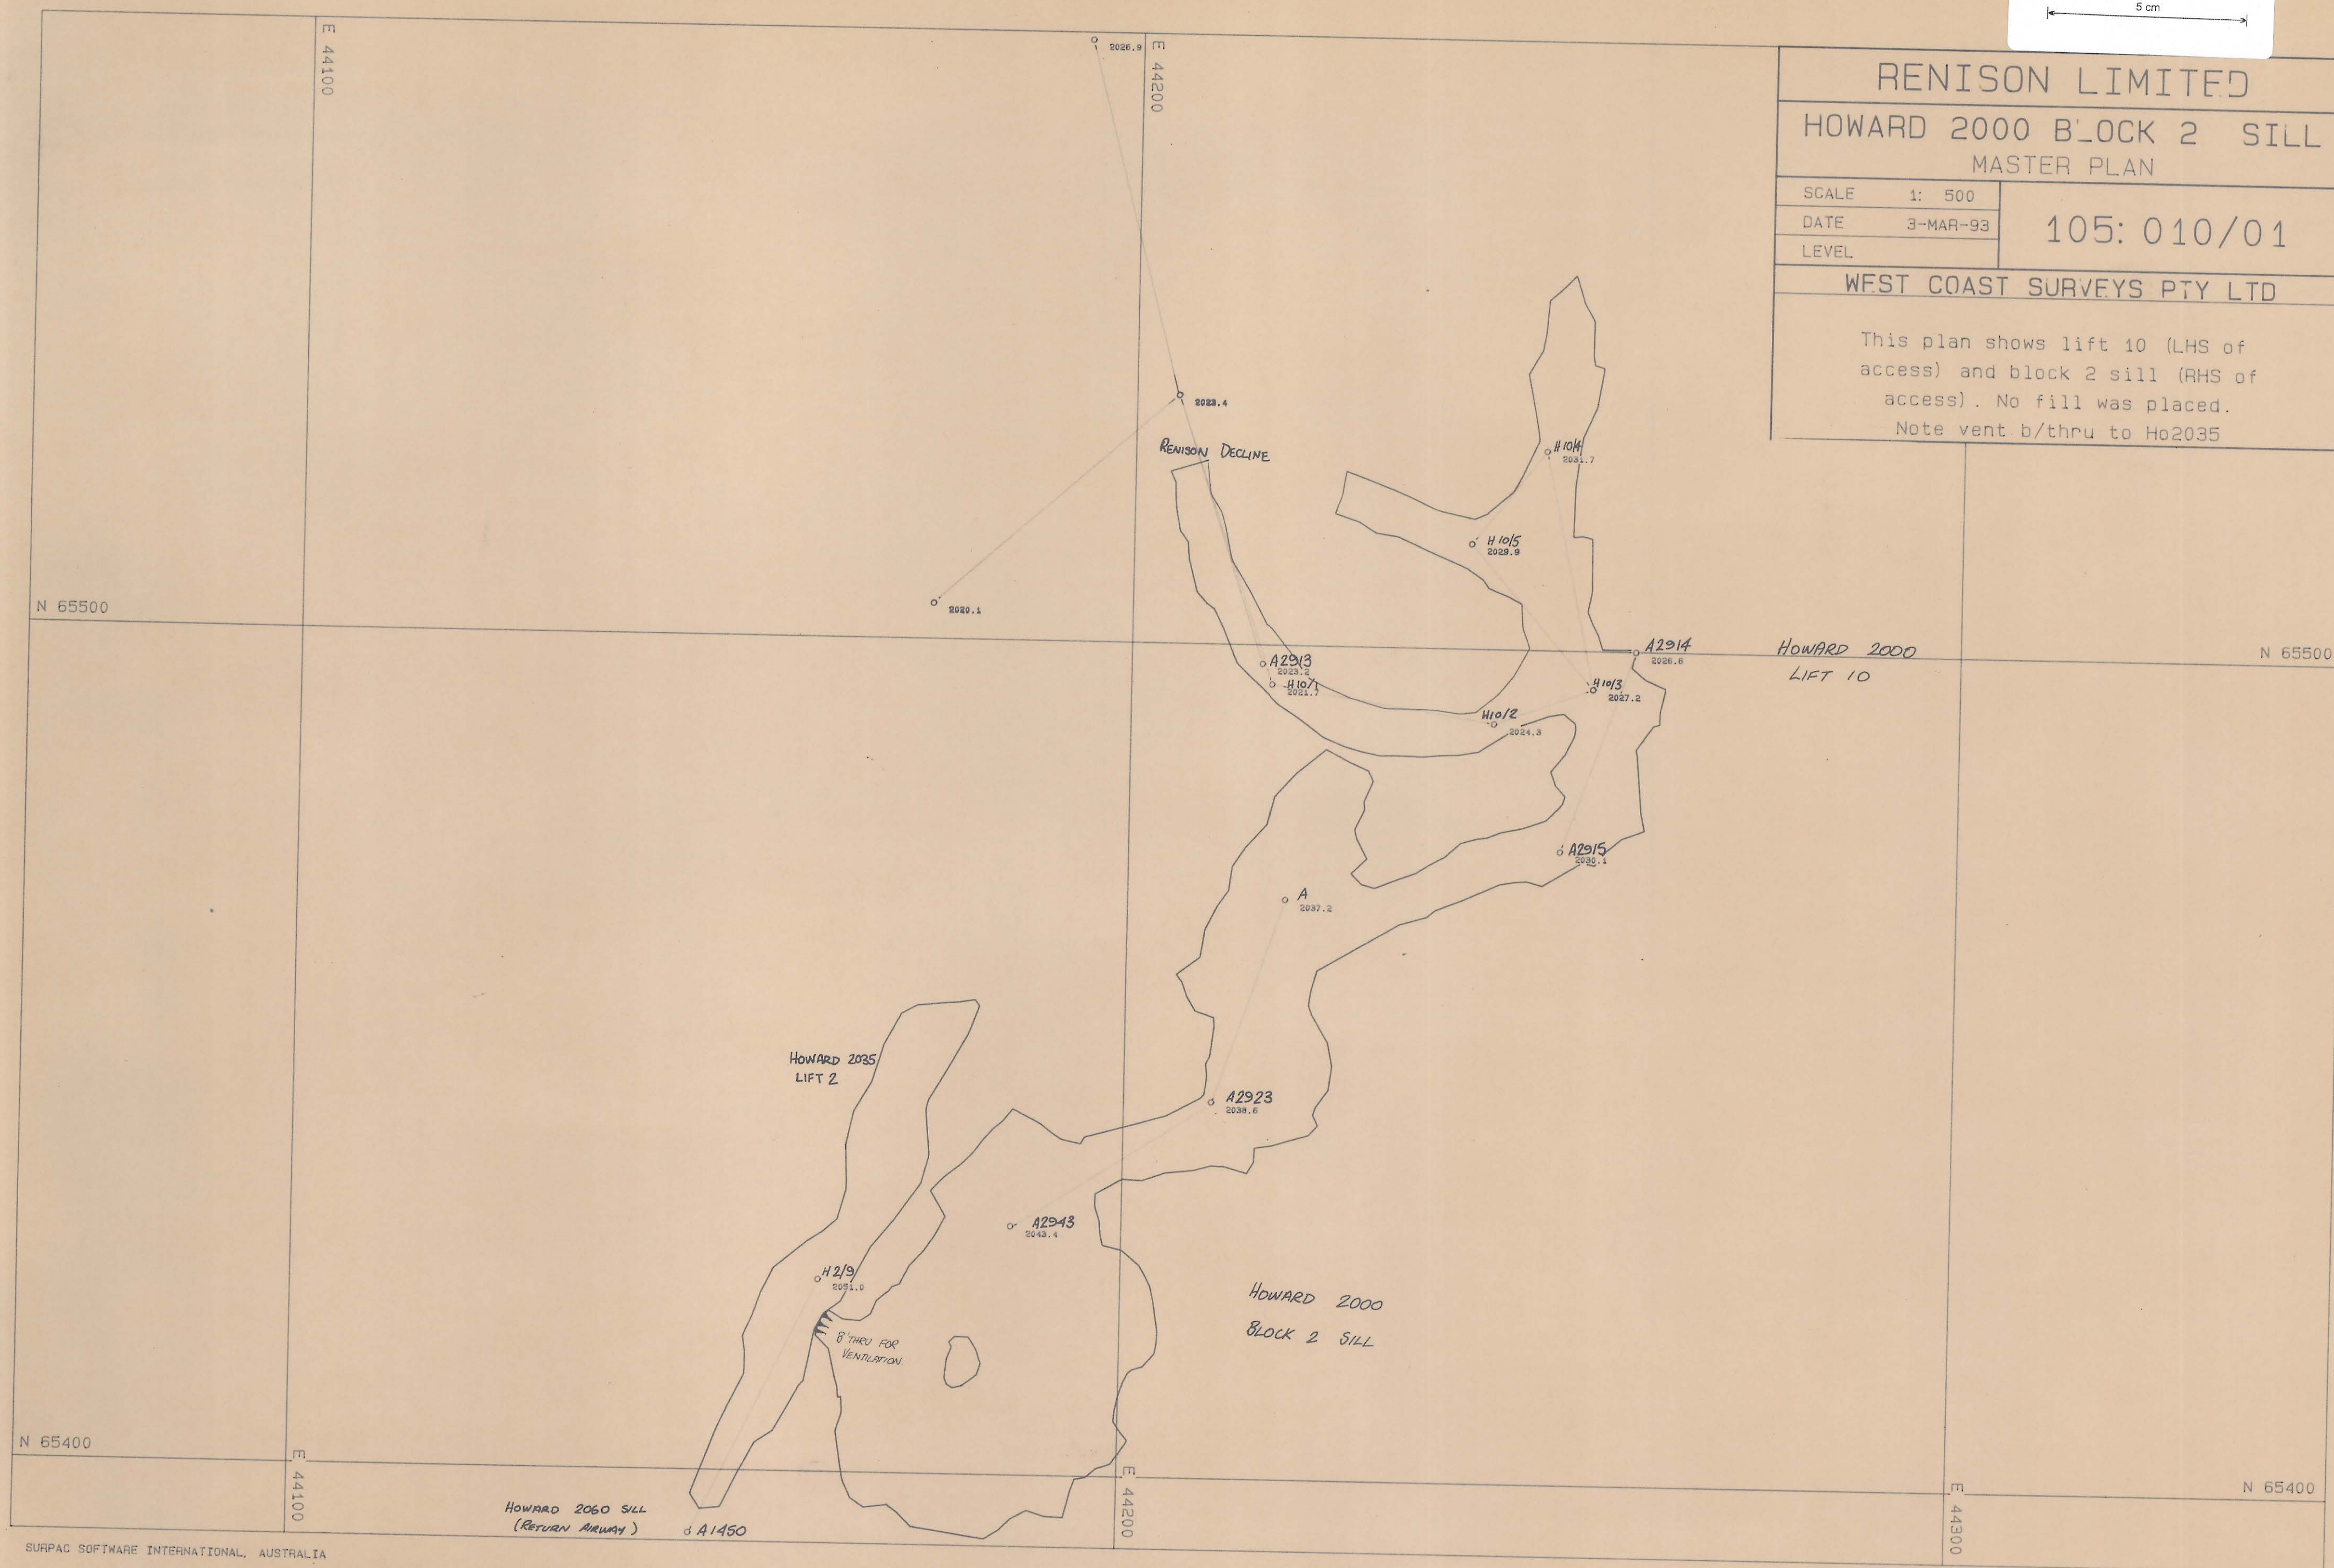

MASTEA, PF