

0376-470

RENISON LIMITED

ELDON 4 SILL
MASTER PLAN

SCALE 1: 500

DATE 12-FEB-93


LEVEL 35

202: 000/01

WEST COAST SURVEYS PTY LTD

This stope was mined into the
ore, the rise was then mined.
Silling out followed.

5 cm

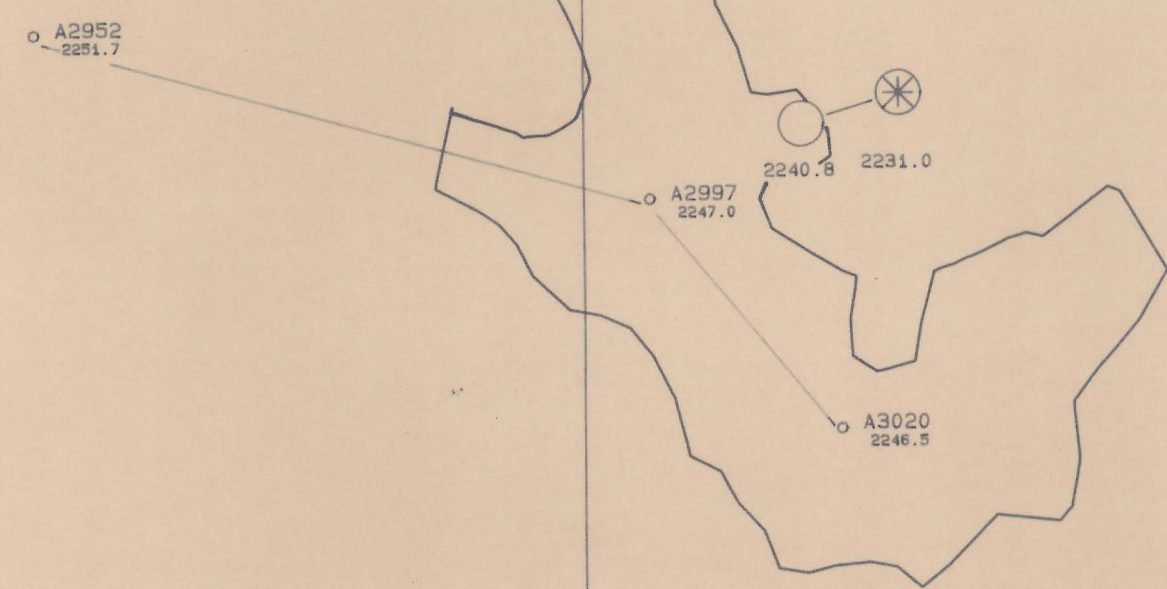

N 65500

N 65600

E 43700

E 43800

E 43700

E 43800

E 43900

N 65500

MASTEA.PF

IX