


0326-474

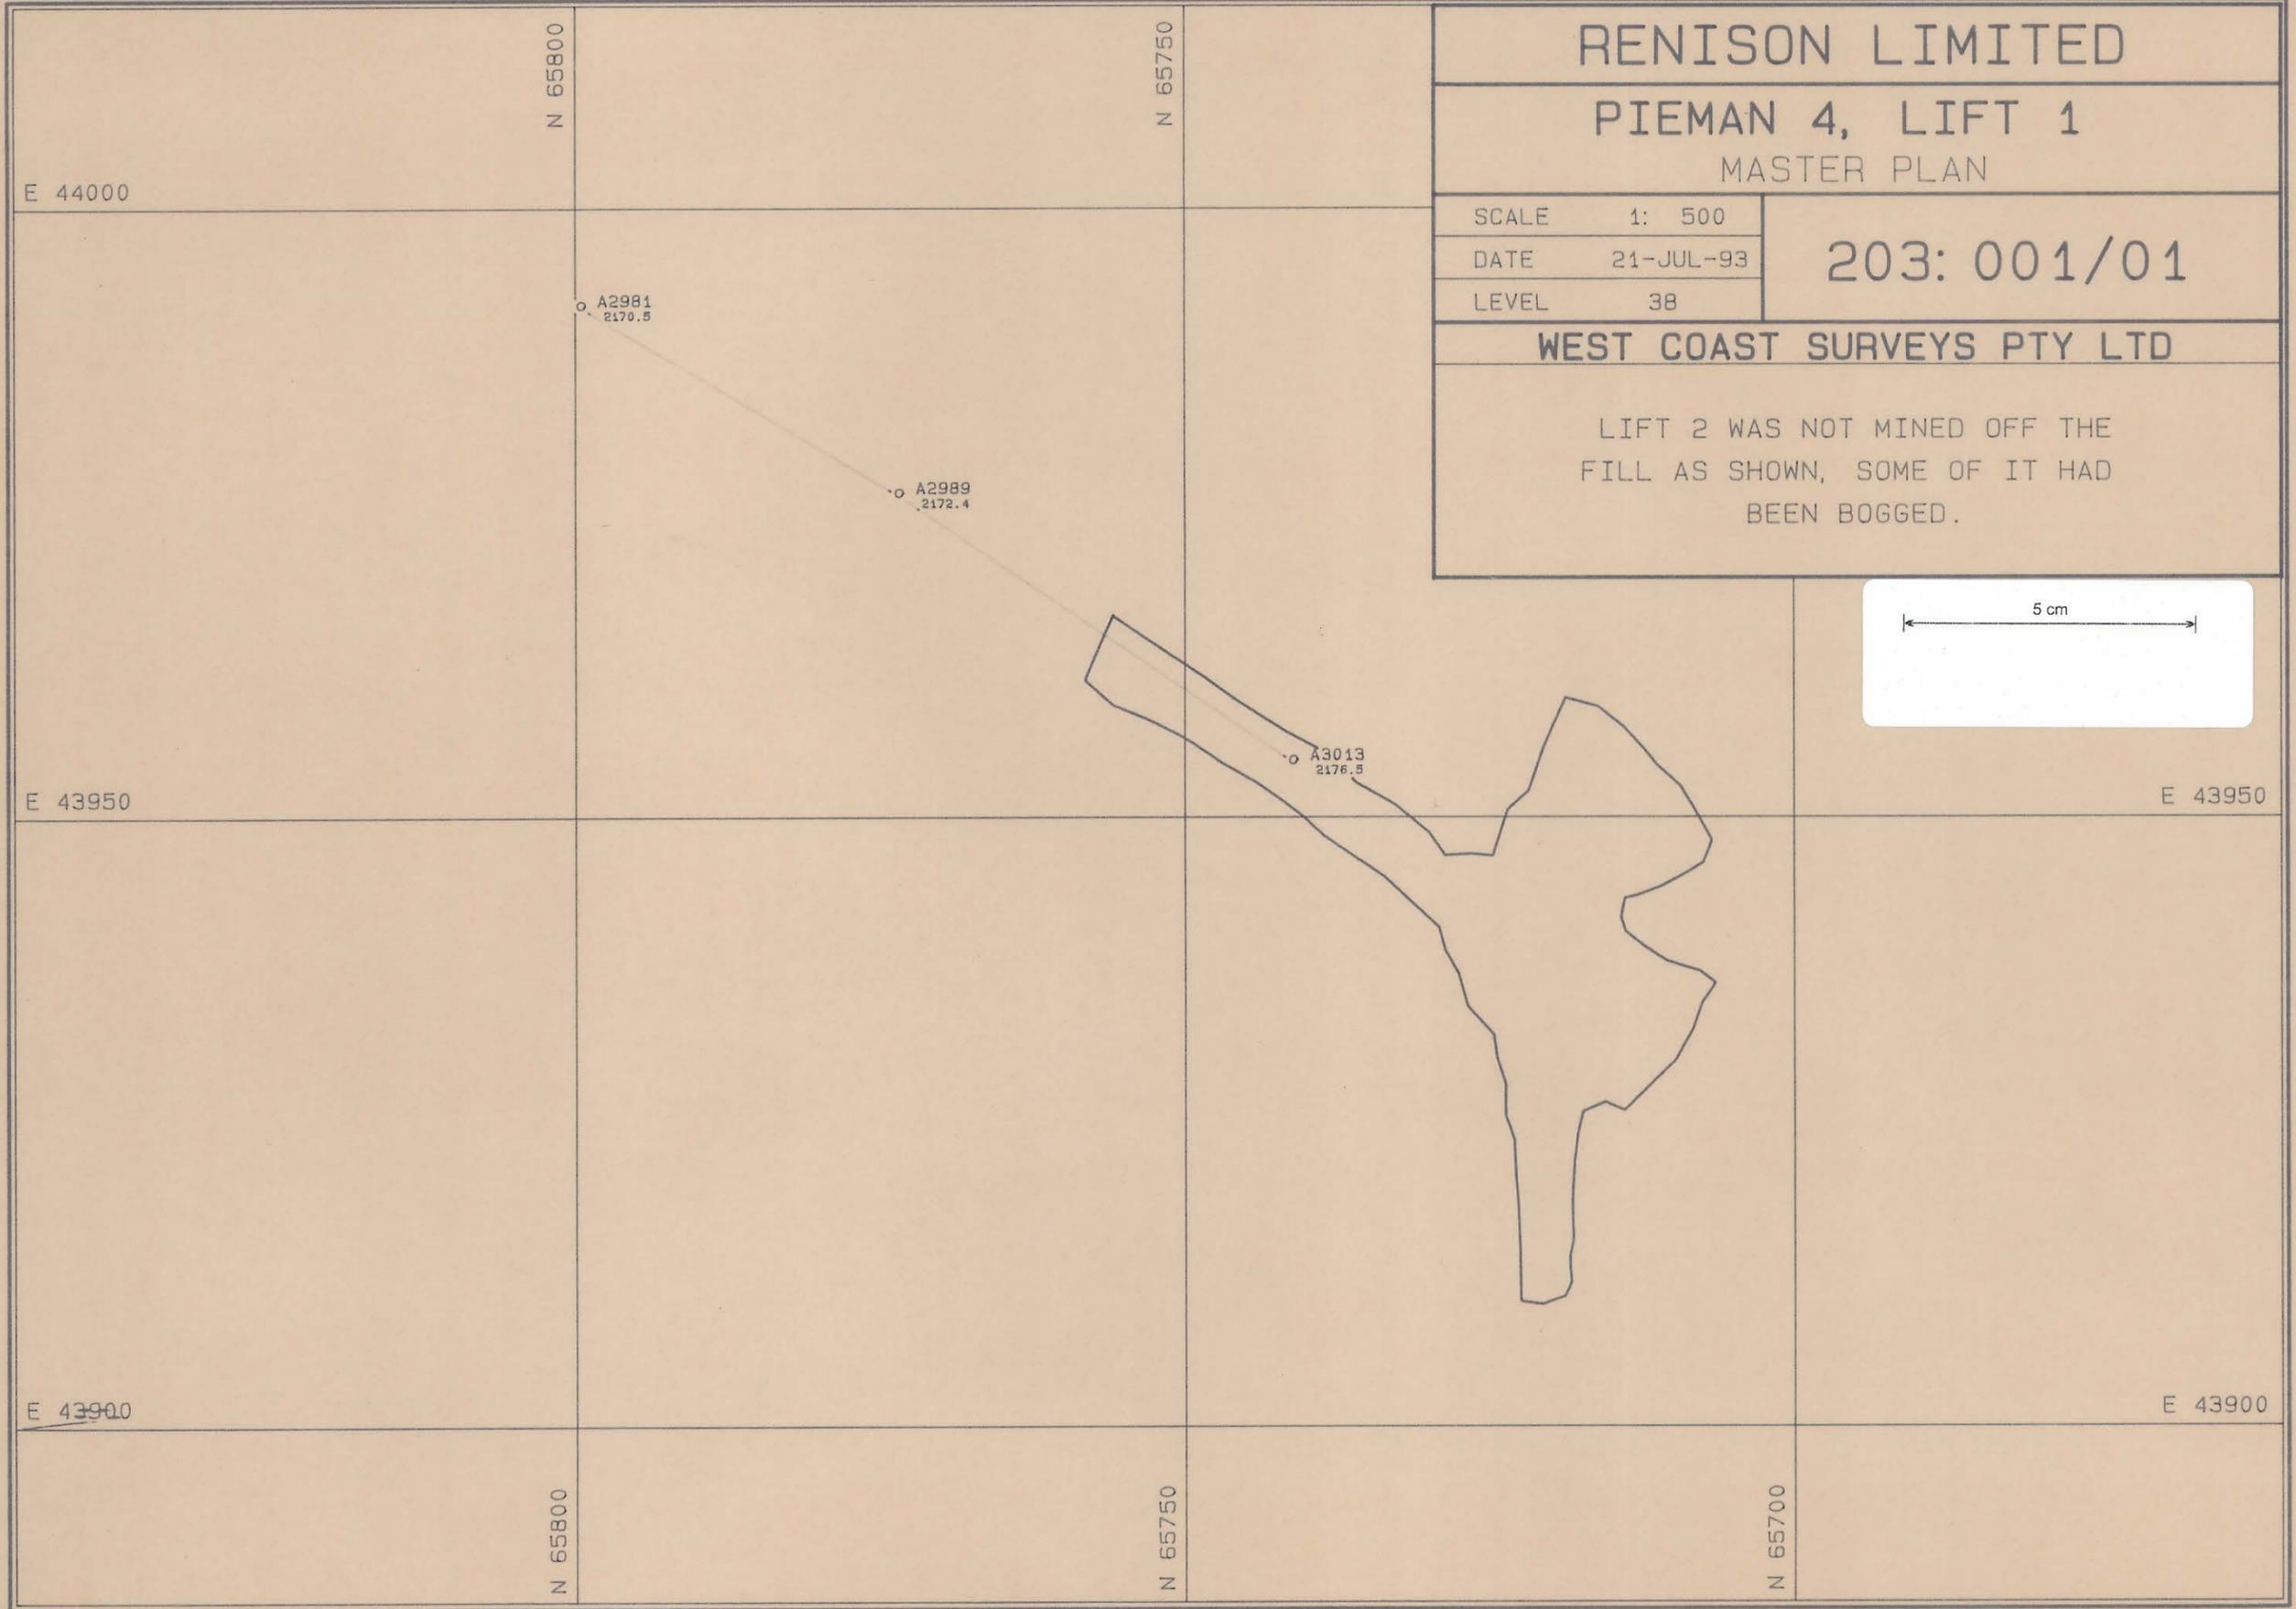

RENISON LIMITED


PIEMAN 4, LIFT 1 MASTER PLAN

SCALE	1: 500
DATE	21-JUL-93
LEVEL	38

203: 001/01

WEST COAST SURVEYS PTY LTD

LIFT 2 WAS NOT MINED OFF THE
FILL AS SHOWN, SOME OF IT HAD
BEEN BOGGED.

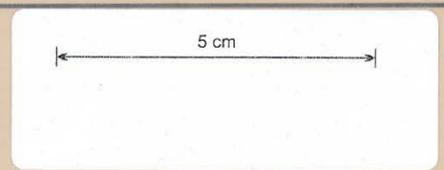

MASTEA.PF