
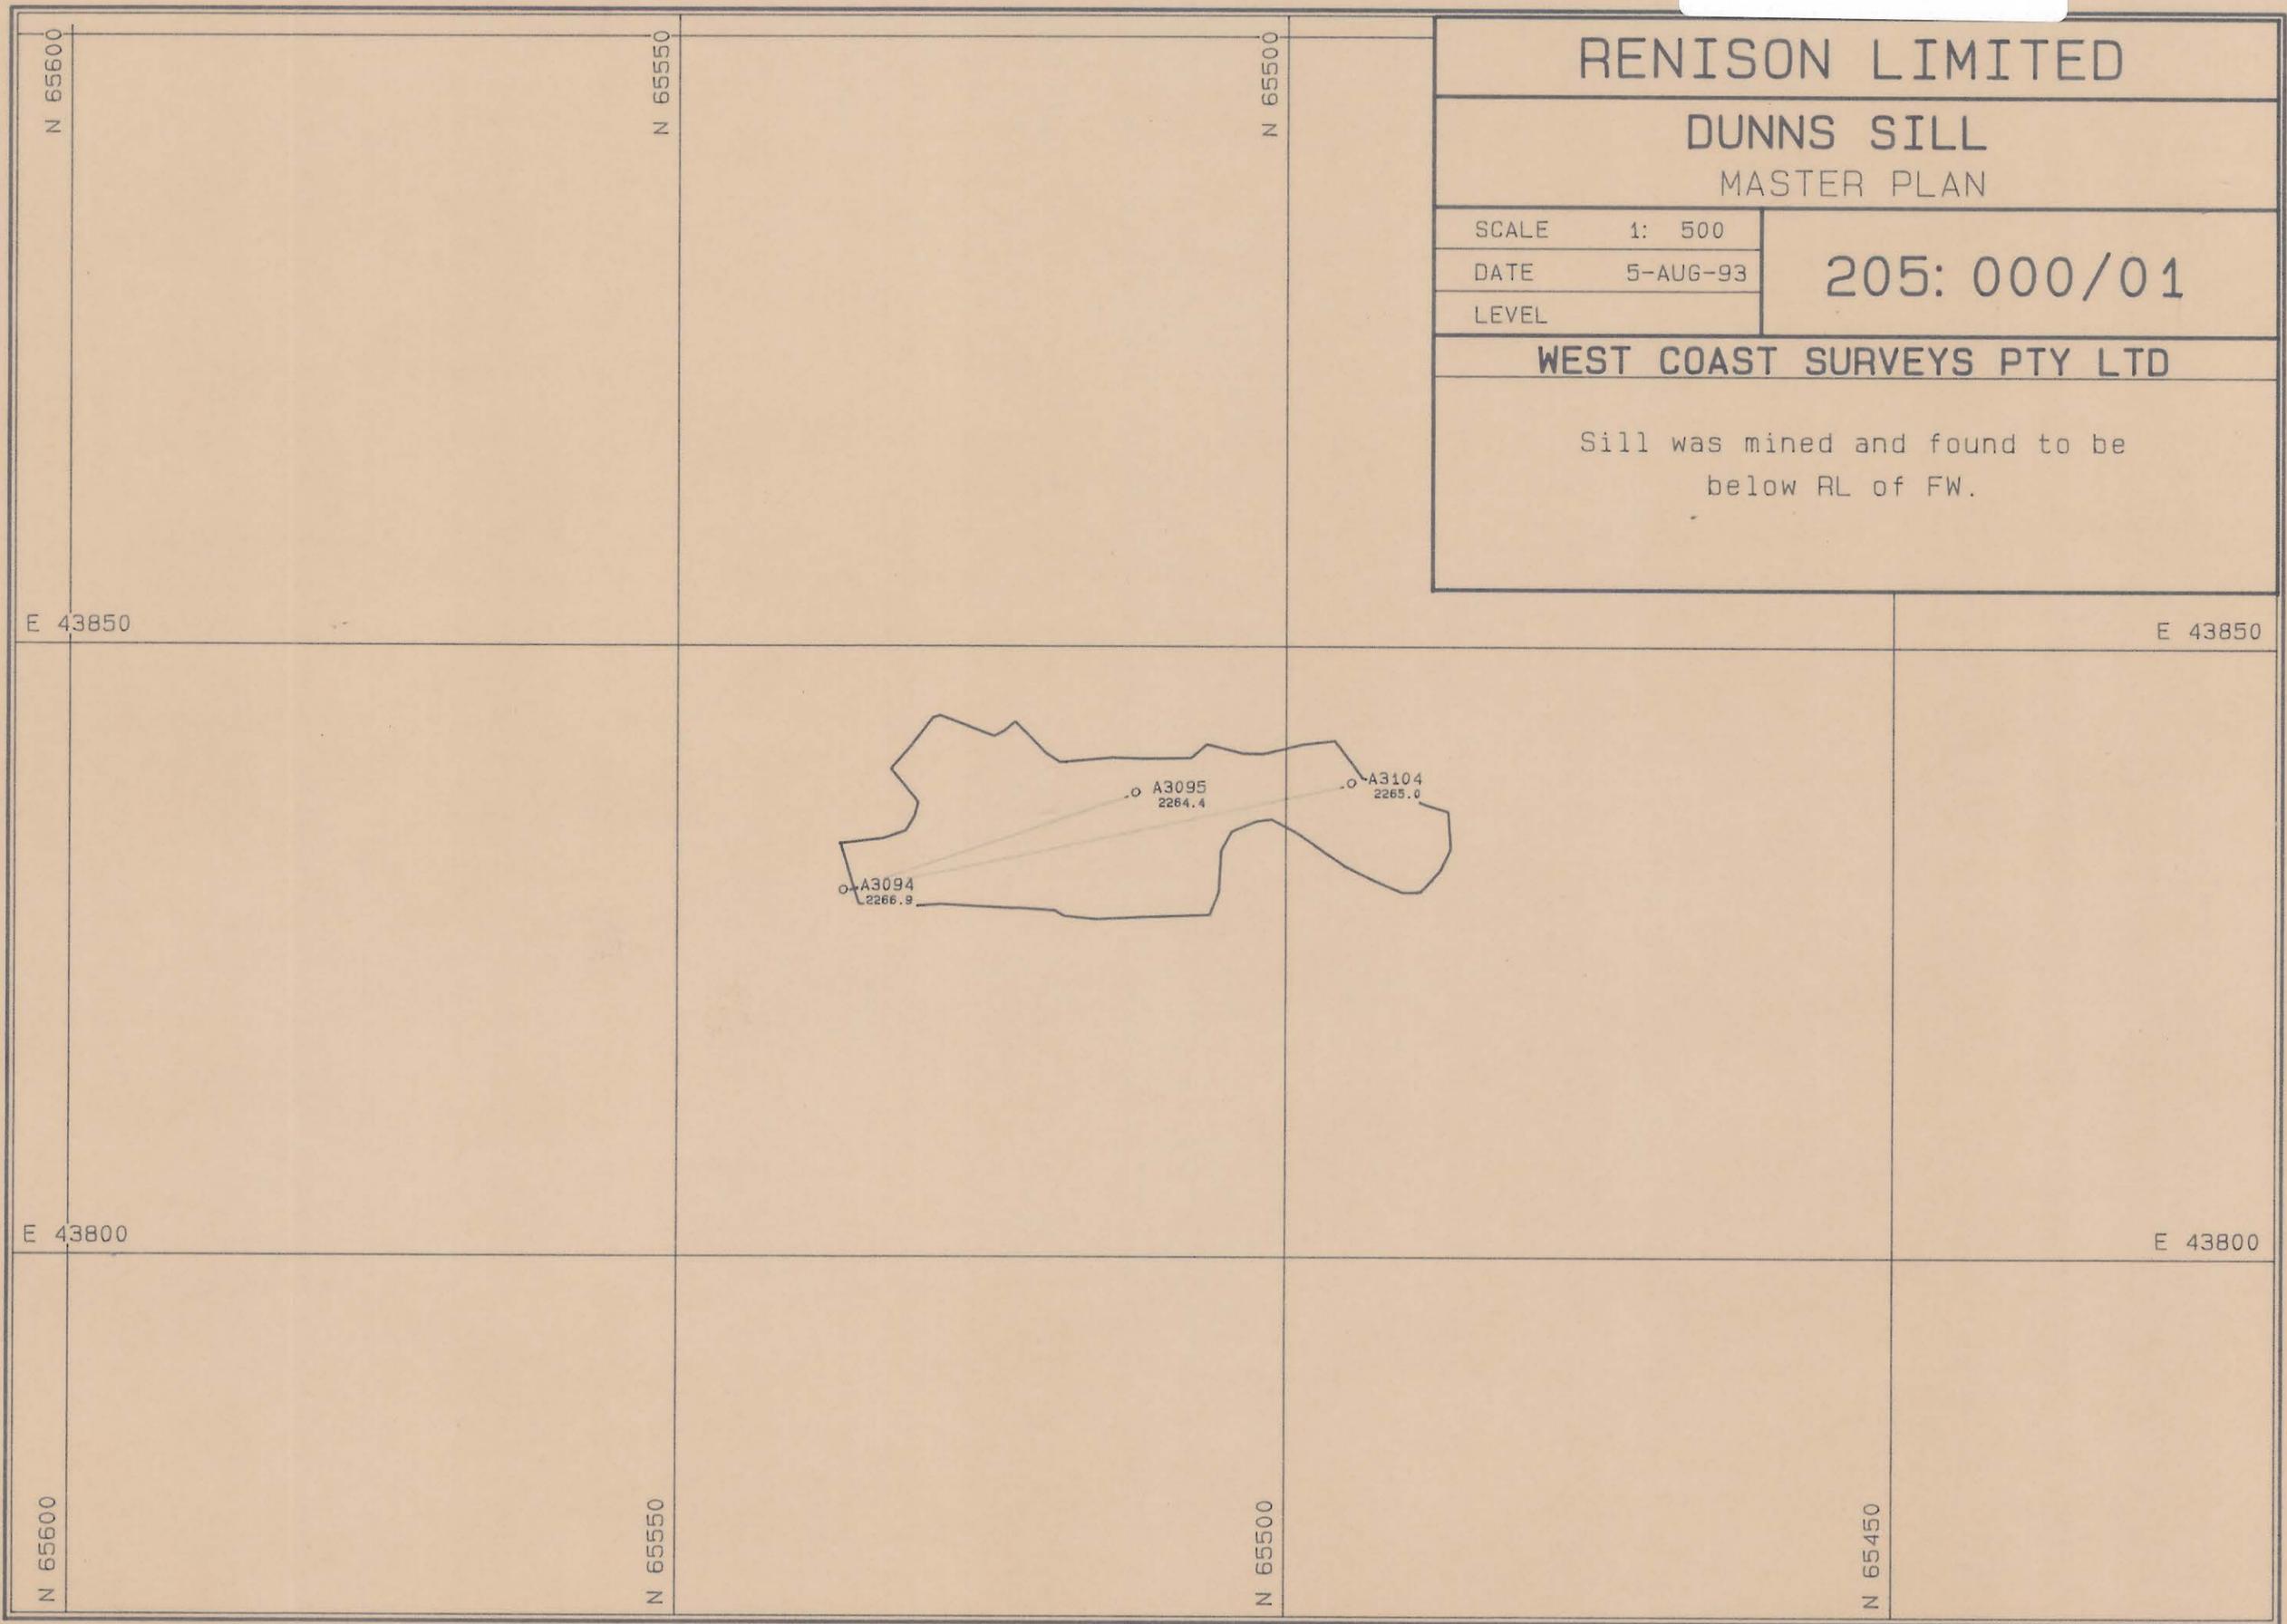


0376-475

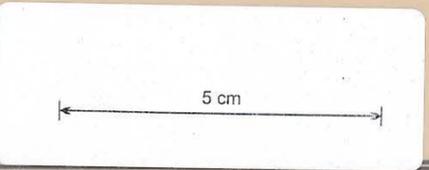

RENISON LIMITED

DUNNS SILL MASTER PLAN

SCALE 1: 500
 DATE 5-AUG-93
 LEVEL

205: 000/01

WEST COAST SURVEYS PTY LTD

Sill was mined and found to be below RL of FW.

MASTE.A.PF