


0376-476

5 cm

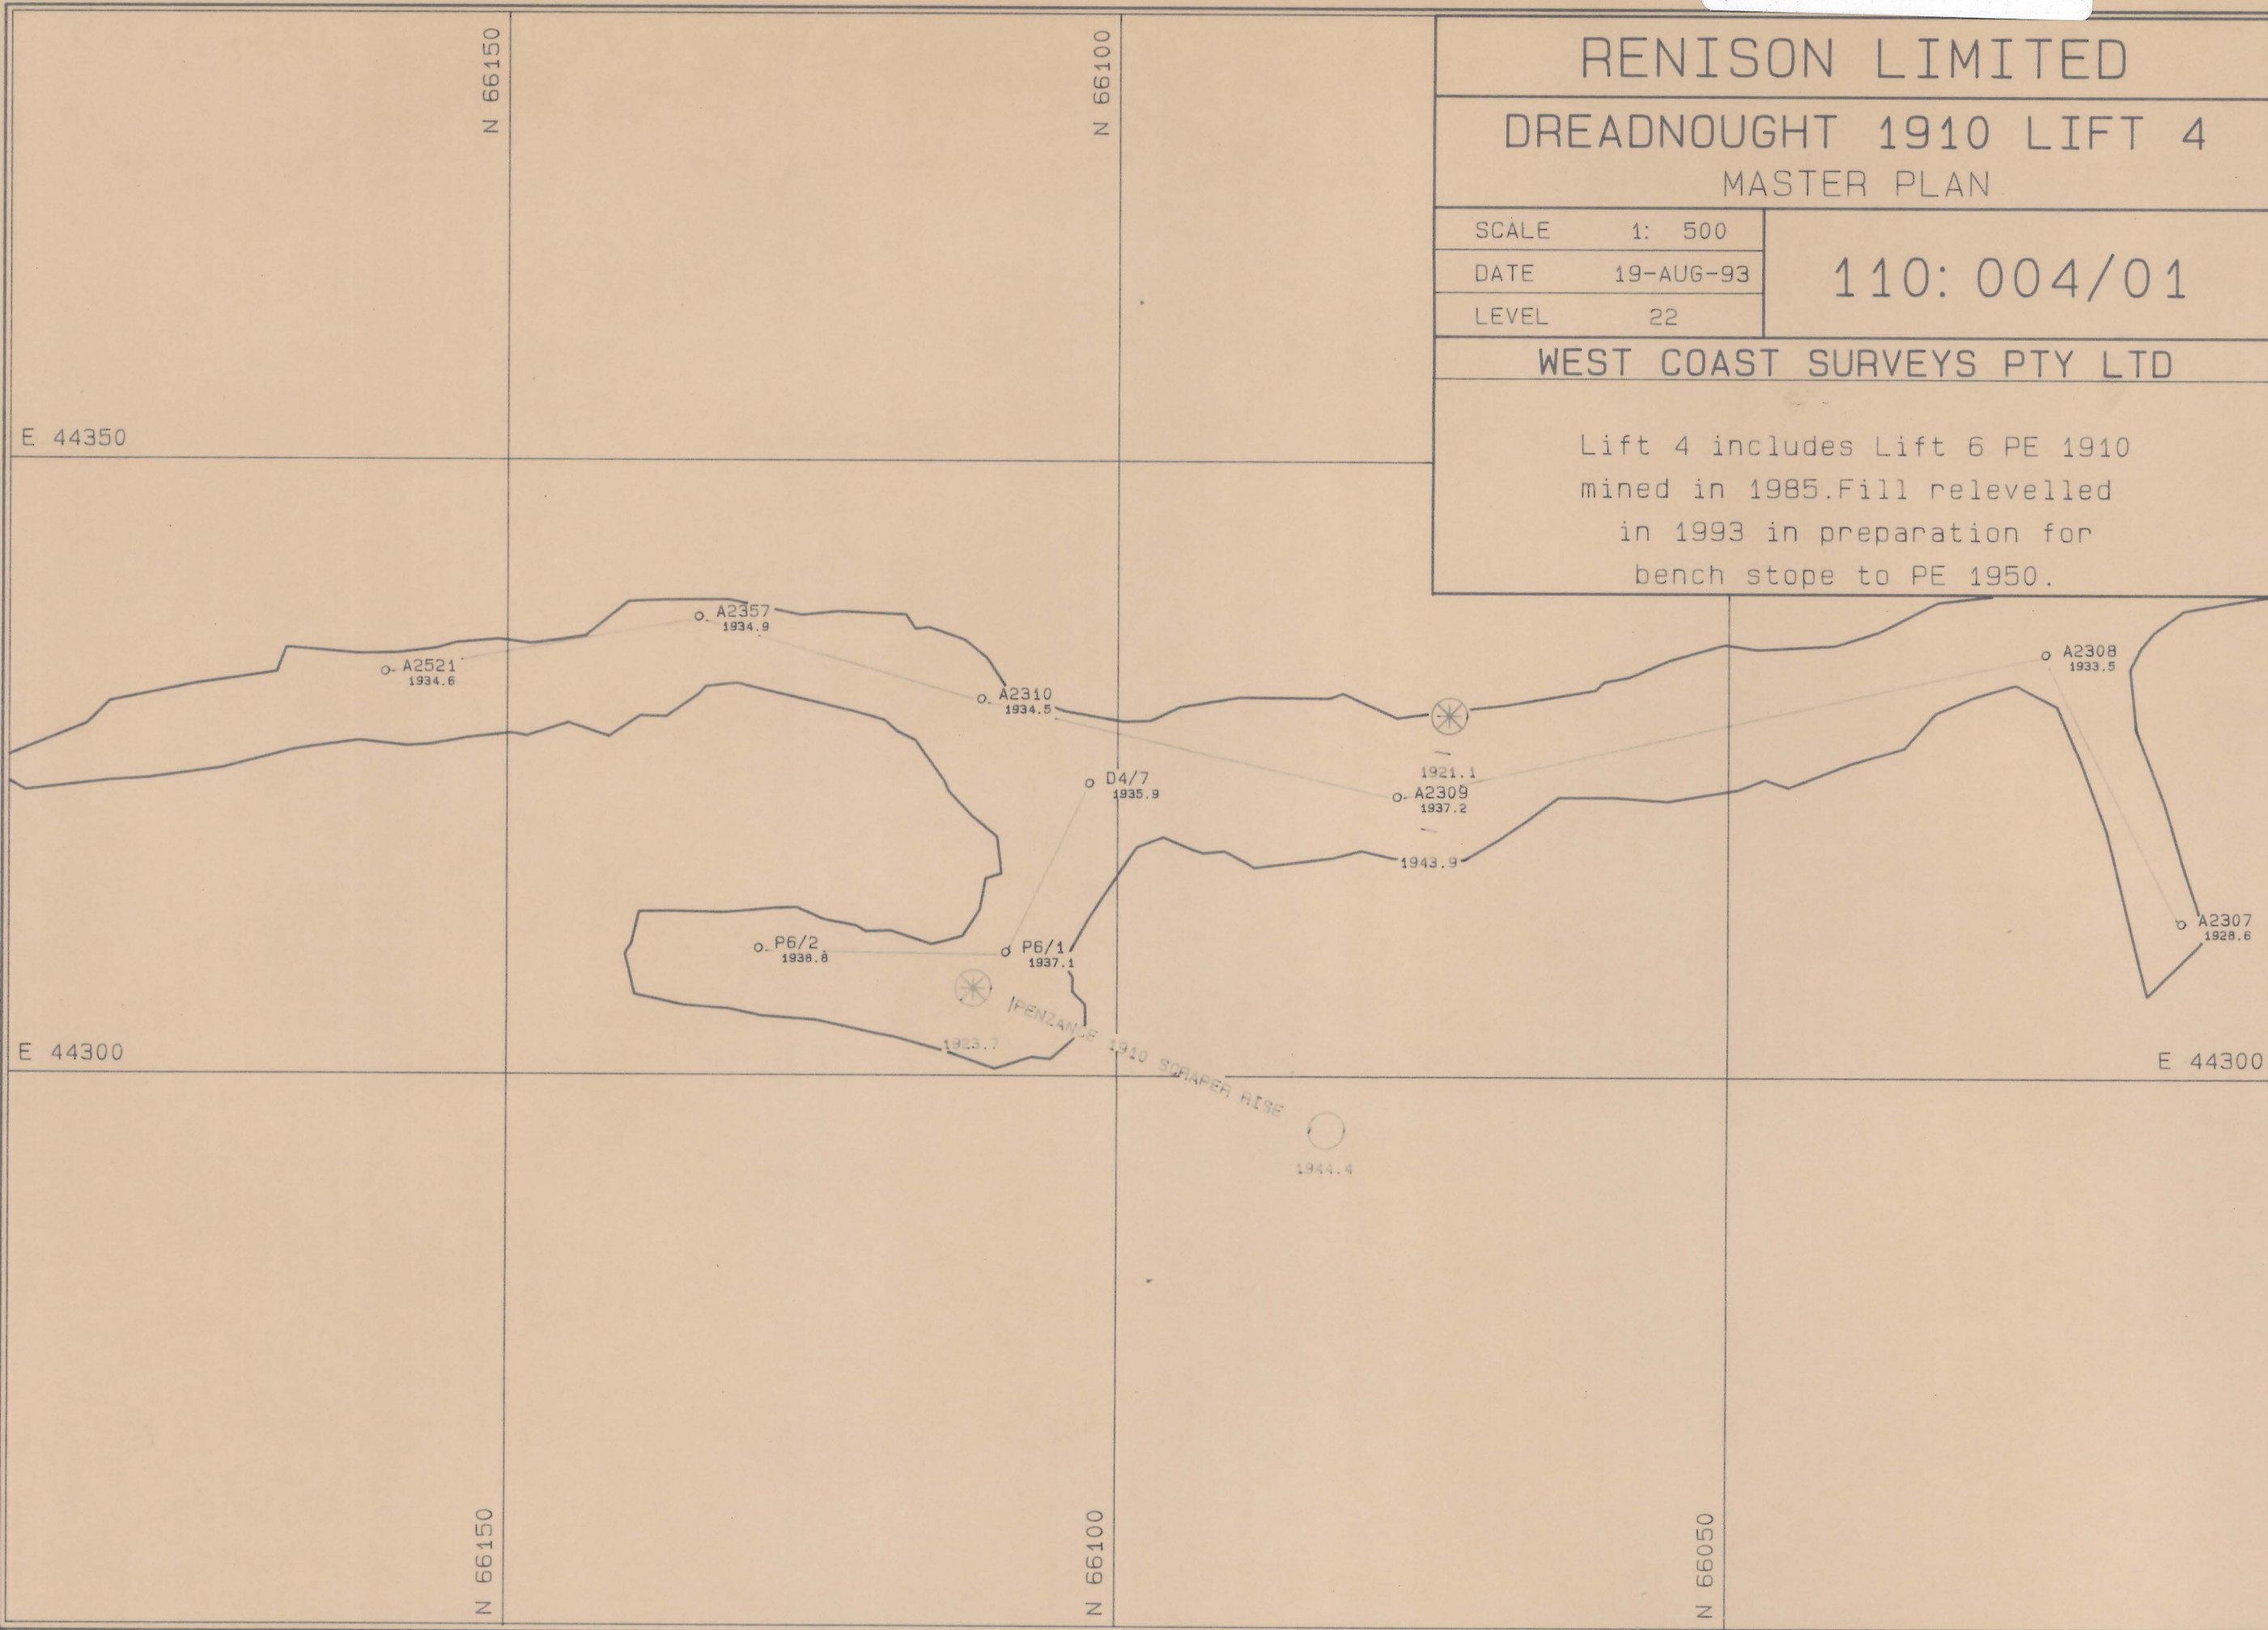

MASTE.A.PF

IX