
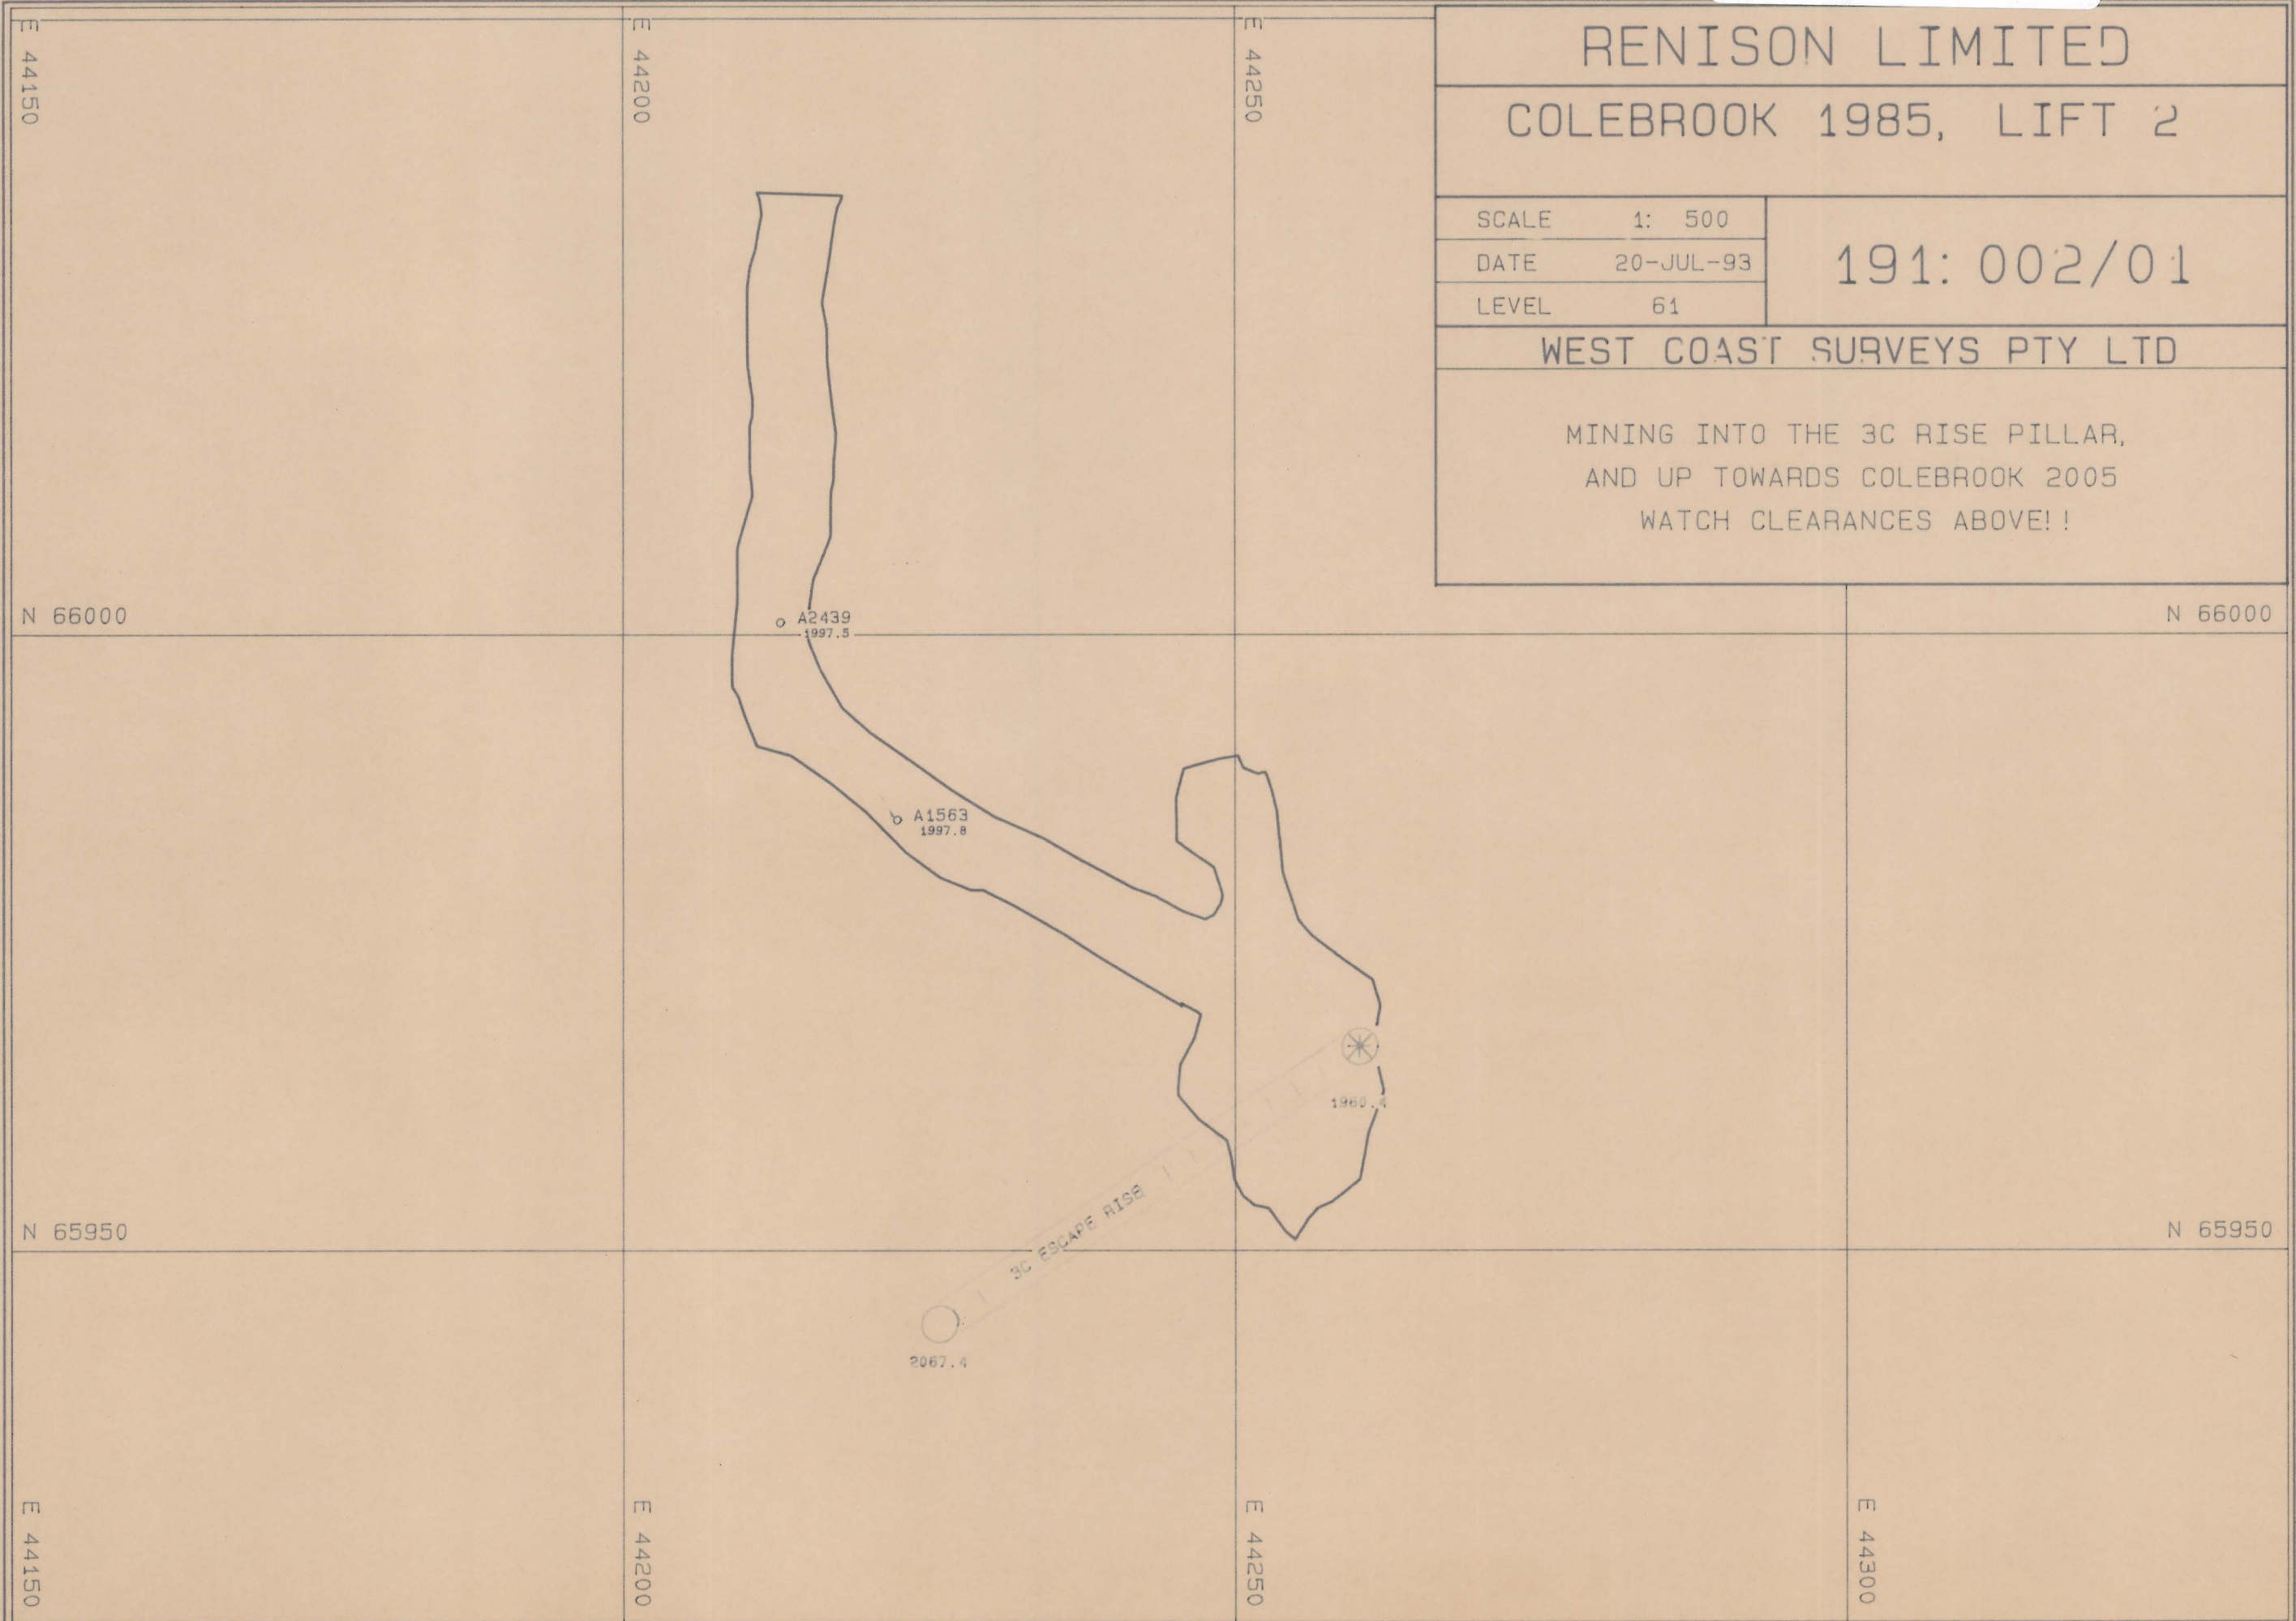


0376-477

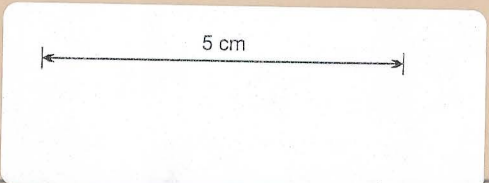

RENISON LIMITED
COLEBROOK 1985, LIFT 2

SCALE	1: 500	191: 002/01
DATE	20-JUL-93	
LEVEL	61	
WEST COAST SURVEYS PTY LTD		

MINING INTO THE 3C RISE PILLAR,
AND UP TOWARDS COLEBROOK 2005
WATCH CLEARANCES ABOVE!!

MASTED.PF