


0376-478

5 cm

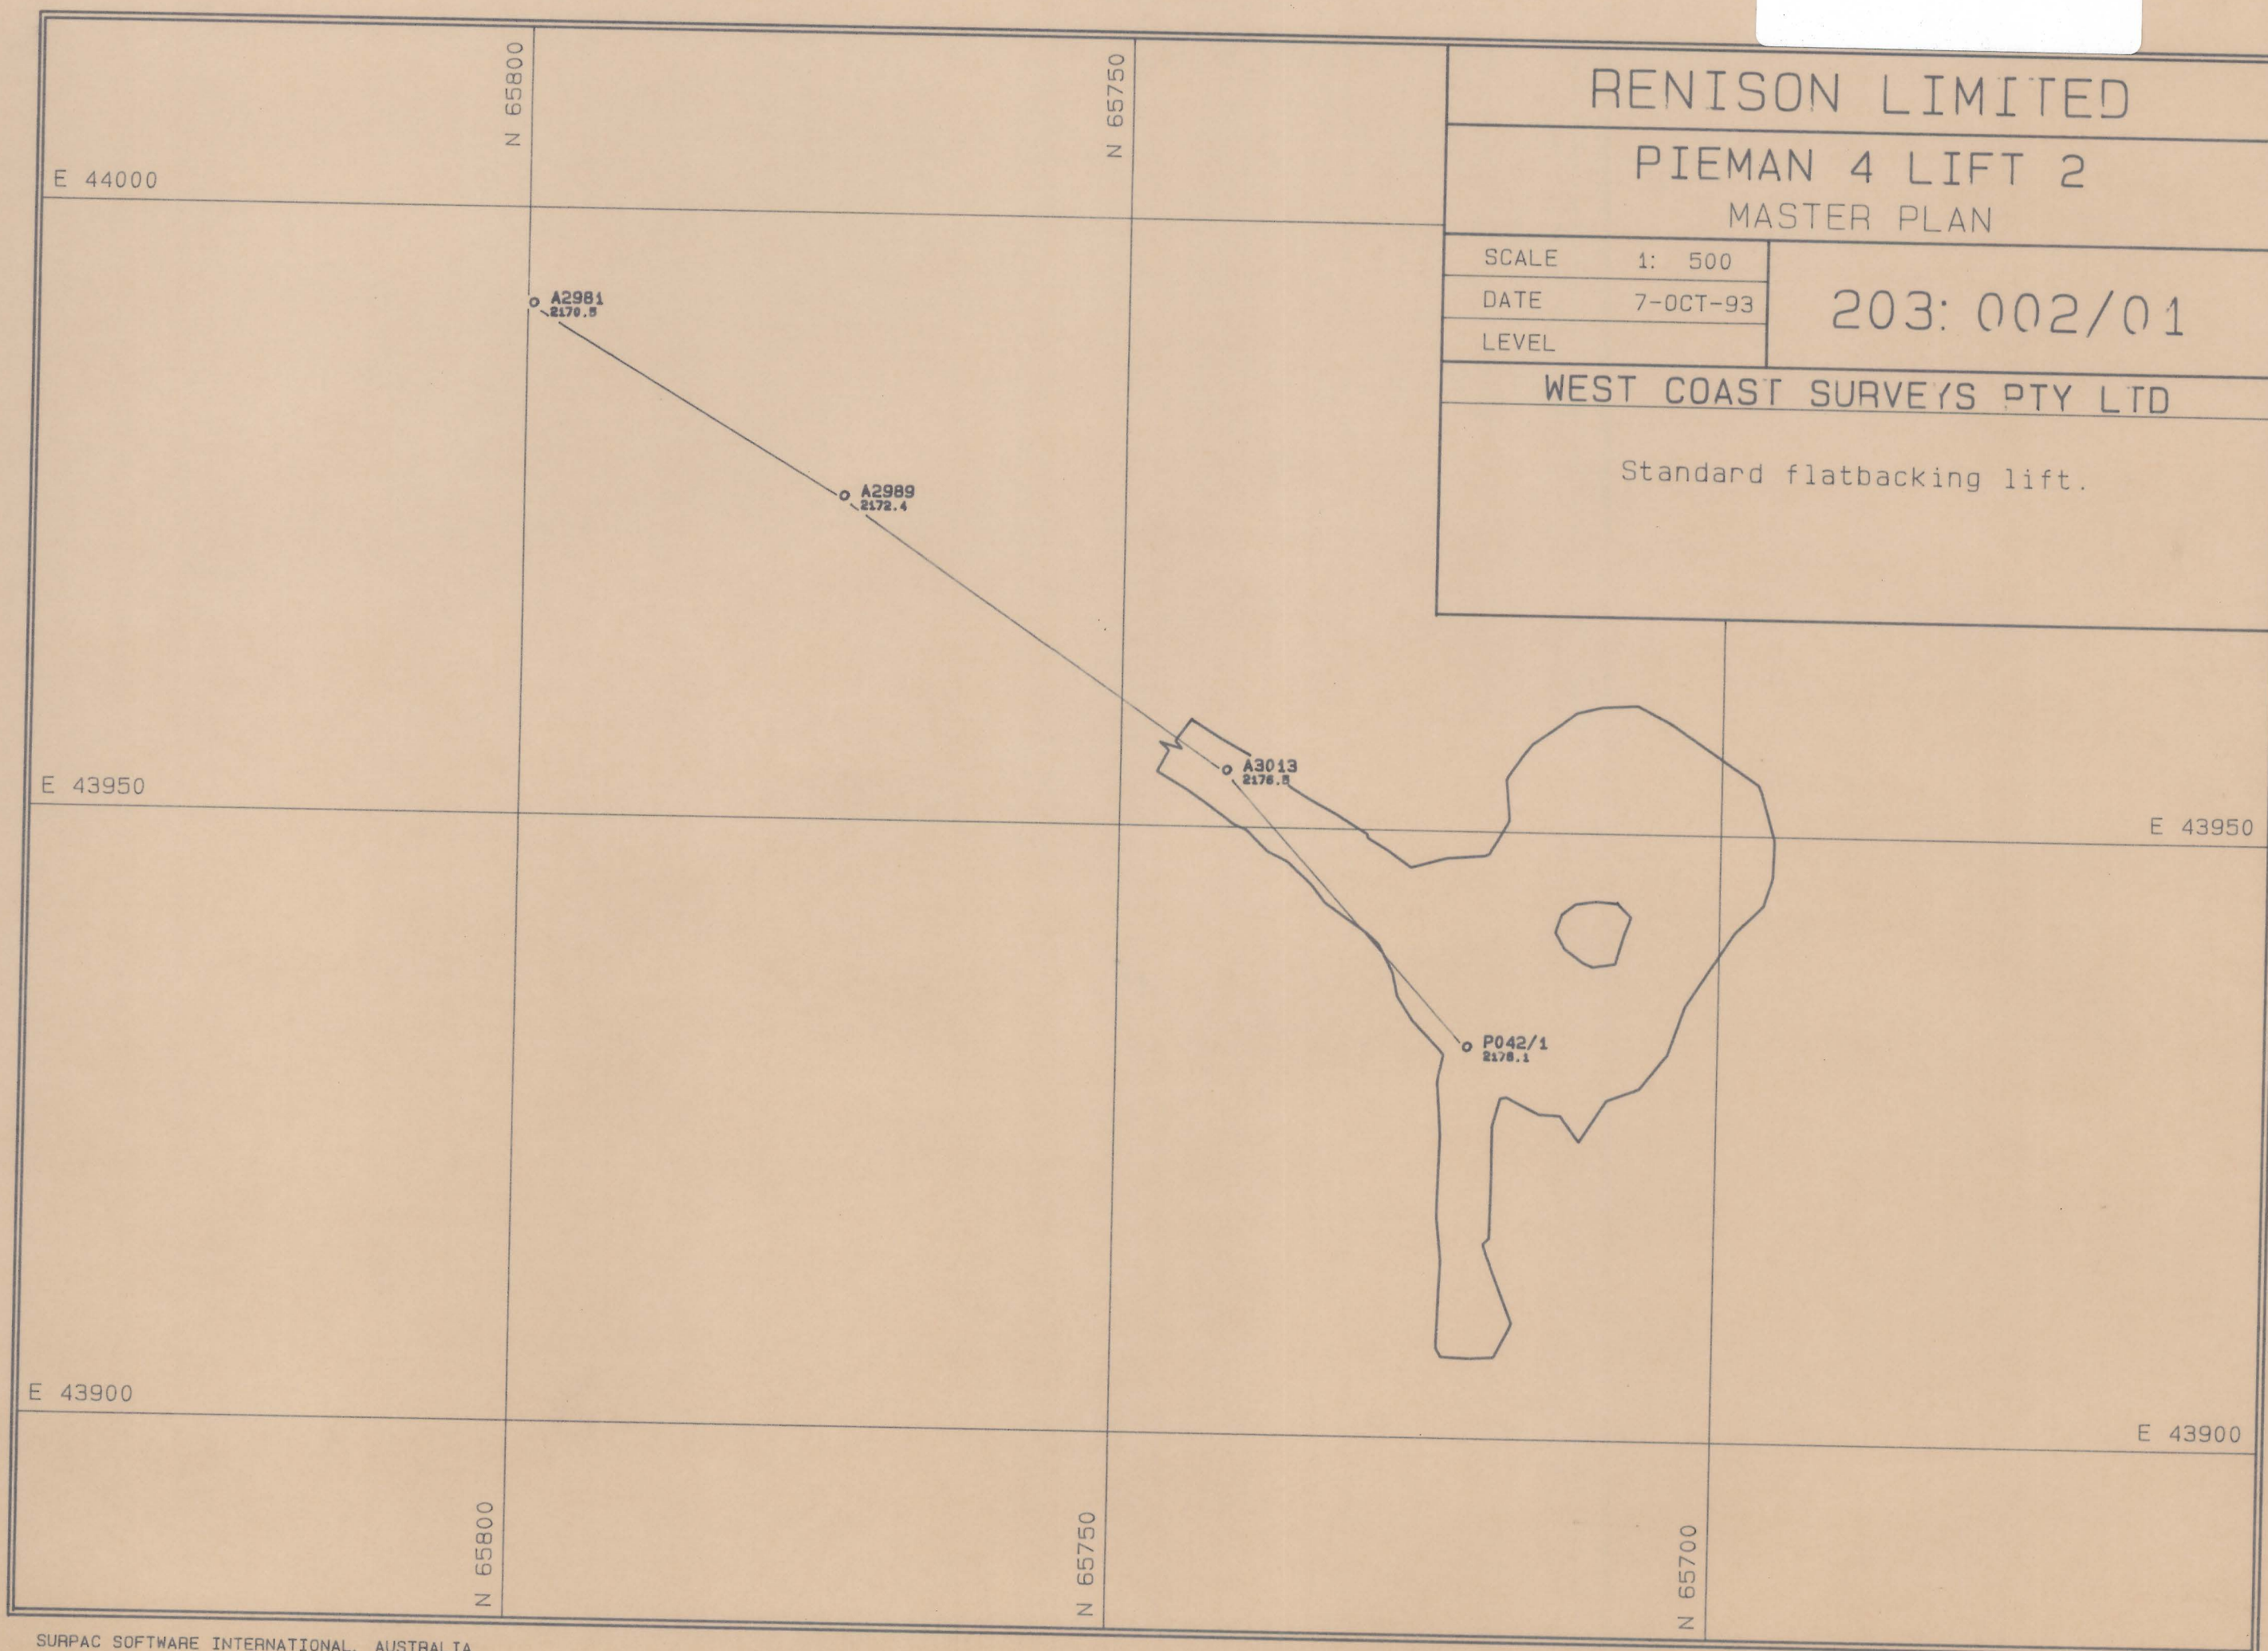

MASTEA.PF