
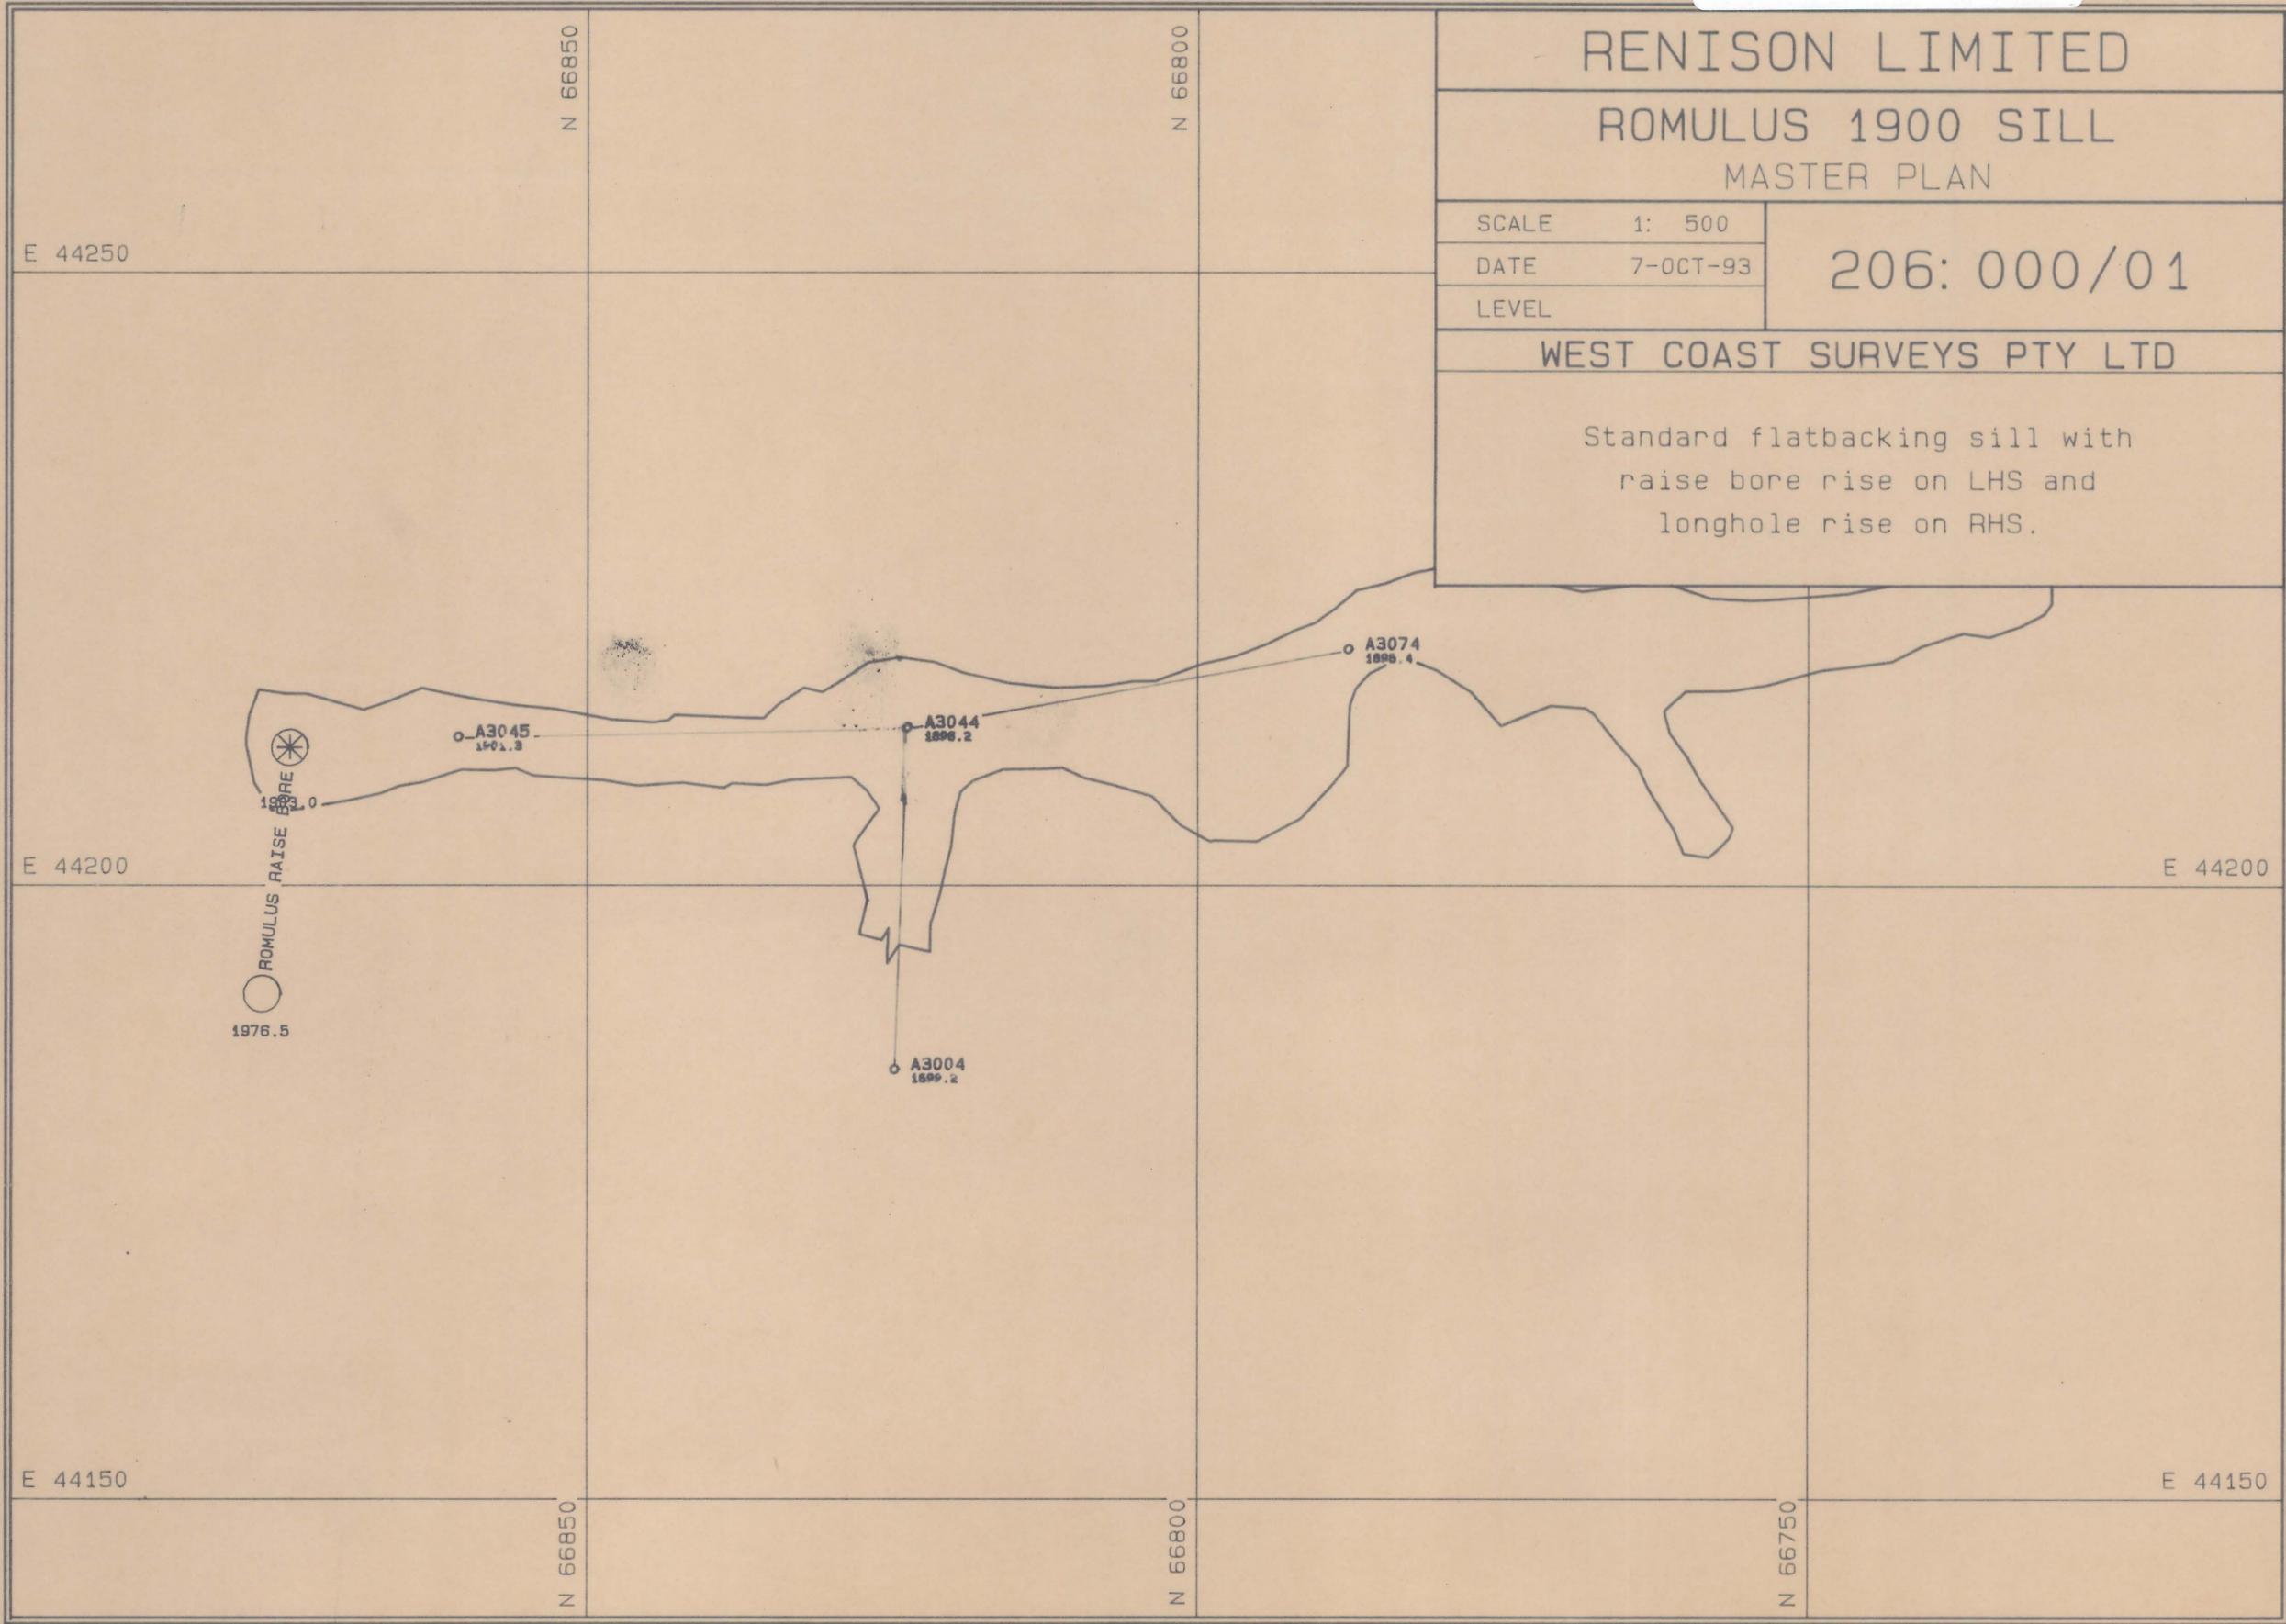


0376-479

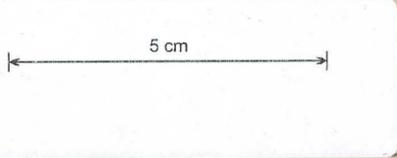

MASTEA.PF