


0376 - 480

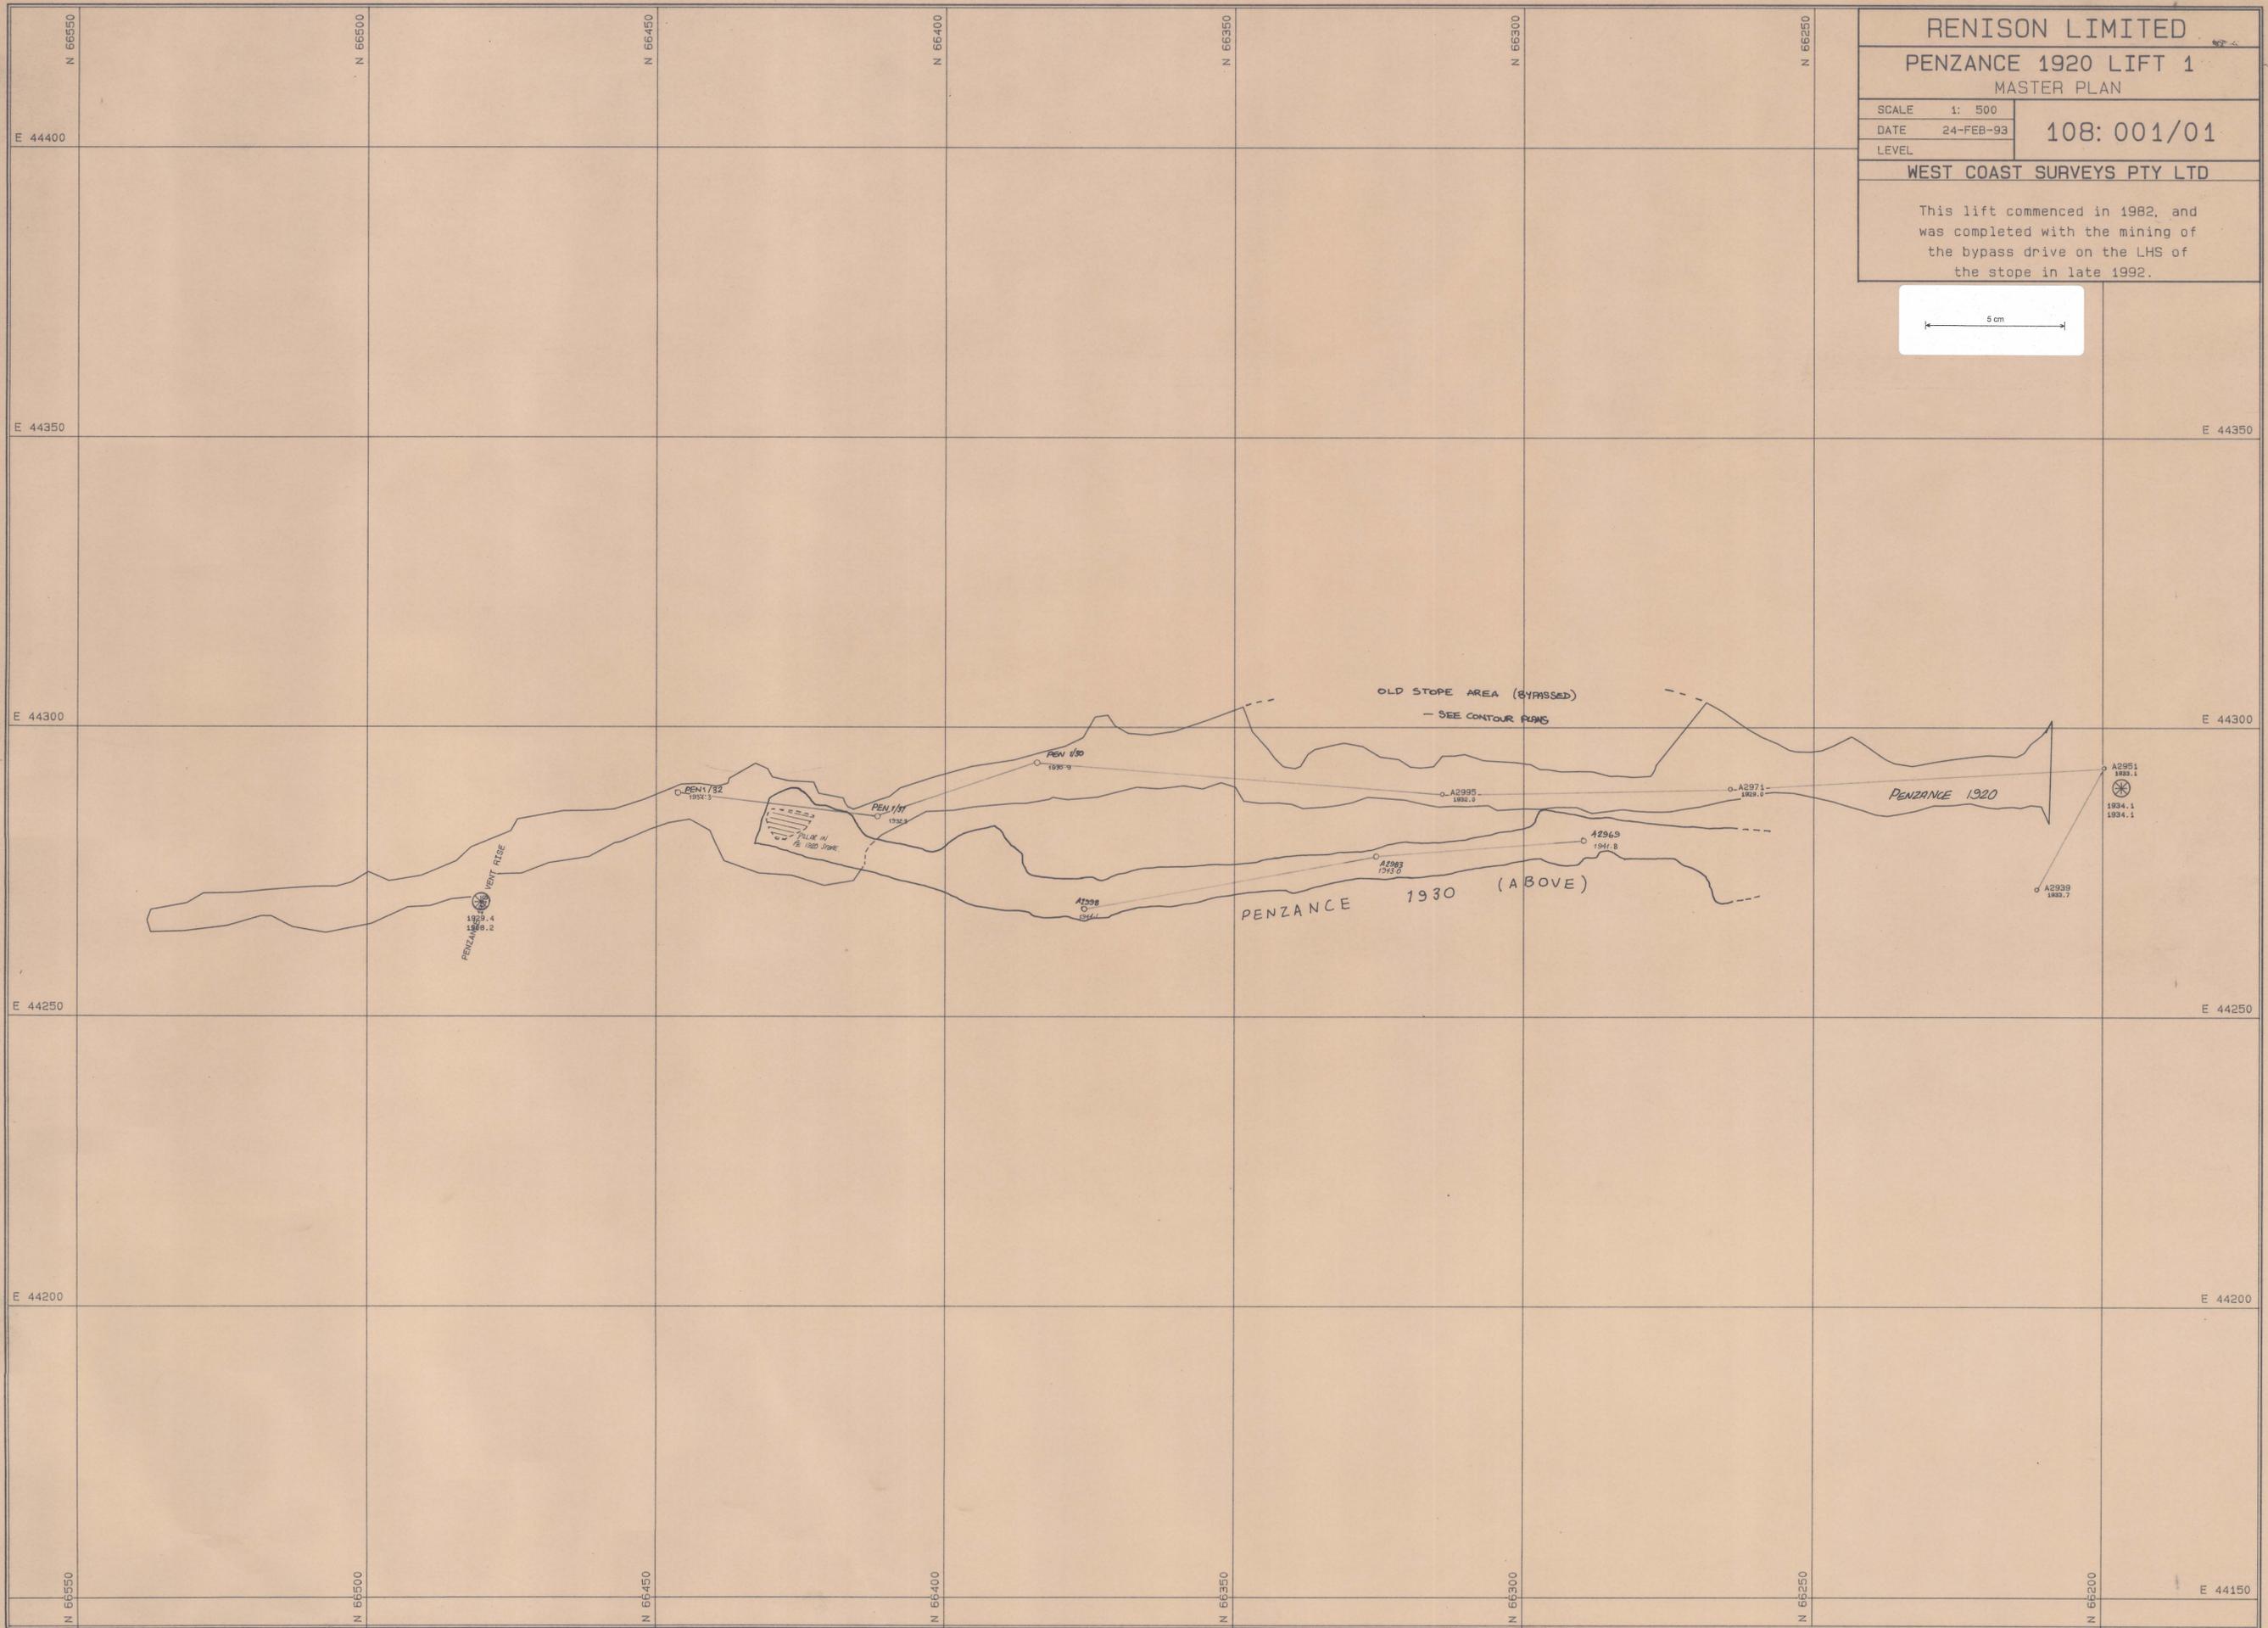

**RENISON LIMITED**  
**PENZANCE 1920 LIFT 1**  
**MASTER PLAN**

SCALE	1: 500	108:001/01
DATE	24-FEB-93	
LEVEL		

**WEST COAST SURVEYS PTY LTD**

This lift commenced in 1982, and was completed with the mining of the bypass drive on the LHS of the stope in late 1992.



MASTEB.PF