



0376-481

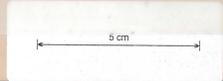

RENISON LIMITED	
DREADNOUGHT S45	
LIFT 1 (1984-1993)	
SCALE 1: 500	139: 001A/01
DATE 24-JUN-93	
LEVEL 2055	
WEST COAST SURVEYS PTY LTD	

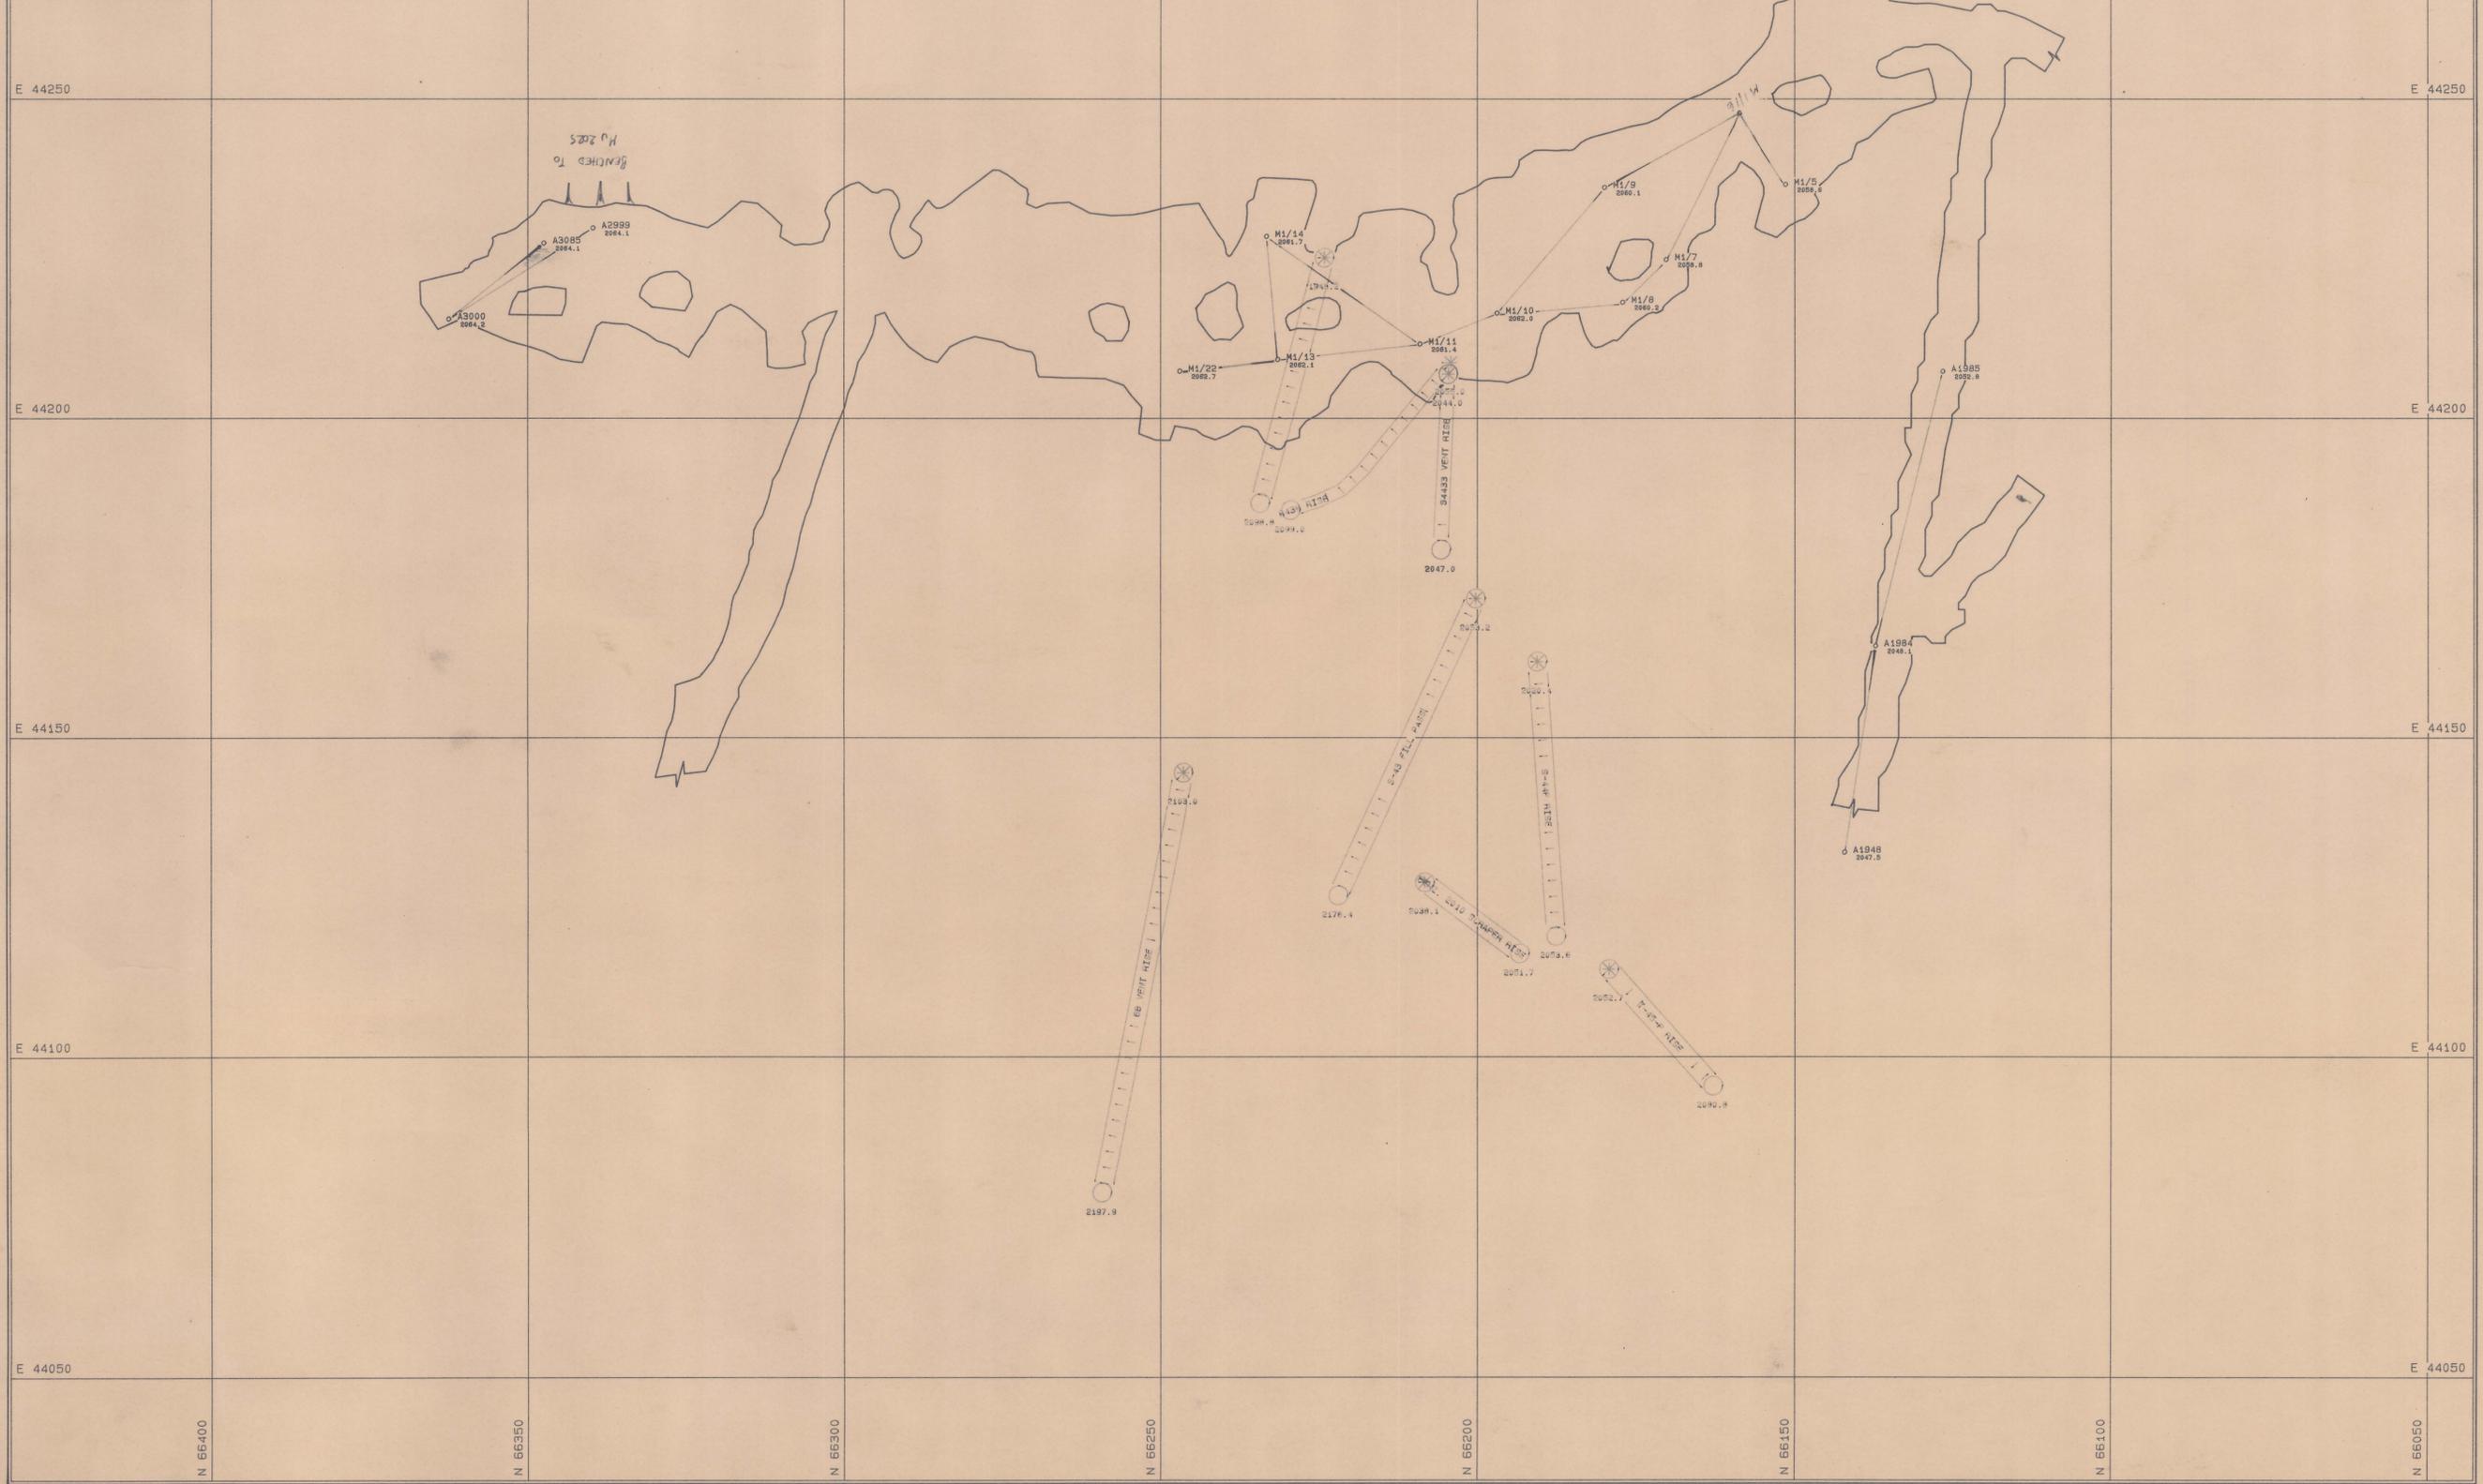

MASTEC.PF