


MICROFILMED

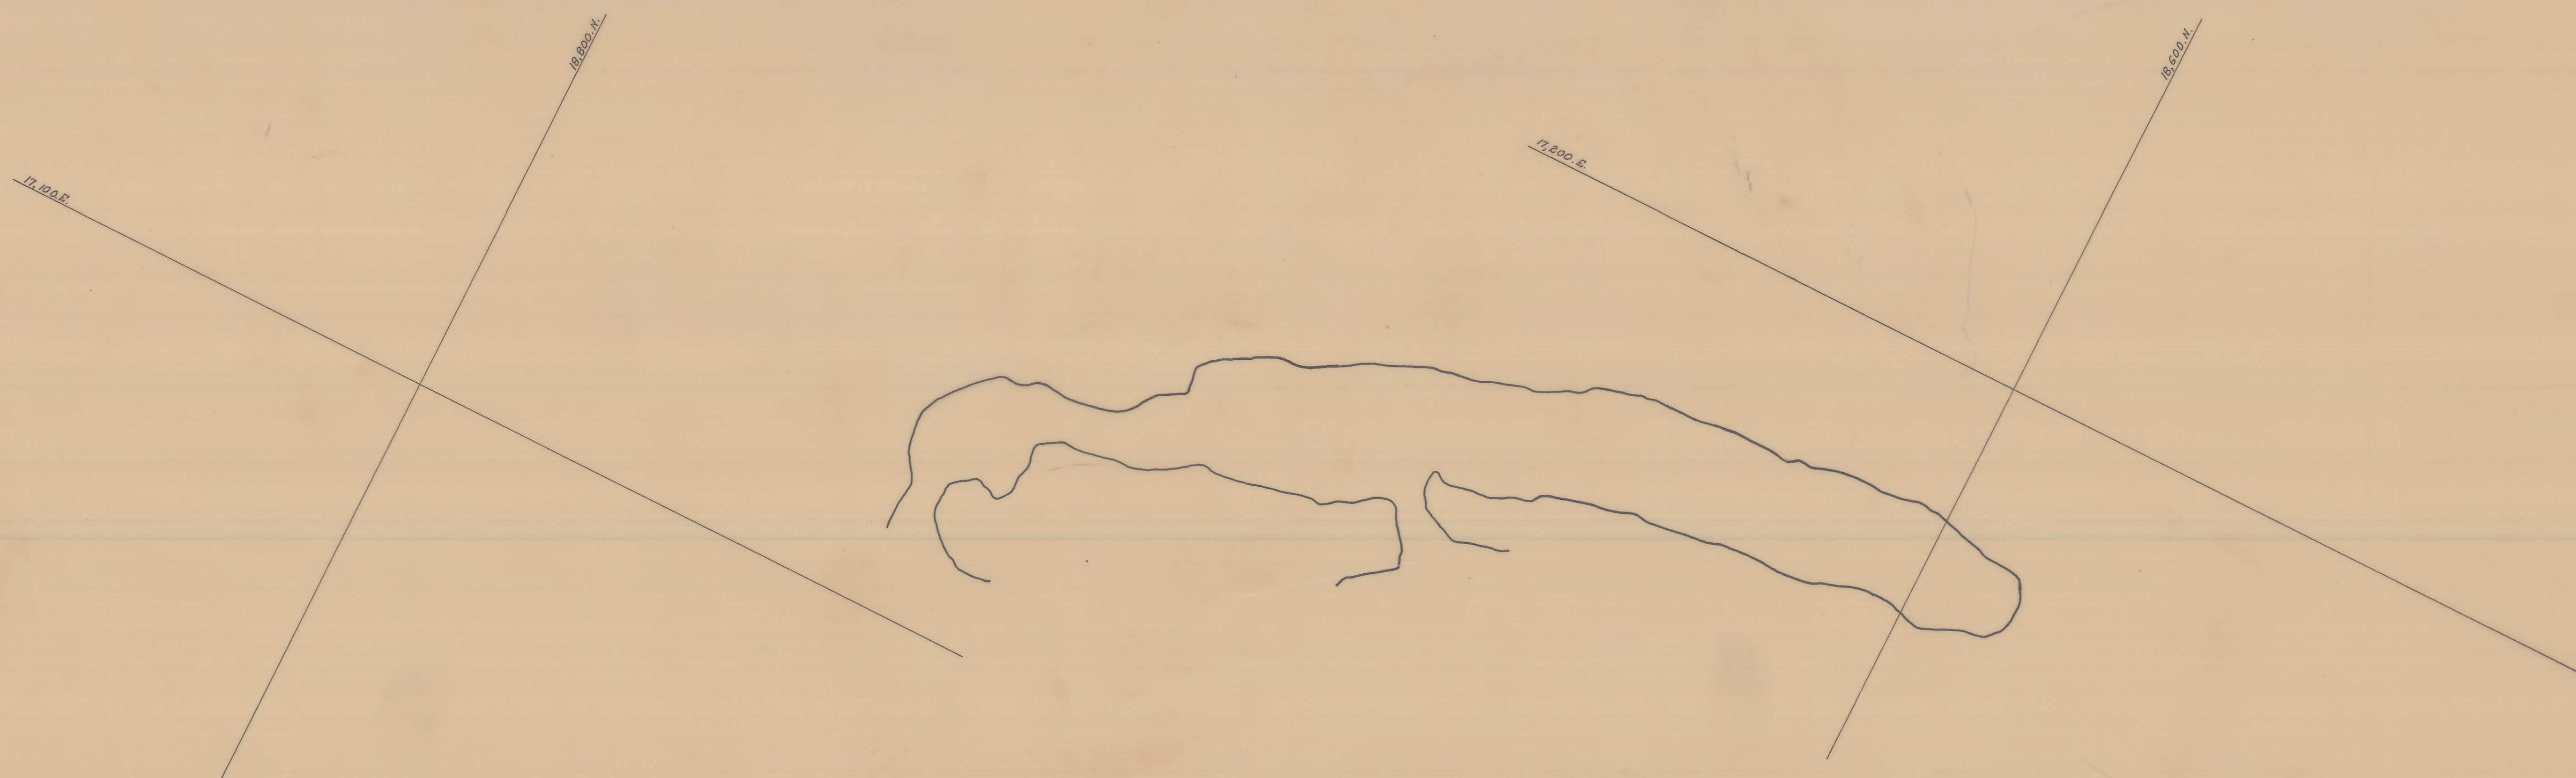

5 cm

DATE	MANAGER	SURVEYOR	RENISON LIMITED SURVEY		DRAWING NO.
2/12/78	<i>[Signature]</i>	<i>[Signature]</i>			12-038
DRAWN: P.W.K.			DATE: 7-3-78	SCALE: 1-500	
FEDERAL STOPE					
LEVEL 2115					

0376-482

75030