


MICROFILMED

6-17-79

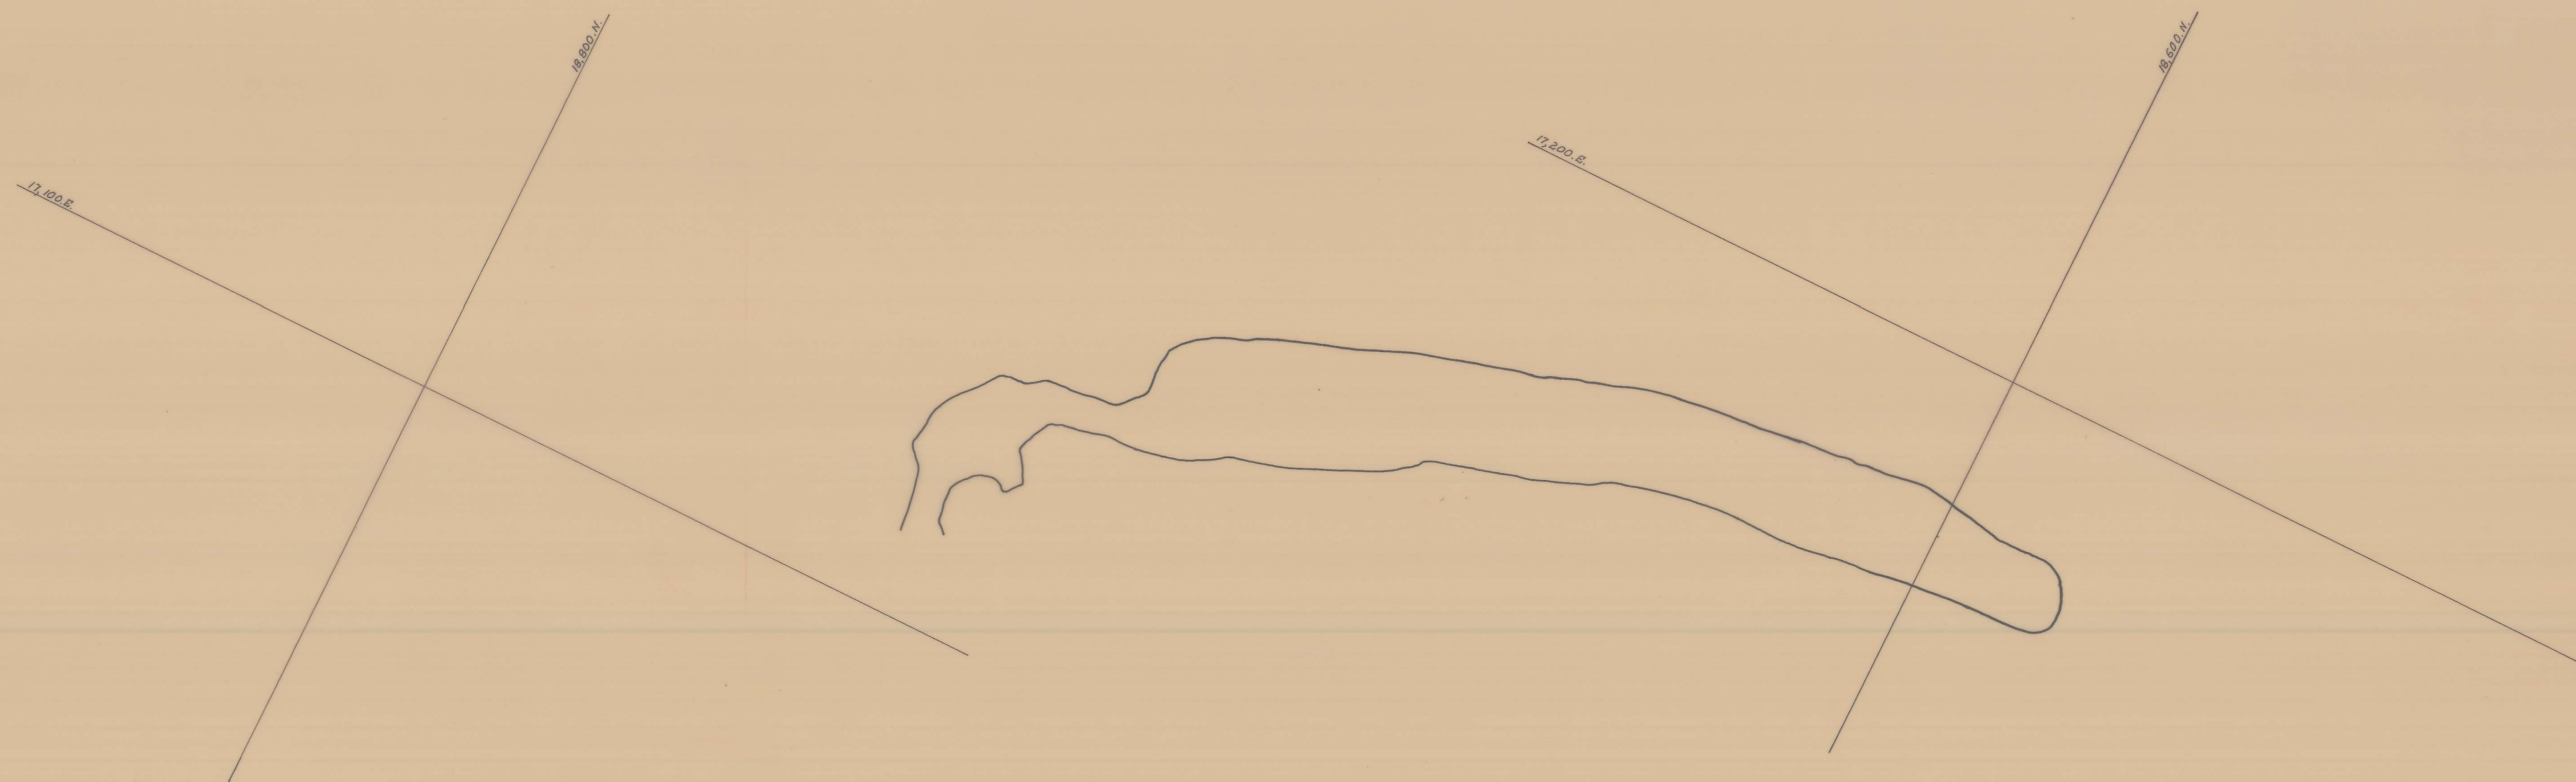

5 cm

DATE	MANAGER	SURVEYOR	RENISON LIMITED SURVEY		DRAWING N°
31-12-72	<i>W. J. J. J.</i>	<i>W. J. J. J.</i>	DRAWN: P.W.K.	DATE: 7-3-78	SCALE: 1:500
			FEDERAL STONE LEVEL 2110		12:038