
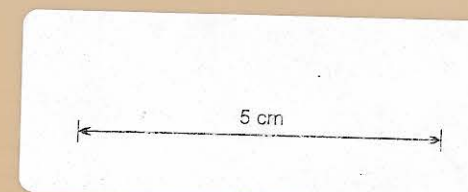


MICROFILMED

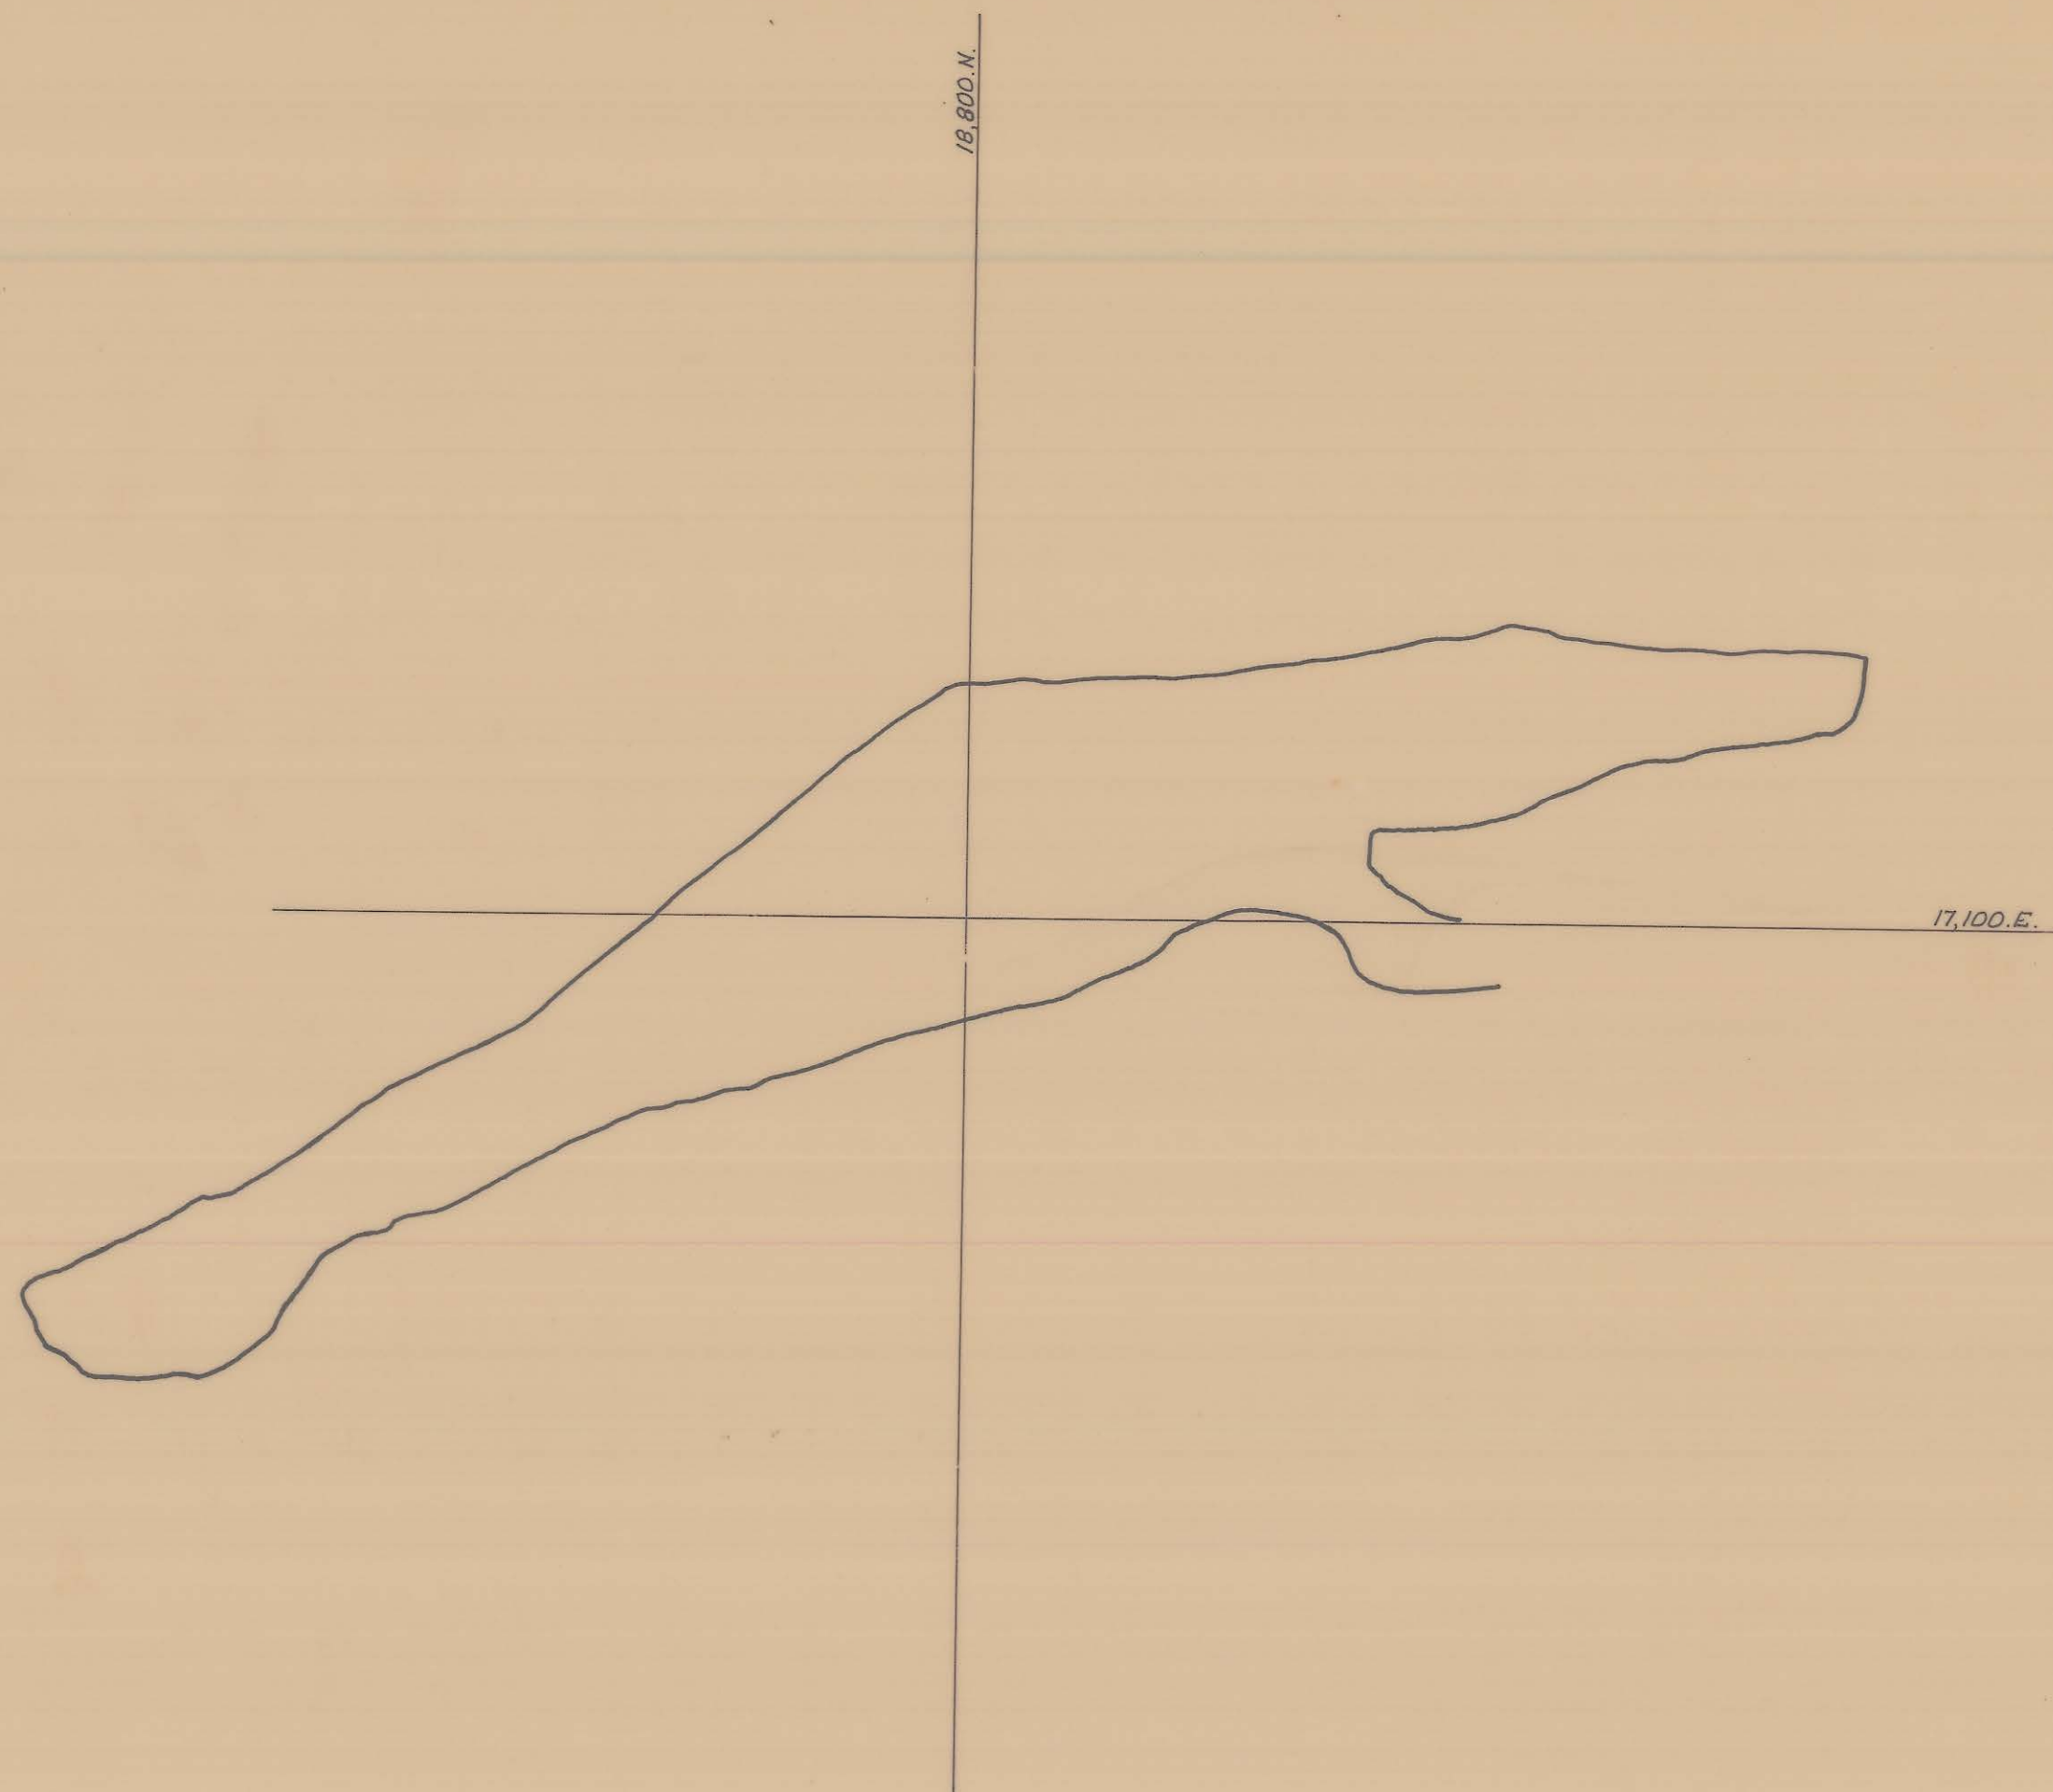

DATE	MANAGER	SURVEYOR	RENISON LIMITED SURVEY			DRAWING N°
31-12-72	<i>Michaelson</i>	<i>W. Kemp</i>	DRAWN: P.W.K.	DATE: 7-3-73	SCALE: 1:500	12:038
			NORTH FEDERAL STOPE LEVEL 2104			

73025

0376_484