


MICROFILMED

MICROFILMED

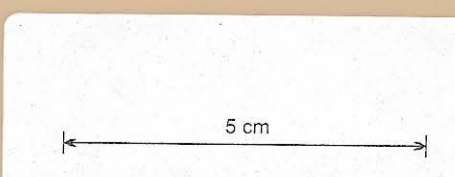

DATE	MANAGER	SURVEYOR	RENISON LIMITED SURVEY			DRAWING NO.
21-12-72	<i>[Signature]</i>	<i>[Signature]</i>	DRAWN: P.W.K.	DATE: 7-3-72	SCALE: 1:500	12:038
			FEDERAL STOPE LEVEL 2100			

0376_485

7327