


MICROFILMED

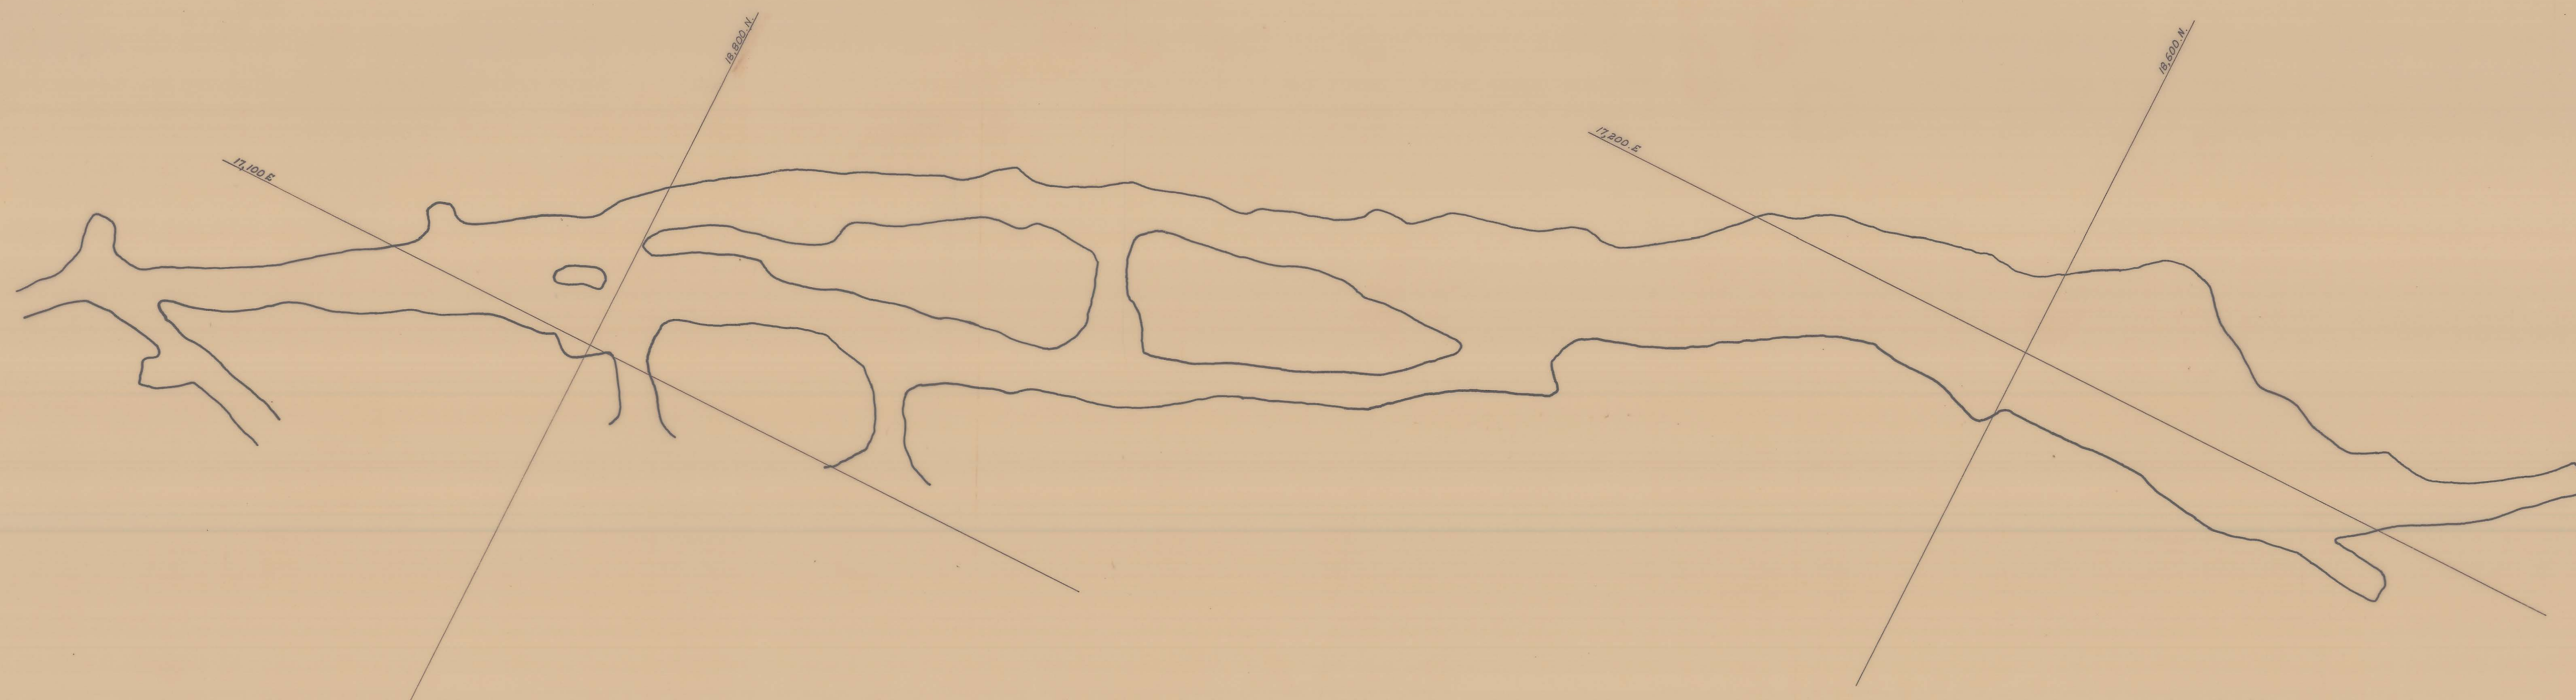

5 cm

DATE	MANAGER	SURVEYOR	REINSON LIMITED		DRAWING NO.
3/12/73	M. J. [Signature]	[Signature]	SURVEY		
			DRAWN: P.W.K.	DATE: 7-3-73	SCALE: 1:500
			FEDERAL STOPE		
			LEVEL 2080		

12-038

73025

0376_487