


MACROFILMED

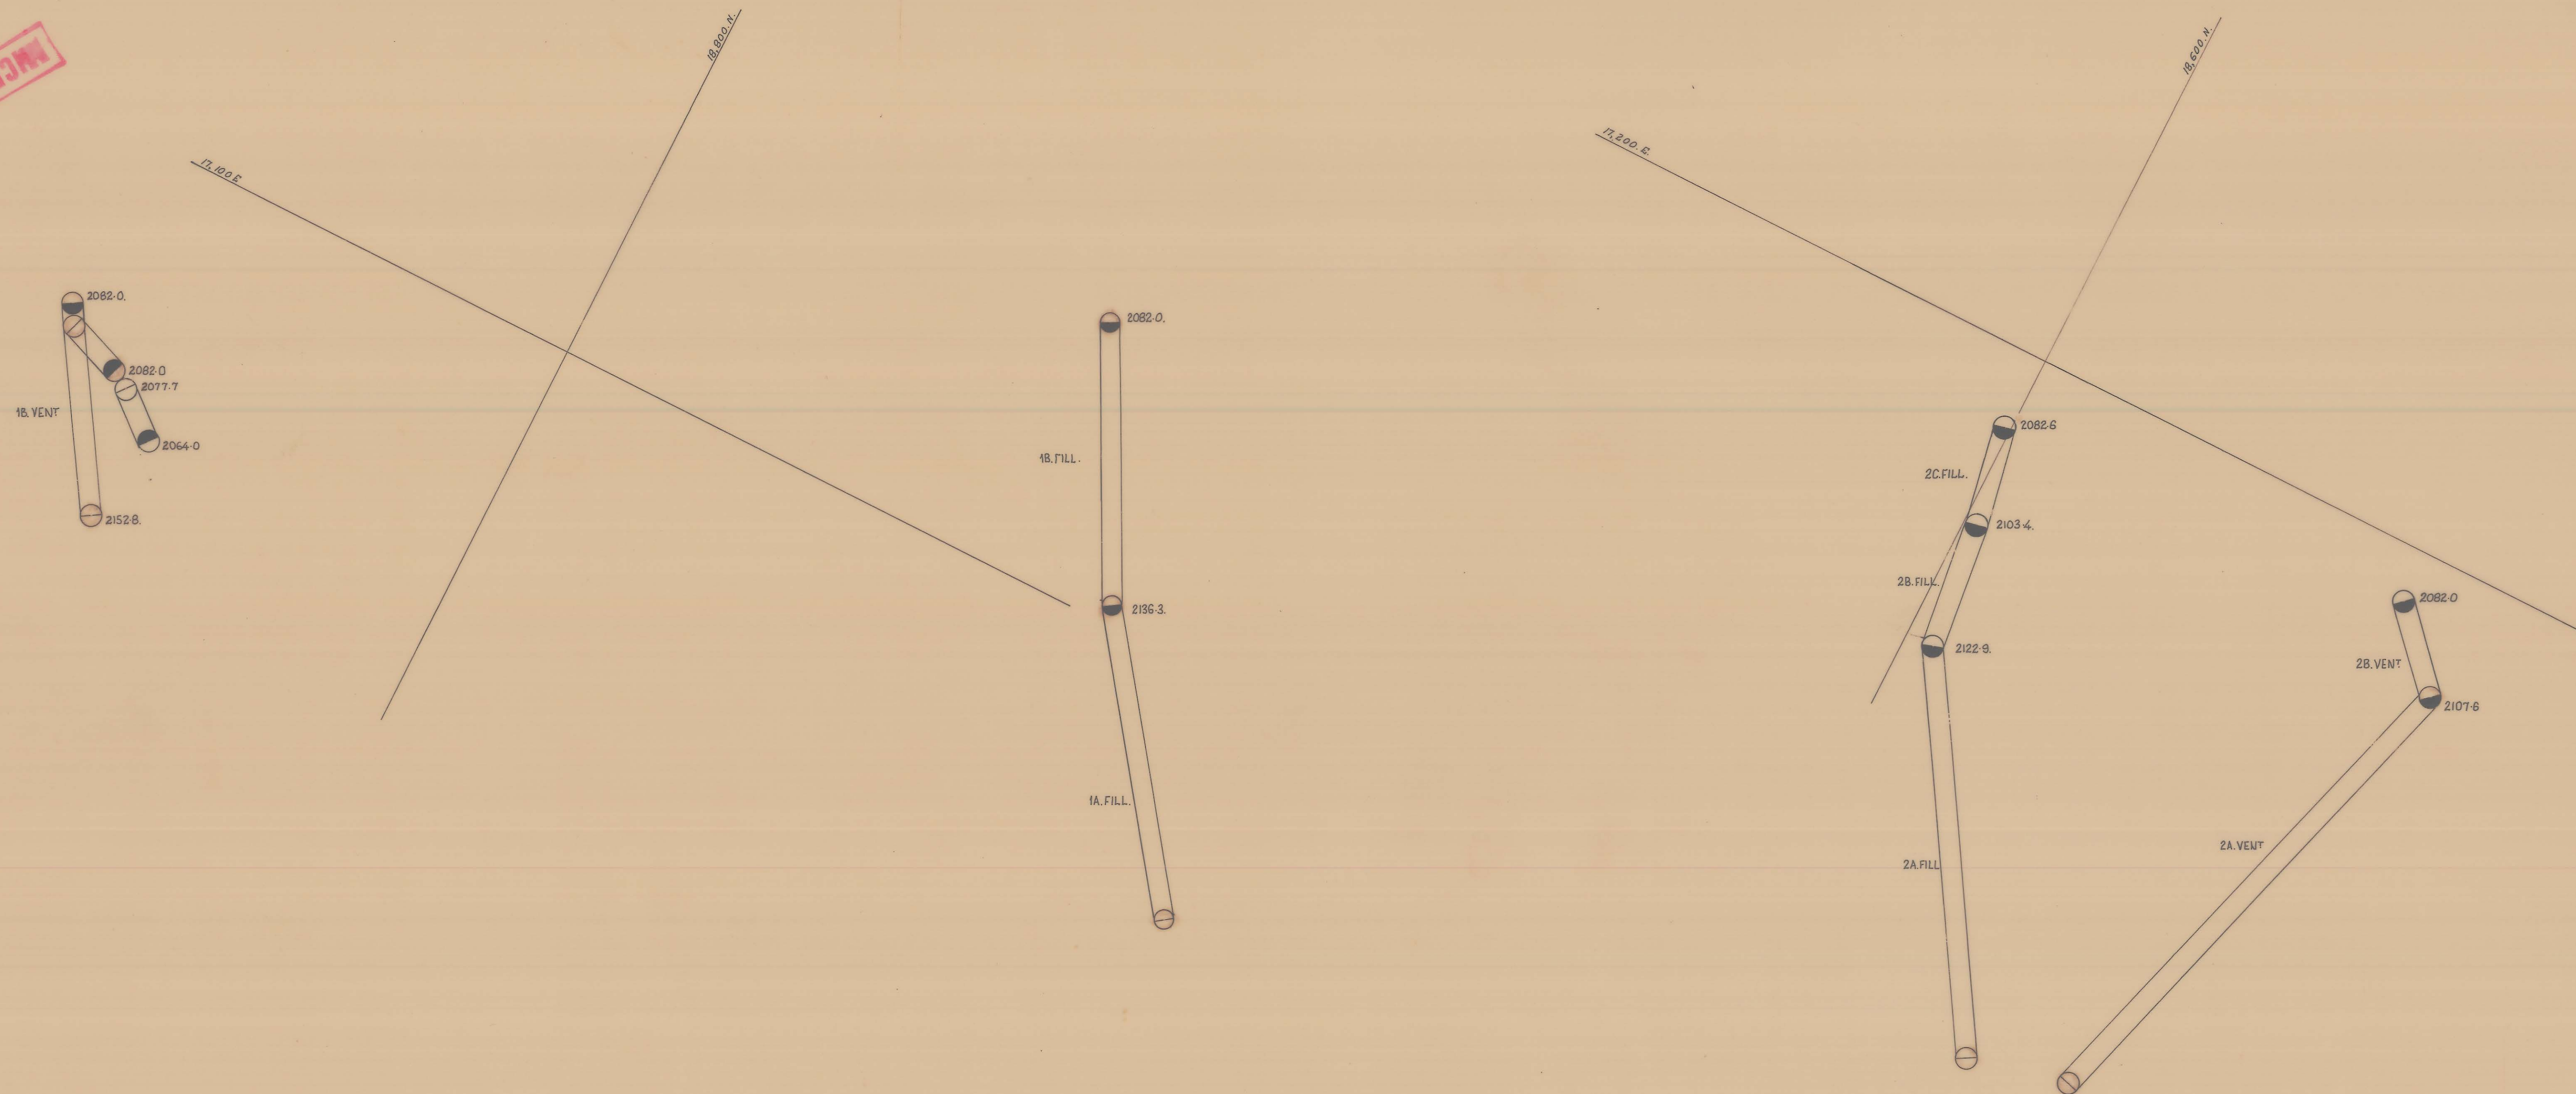

DATE	MANAGER	SURVEYOR	REINSON LIMITED SURVEY			DRAWING N°
31/12/72	<i>[Signature]</i>	<i>[Signature]</i>	DRAWN: P.W.K.	DATE: 7-3-73	SCALE: 1:500	12-038
			FEDERAL STOPE COMPOSITE RISES			